


RECEIVED

AUG 12 1981


WATER RESOURCES DEPT
SALEM, OREGON

Application No. R-62219
Permit No. R10083

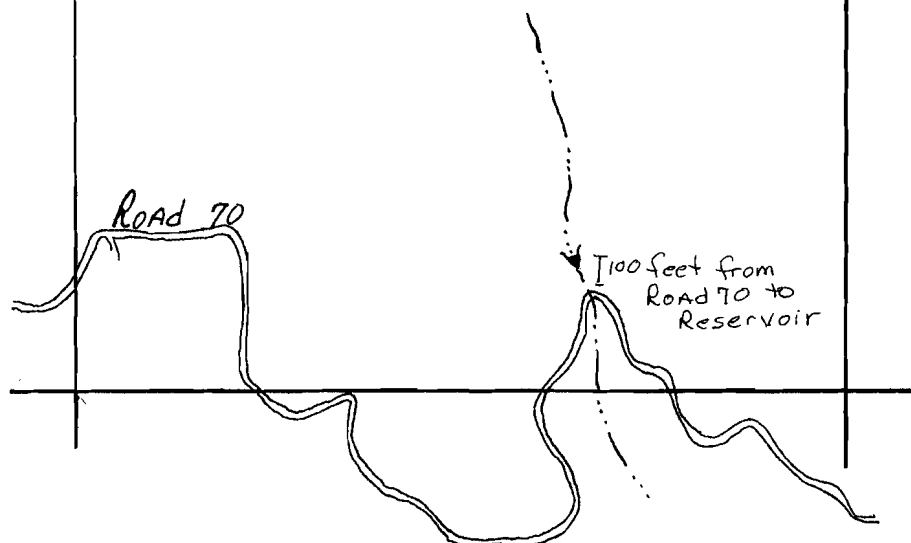

SW $\frac{1}{4}$ SE $\frac{1}{4}$ Sec. 11, T.7S., R42E.

Reservoir 

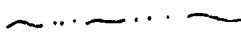Drainage 

Road 

Four Inches = One Mile

