


N ↑

Application No. R-64276
Permit No. R10086

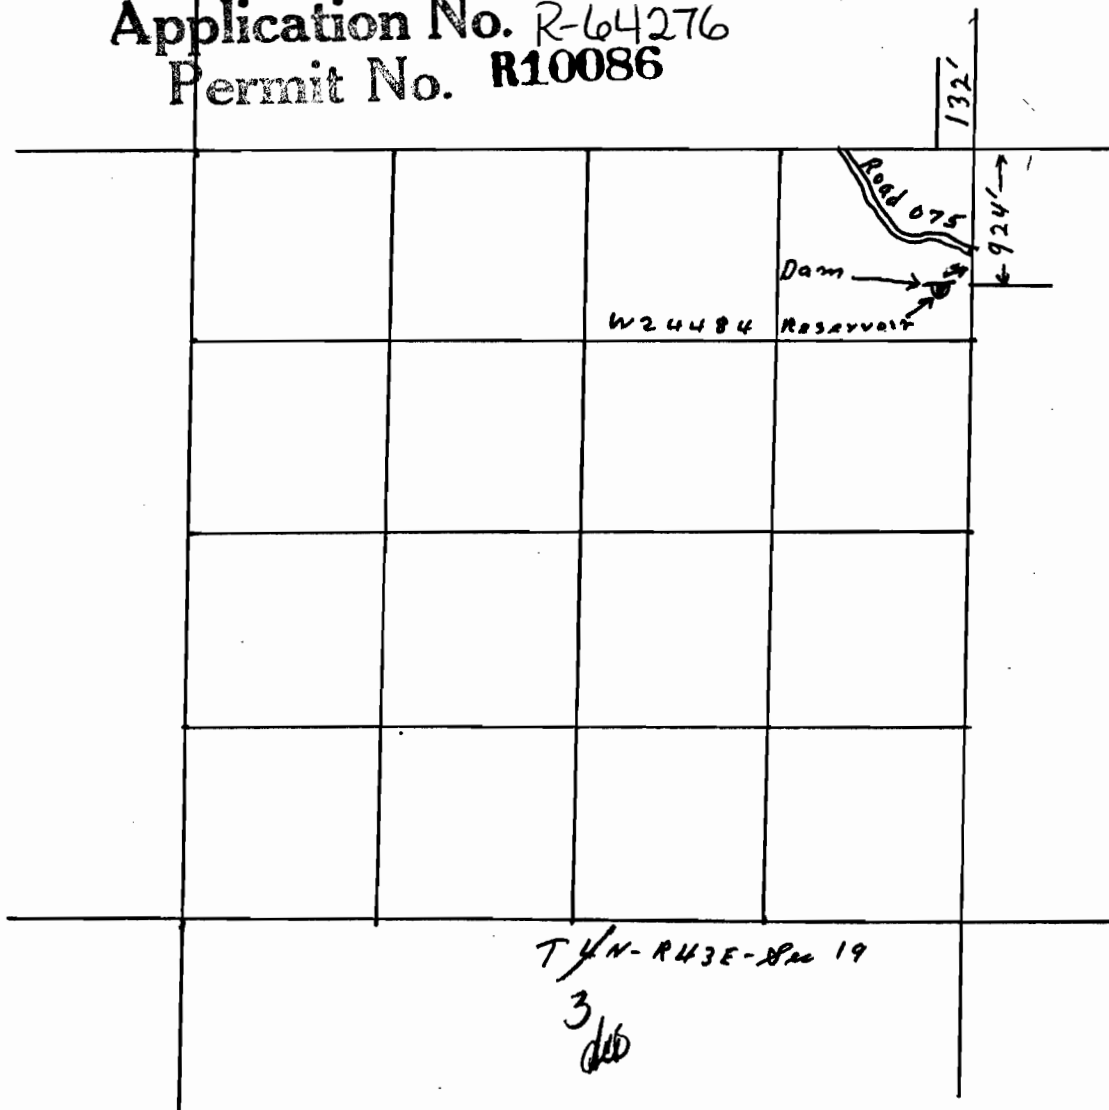

RECEIVED

SEP 30 1982

WATER RESOURCES DIV.
SALEM, OREGON

4 inches = 1 mile