


Application No. R-64278
Permit No. R10088

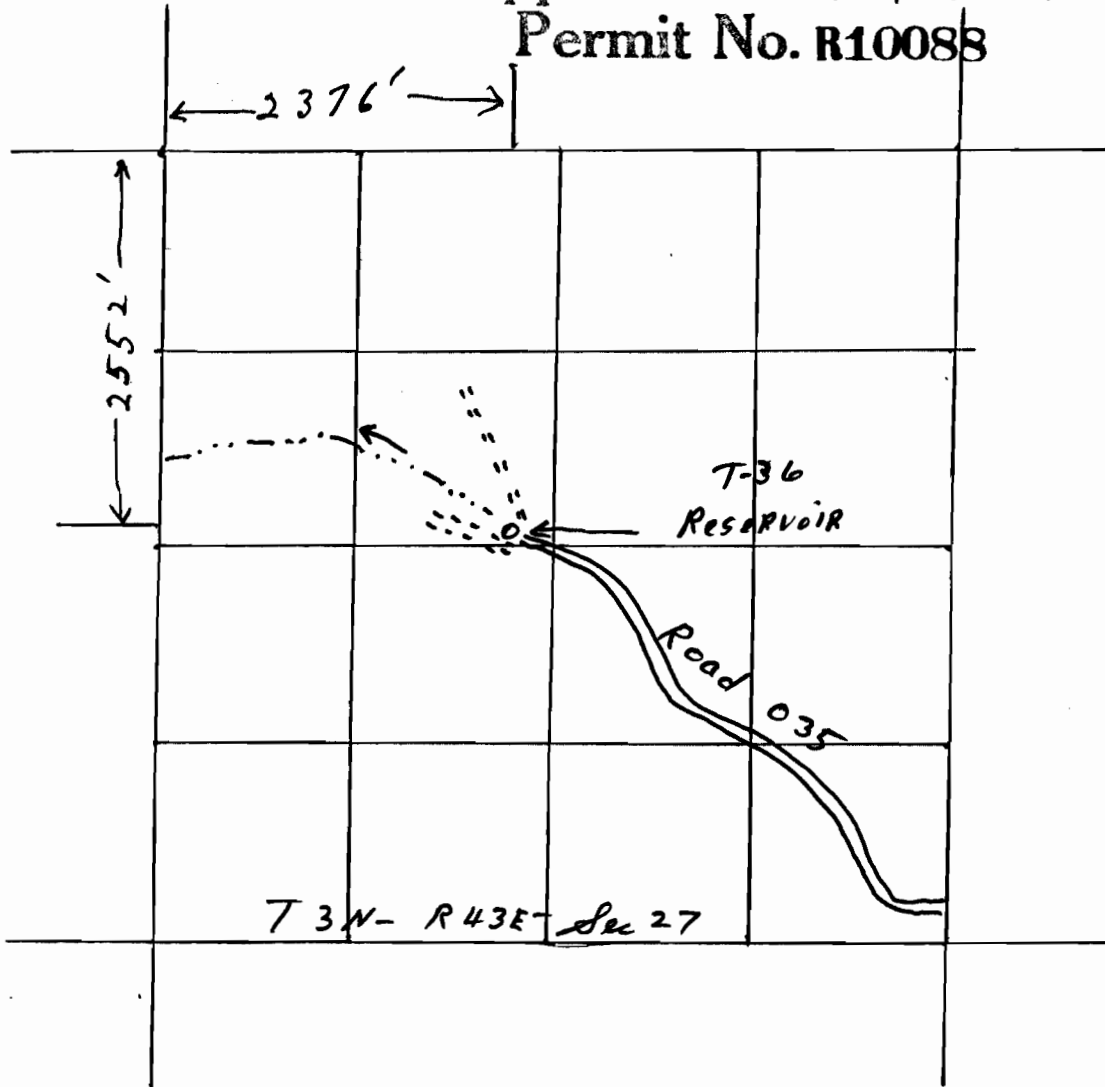

4 inches = 1 mile

RECEIVED
SEP 30 1982
WATER RESOURCES DEPT.
SALEM, OREGON