


Application No. R-64281

Permit No. R10091

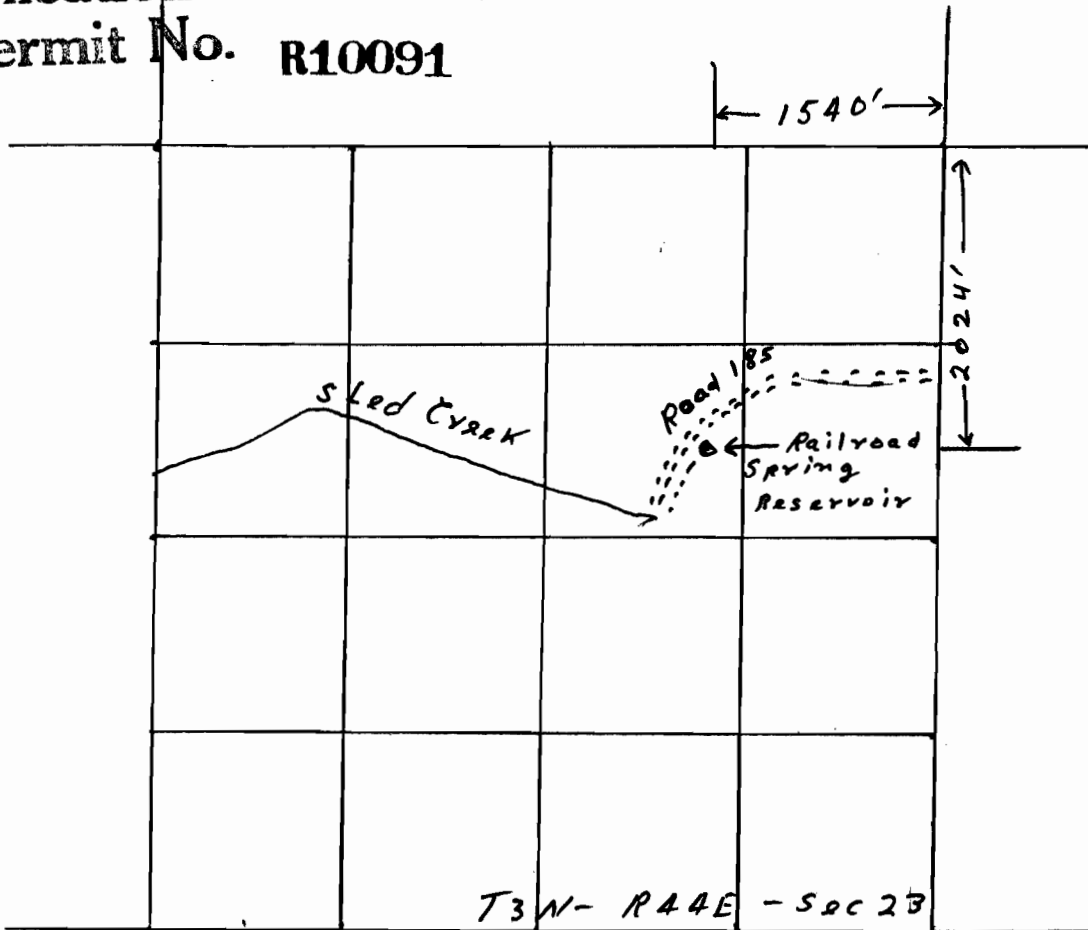

RECEIVED

AUG 12 1983

WATER RESOURCES DEPT.
SALEM, OREGON

RECEIVED

JUL 18 1983

WATER RESOURCES DEPT.
SALEM, OREGON

RECEIVED

SEP 30 1982

WATER RESOURCES DEPT.
SALEM, OREGON

4 inches = 1 mile