


11 4

Application No. R-64284
Permit No. R10094

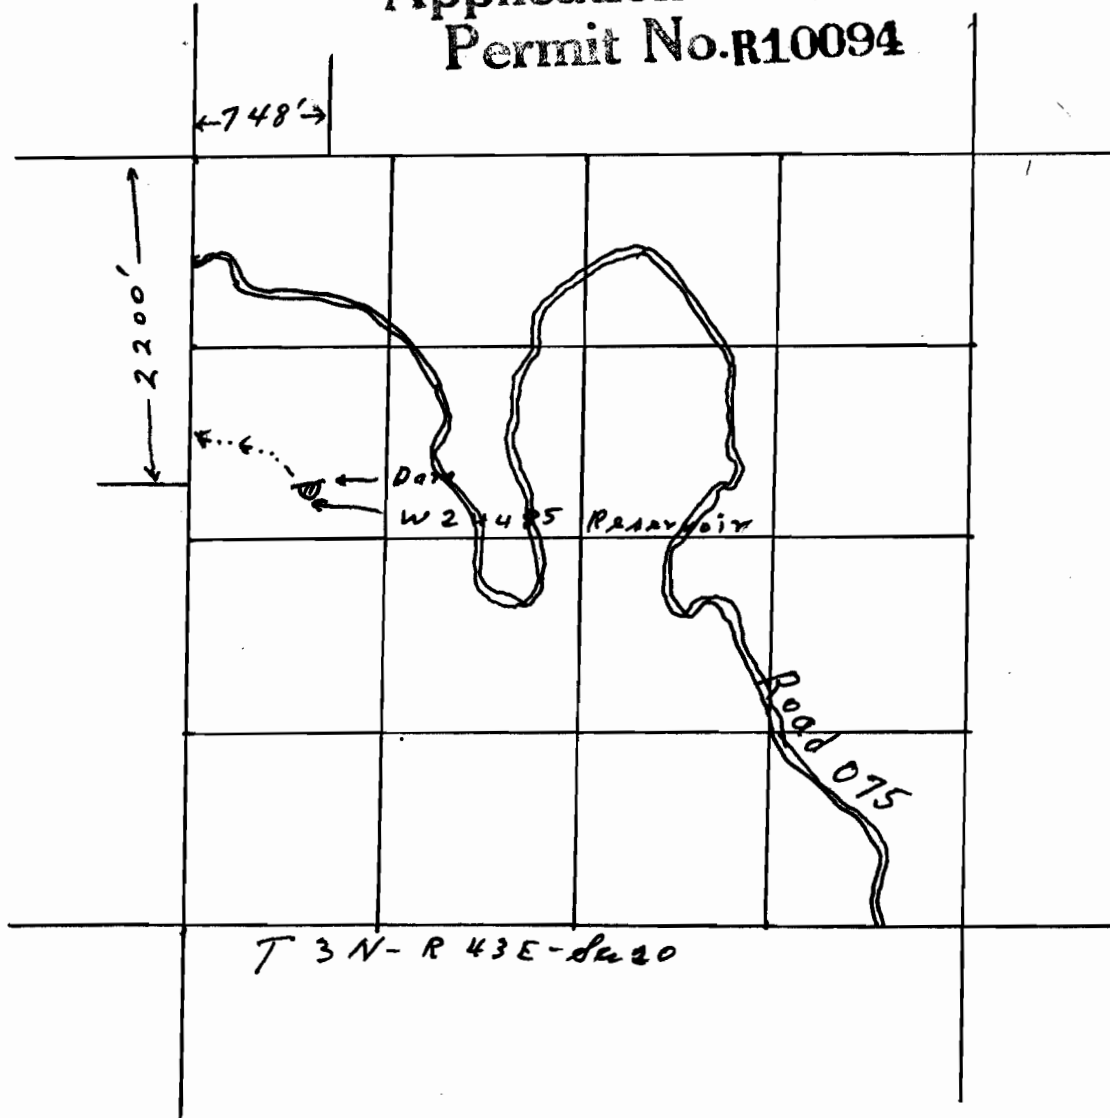

RECEIVED

SEP 30 1982

WATER RESOURCES DEPT.
SALEM, OREGON

4 inches = 1 mile