


11 4

Application No. R-64285
Permit No. R10095

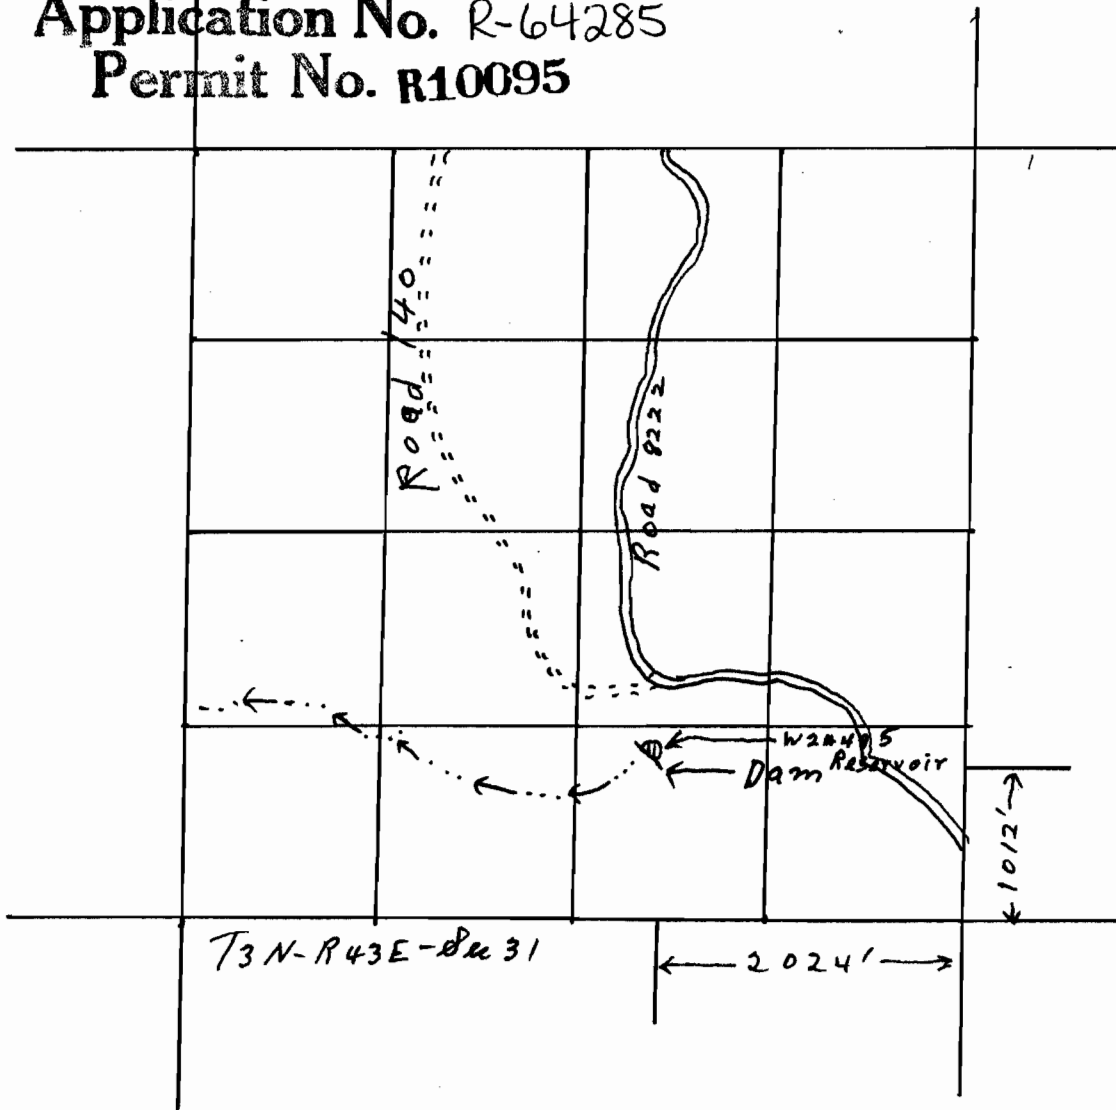

RECEIVED

SEP 30 1982

WATER RESOURCES DIV.
SALEM, OREGON

4 inches = 1 mile