


4
N

Application No. R-64286
Permit No. R10096

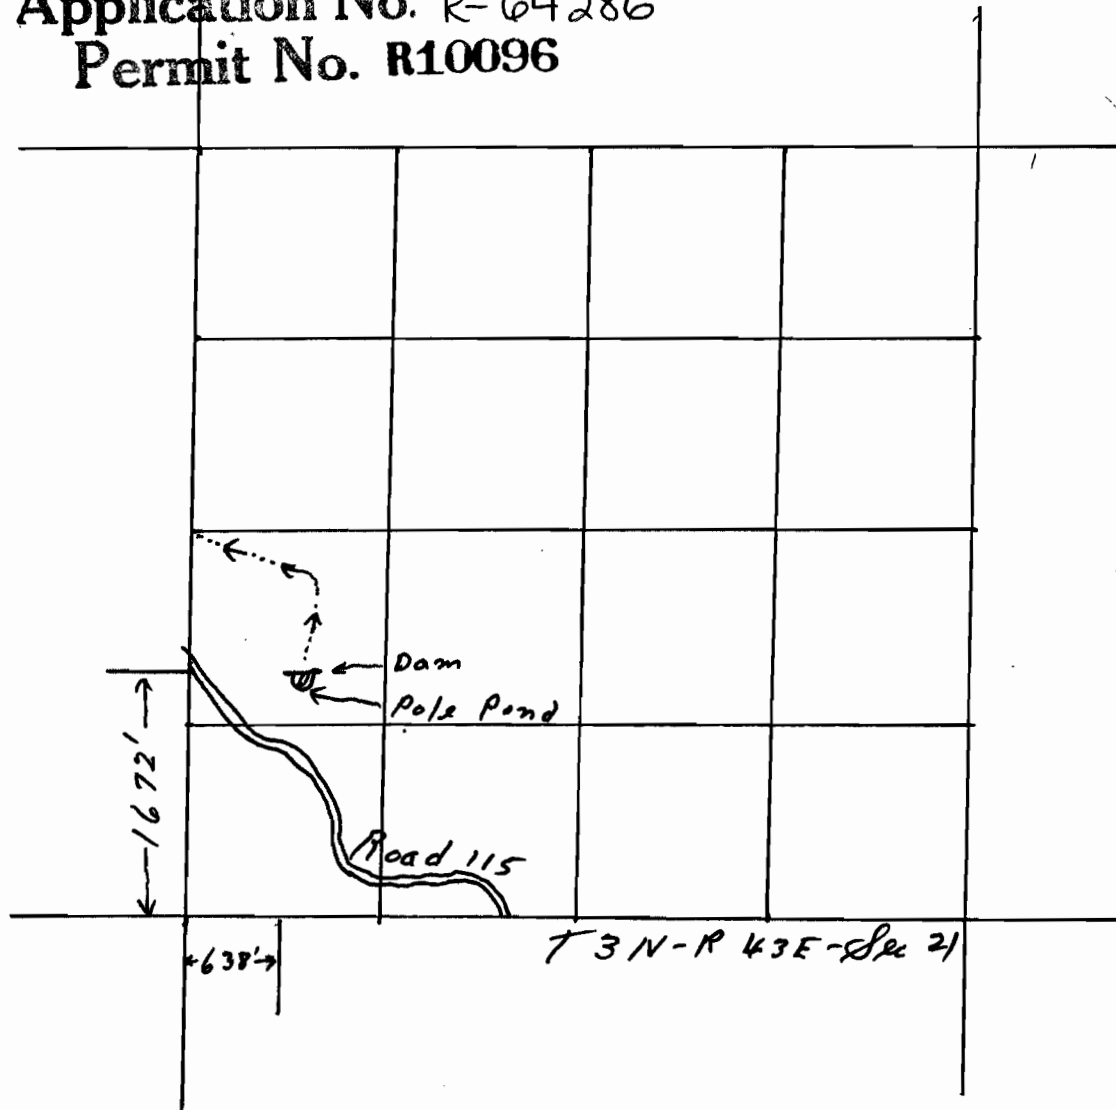

RECEIVED

SEP 30 1982

WATER RESOURCES DIV.
SALEM, OREGON

4 inches = 1 mile