


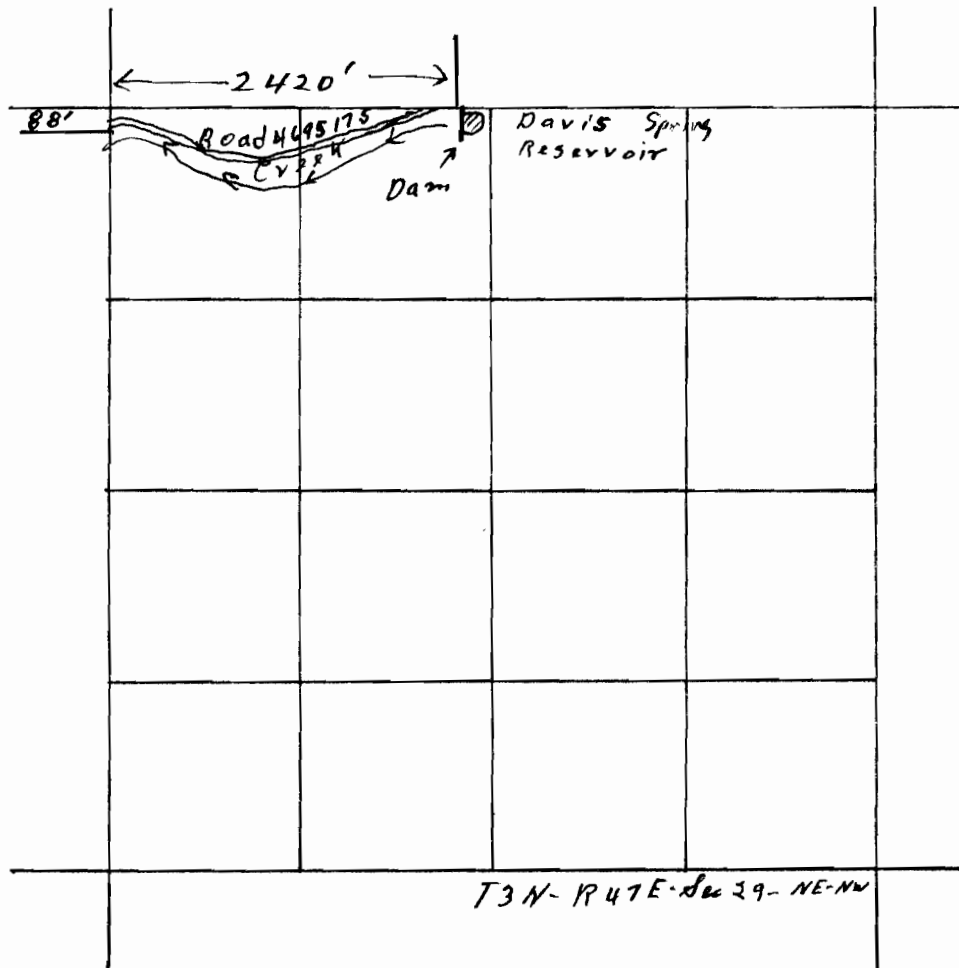

4 inches = 1 mile

Application No. R-65787
Permit No. R10767

RECEIVED
JAN 29 1980
LAND RESOURCES DEPT
SALEM, OREGON