




Application No. R-65803

Permit No. R10783

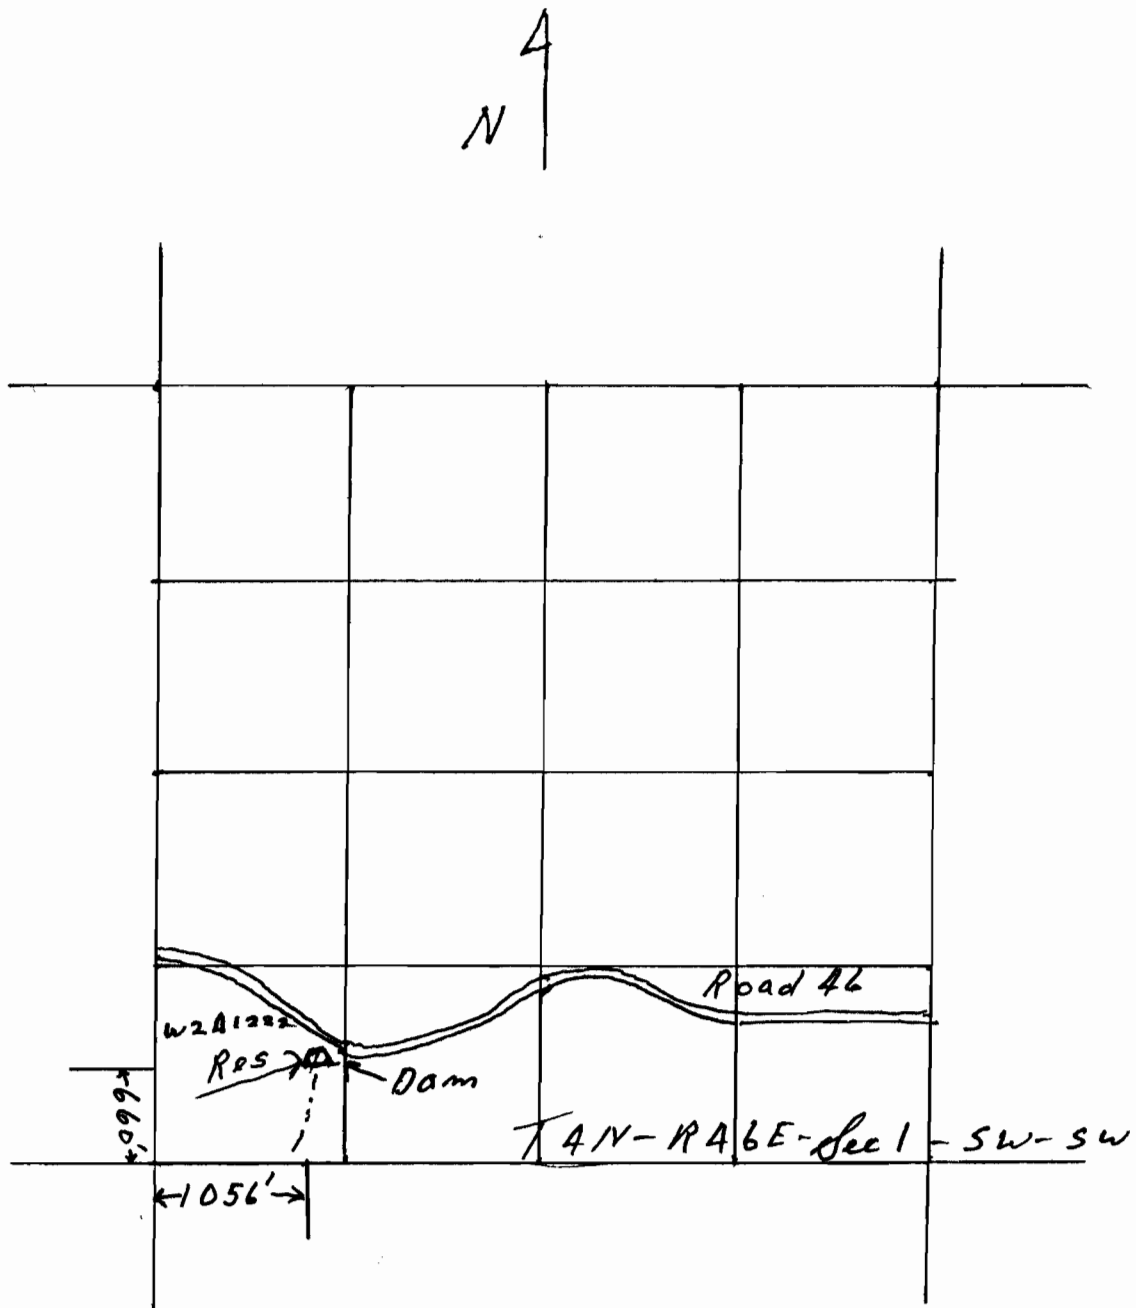

4 inches = 1 mile

RECEIVED
 JUN 28 1983
 FOREST DIVISION DEPT
 SALEM, OREGON