


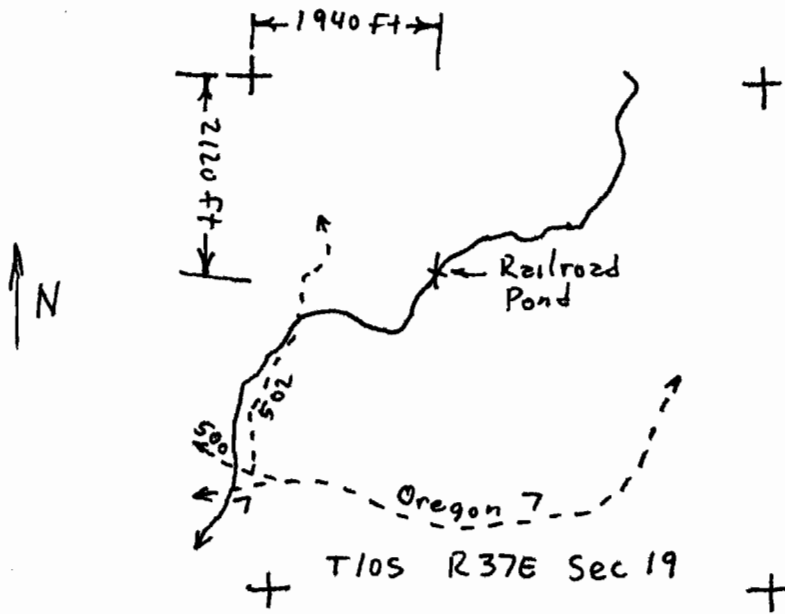

2.64 inches = 1 mile

RECEIVED

SEP 22 1983

WATER RESOURCES DEPT.
SALEM, OREGON

Application No. R66614
Permit No. R10789