



Application No. R66615

Permit No. R10790

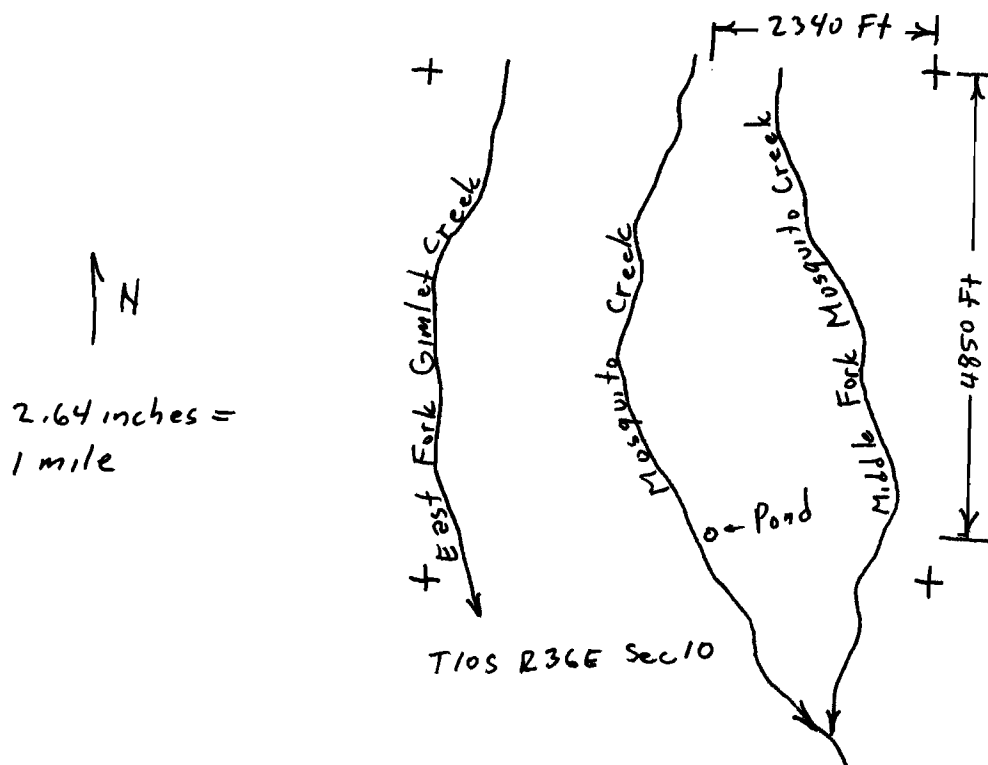

blowup not to scale

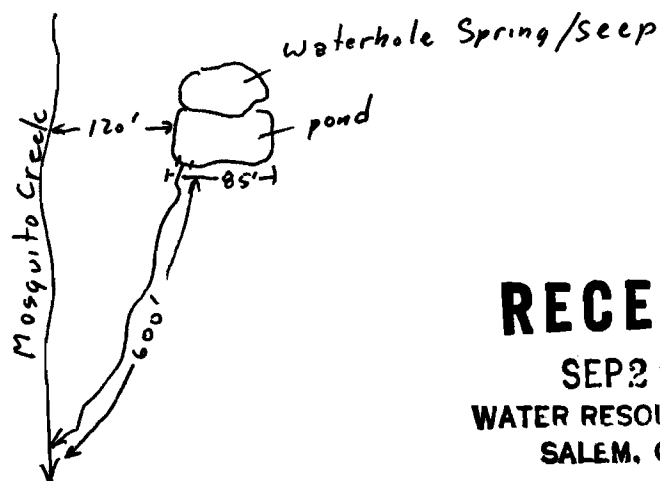

RECEIVED

SEP 22 1983

WATER RESOURCES DEPT.
SALEM, OREGON