


Tamarack Flat Pond

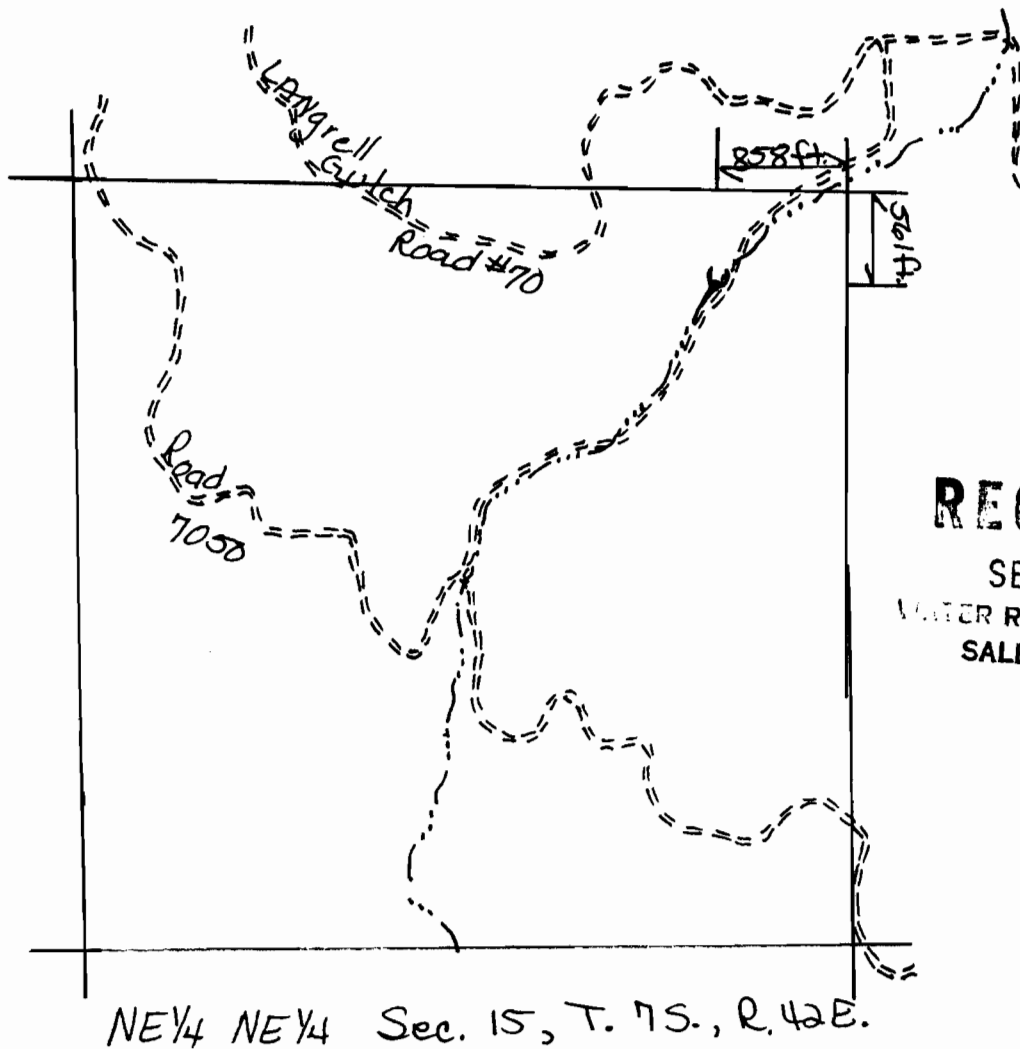

RECEIVED

SEP 6 1983
WATER RESOURCES DEPT.
SALEM, OREGON

Scale:

4 inches = 1 mile



Application No.
Permit No.

Application No. R65940
Permit No. R-10934