


RECEIVED

SEP 3 1983

WATER RESOURCES DEPT.
SALEM, OREGON

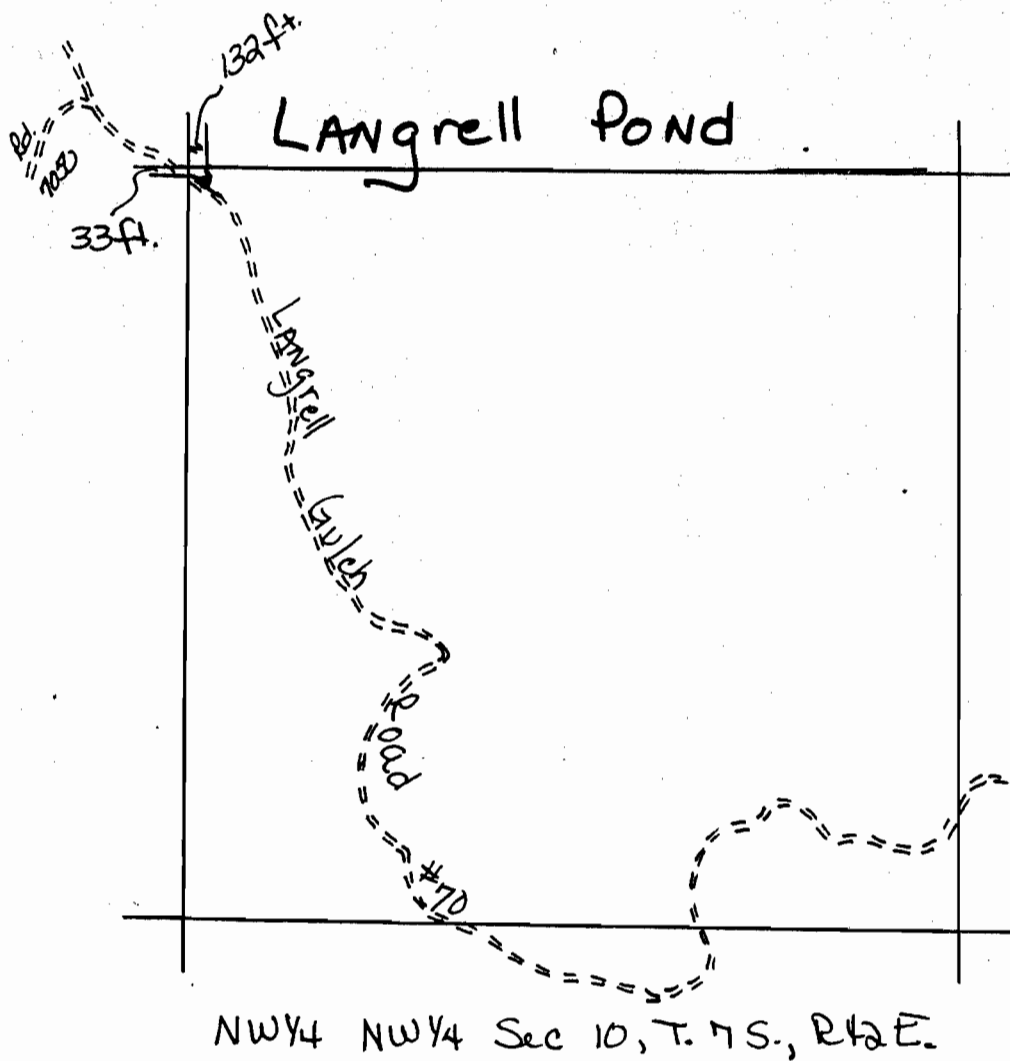

Application No. R-65941
Permit No. R-10935

Scale:
4 inches = 1 mile

