



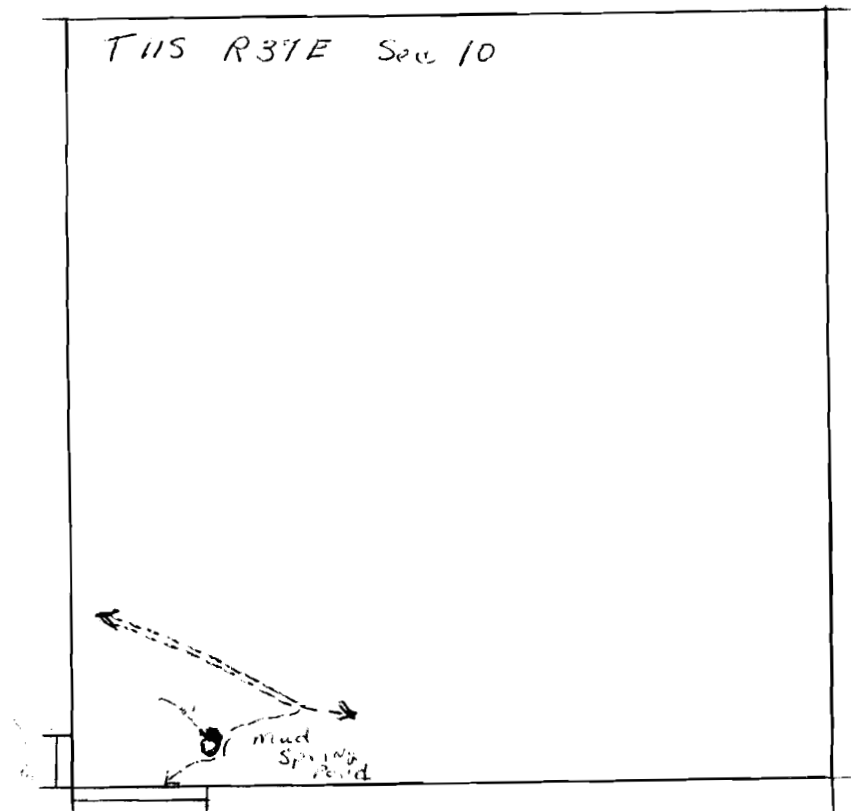

4" = 1 mile

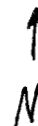

Application No. R-65893
Permit No. R11015

RECEIVED

SEP 6 1982
WATER RESOURCES DEPT.
SALEM, OREGON