


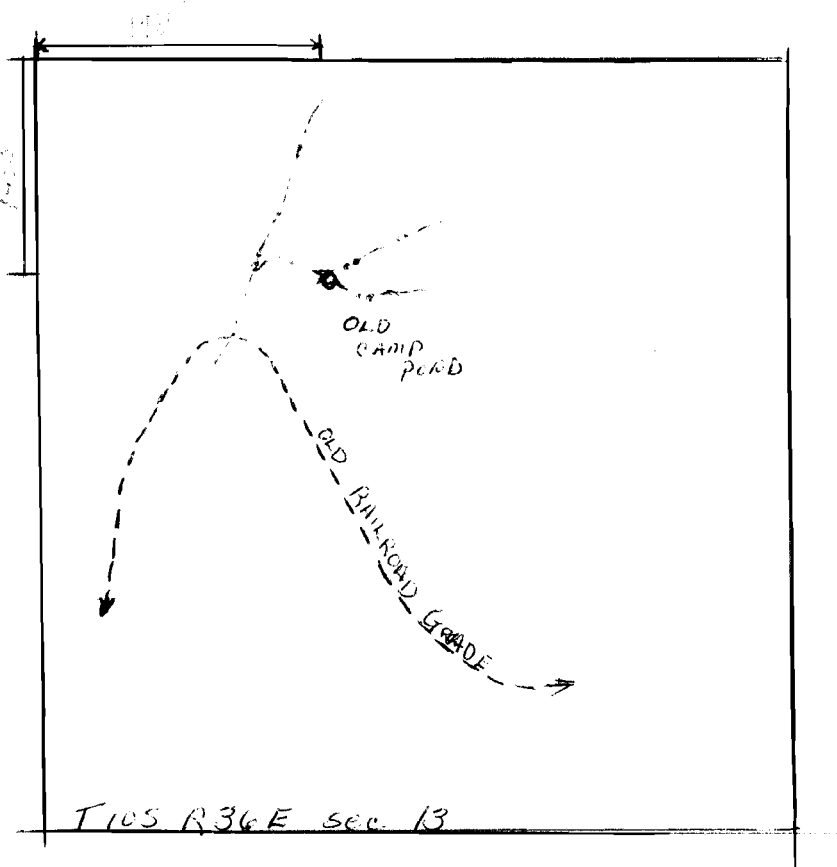

4" = 1 mile



RECEIVED

SEP 15 1982
WATER RESOURCES DEPT.
SALEM, OREGON

Application No. R-65895
Permit No. R11017