



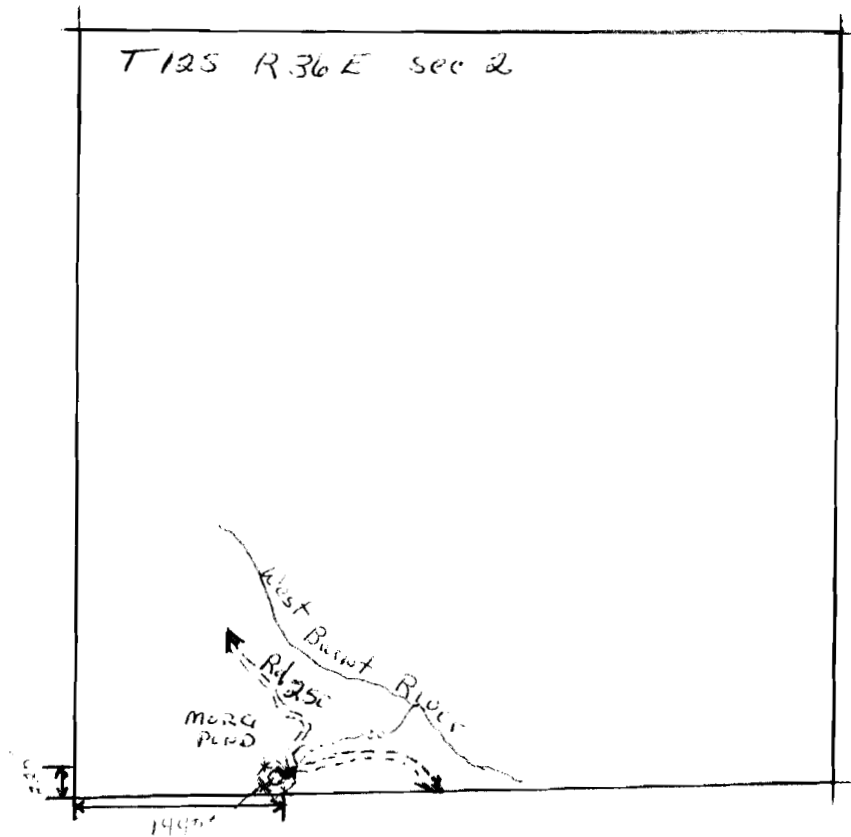

1/4" = 1 mile

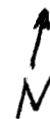

**RECEIVED**

SEP 1982

WATER RESOURCES DEPT.  
SALEM, OREGON

**Application No. R-65897**  
**Permit No. R11018**