


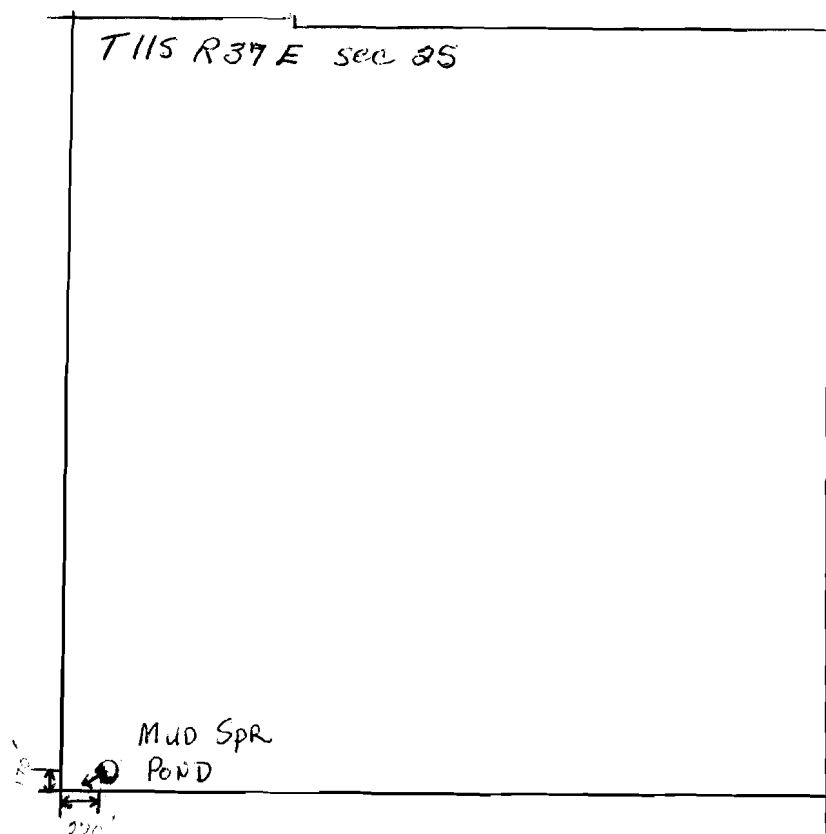

4" = 1 mile



RECEIVED

SEP 9 1982

WATER RESOURCES DEPT.
SALEM, OREGON

Application No. R-65899
Permit No. R11019