
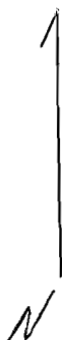


RECEIVED

5278 1983
WATER RESOURCES DEPT.
SALEM, OREGON

Application No. R-65902
Permit No. R-11037

IRIS POND

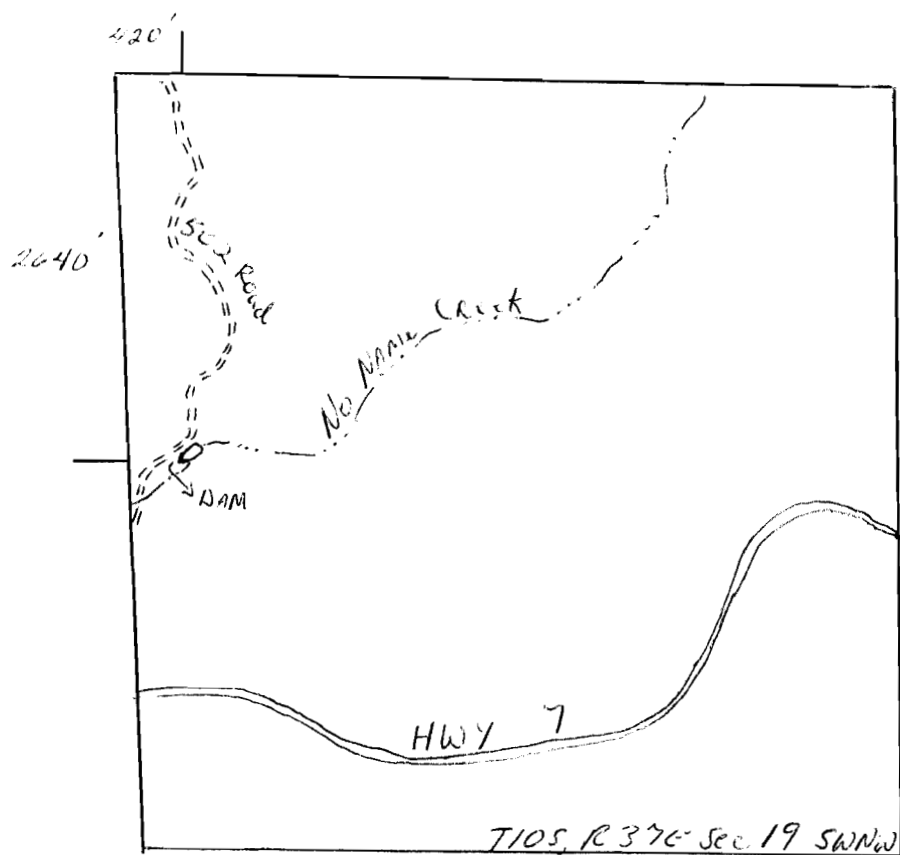

4" = 1 mile