


↑ N
4 inches =
1 mile

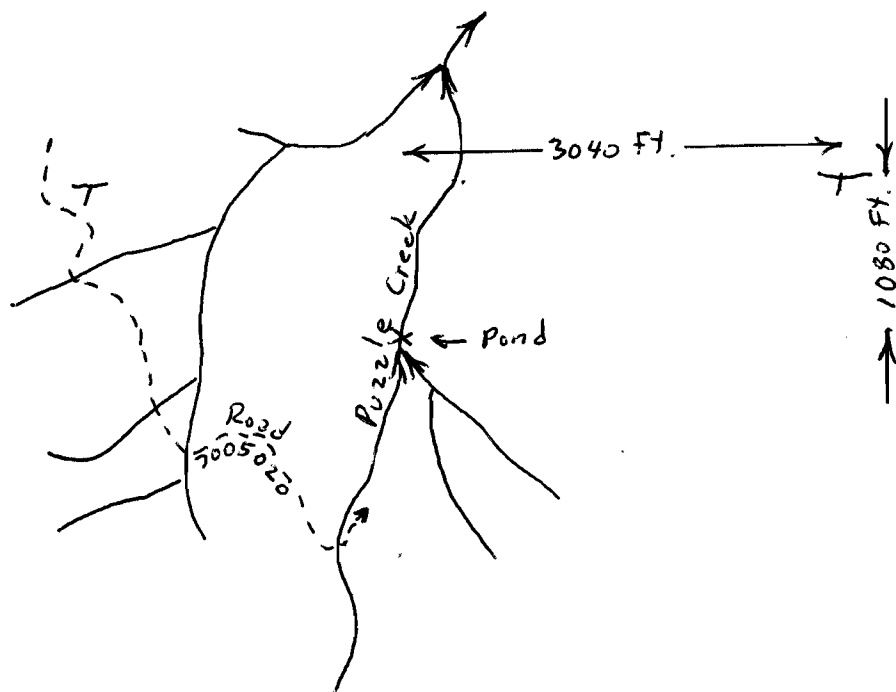

+ T 8S, R 44E, Sec 4 +

RECEIVED
SEP 26 1983
WATER RESOURCES DEPT.
SALEM, OREGON

Application No. R-66730
Permit No. R11051