


RECEIVED

SEP 26 1983

WATER RESOURCES DEPT.
SALEM, OREGON

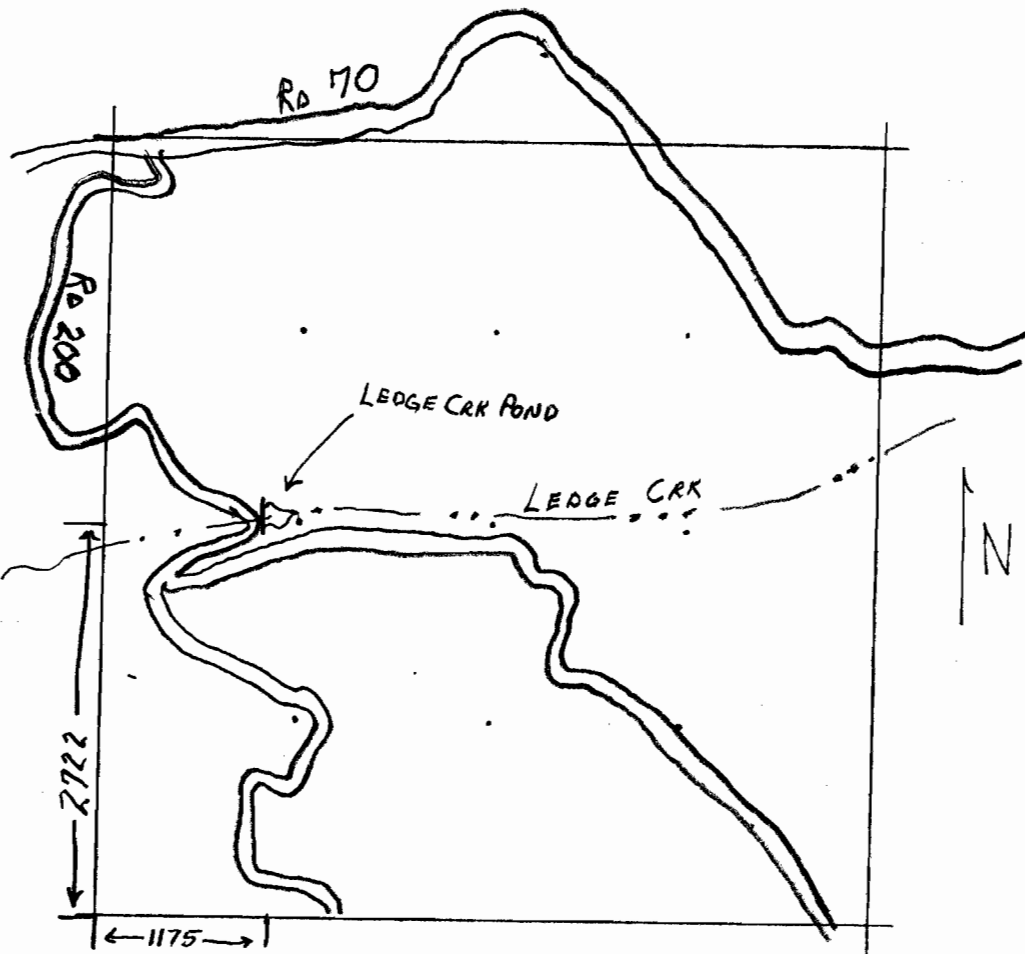

4 inches = 1 mile T7S R43E Sec 24

Application No. R-66733
Permit No. R11053