


RECEIVED

SEP 6 1983

WATER RESOURCES DEPT.
SALEM, OREGON

Application No. R-65943
Permit No. R-11075

Jim Smith Spring

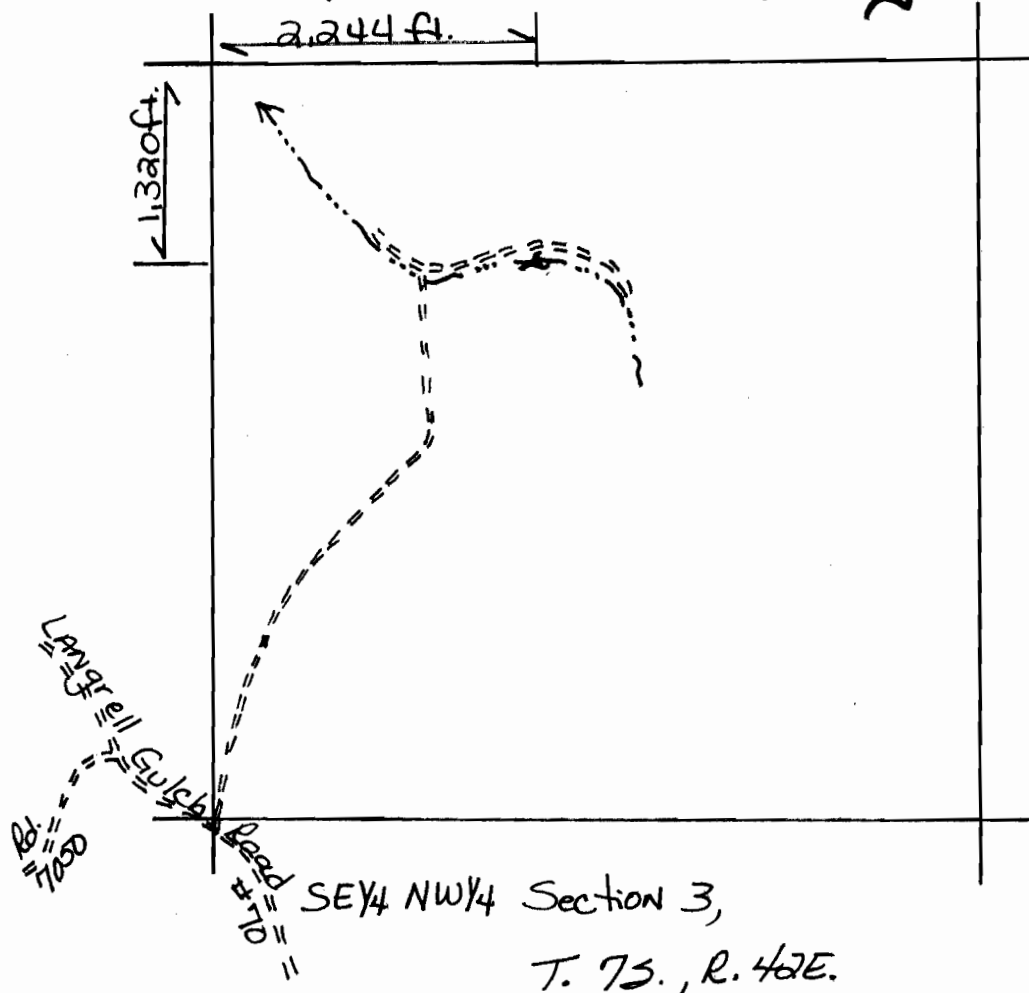

Scale:
4 inches = 1 mile

