


Application No. R-65901
Permit No. R-11499

RECEIVED

3 JUL 1983
WATER RESOURCES DEPT.
SALEM, OREGON

WELL CAMP POND

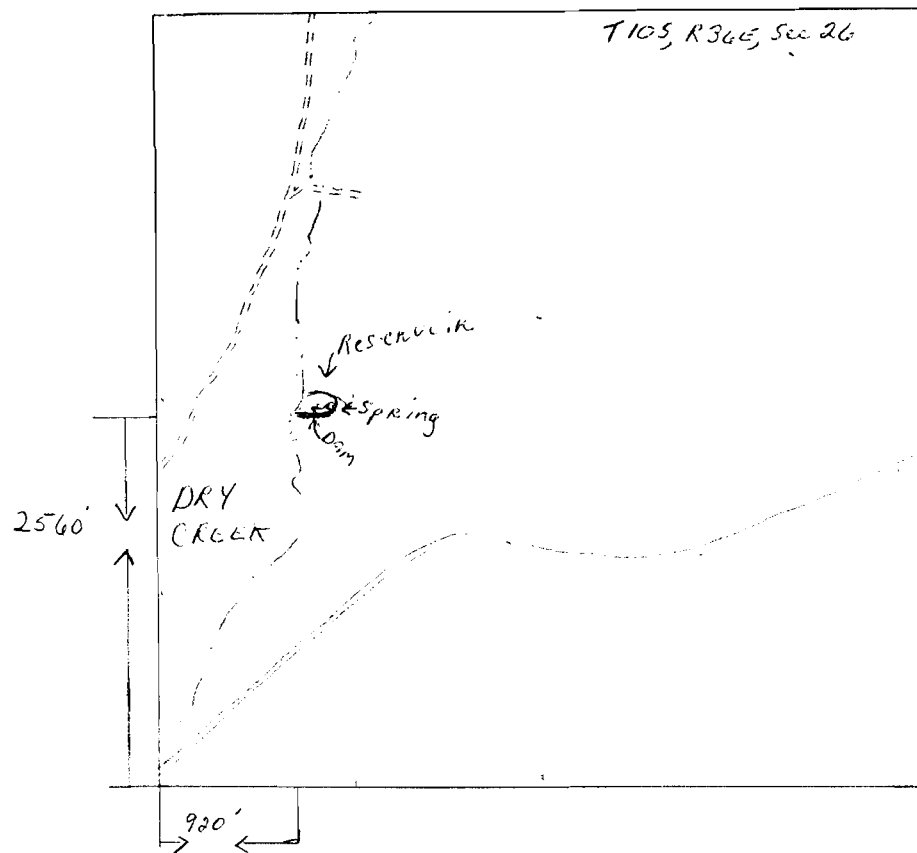

↑ N 4" = 1 mile