


Application No. R-68953
Permit No. R-11500

RECEIVED

SEP 8 1982
WATER RESOURCES DEPT.
SALEM, OREGON

SAWMILL POND

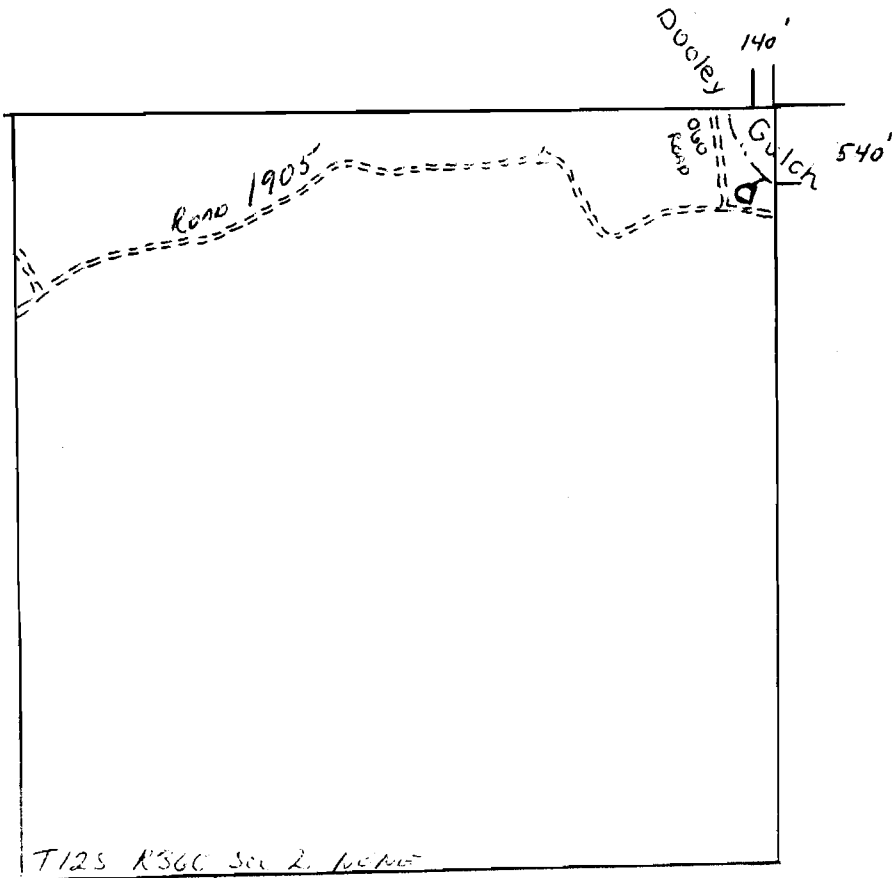

N ↑
4" = 1 mile