


Application No. P-65942
Permit No. R-11501

RECEIVED

SEP 5 1983
WATER RESOURCES DEPT.
SALEM, OREGON

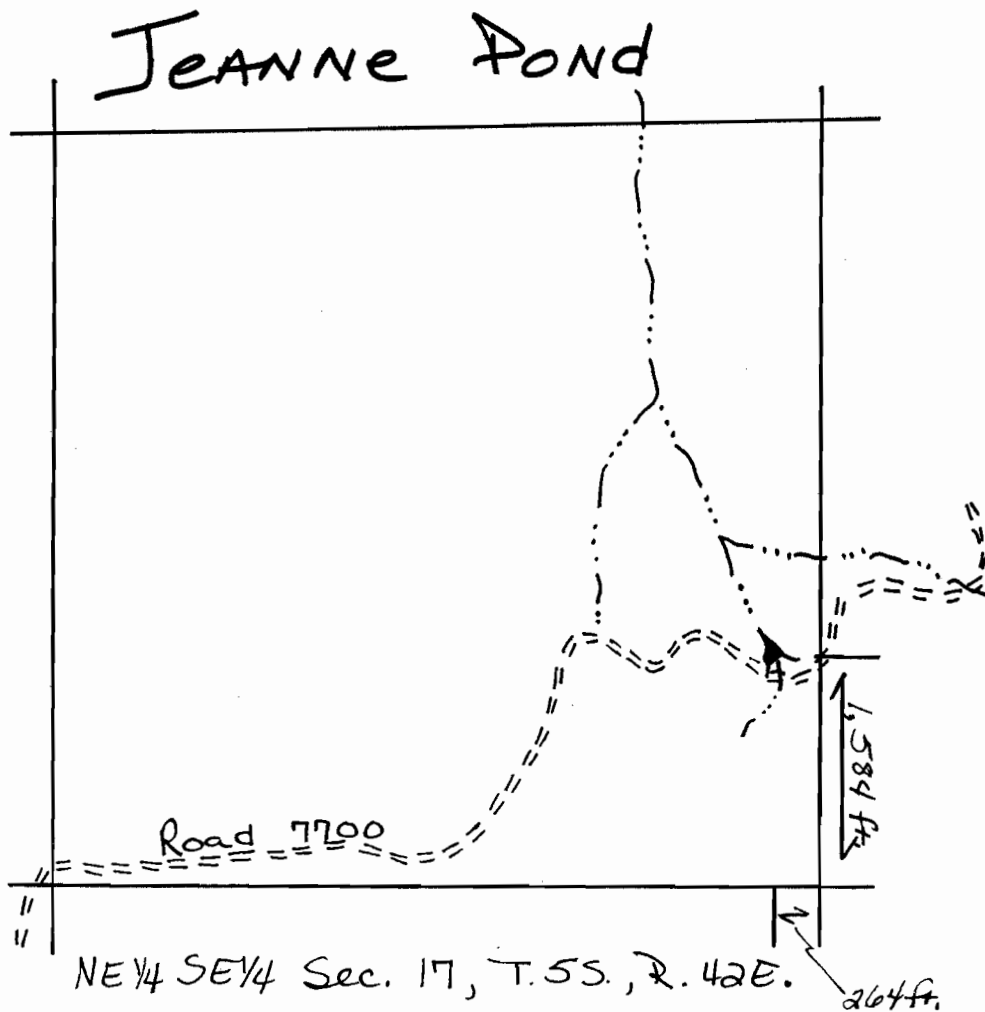

Scale:

4 inches = 1 mile

