


T. 2 S., R. 1 E., W. M.

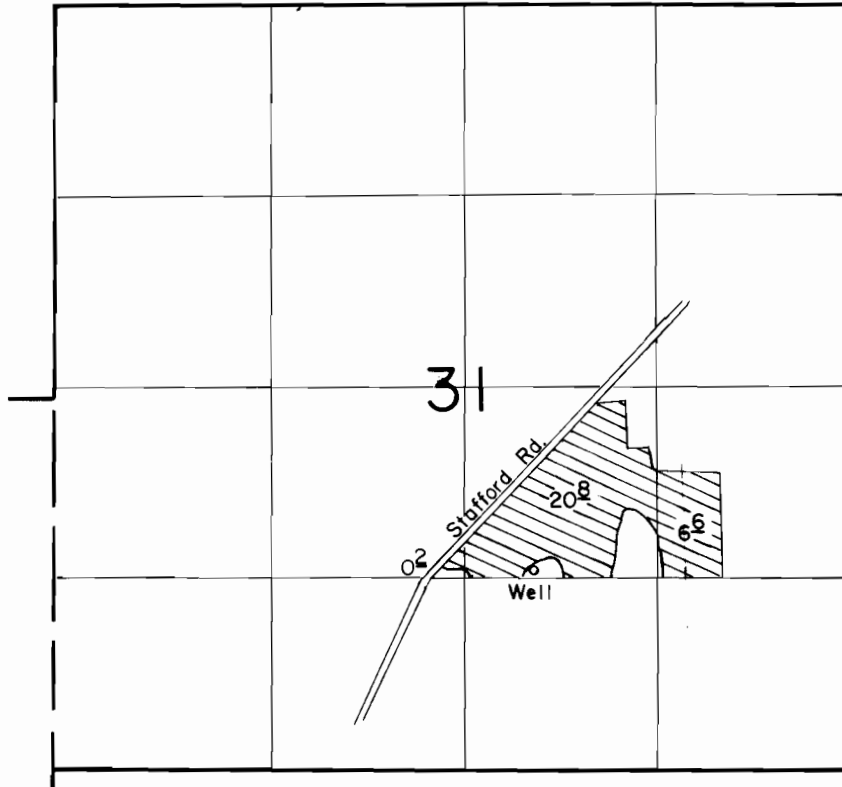

Well Loc.: 1170' S. & 450' E. from C. 1/4 Corner Sec. 31.

Scale: 1" = 1320'

FINAL PROOF SURVEY UNDER

Application No. G-10779 Permit No. G-10024...
IN NAME OF

.....VIRGINIA A. DAVIS.....

Surveyed Nov. 2, 1990, by T. Warren.....