


T. 6N. R. 35E. W.M.

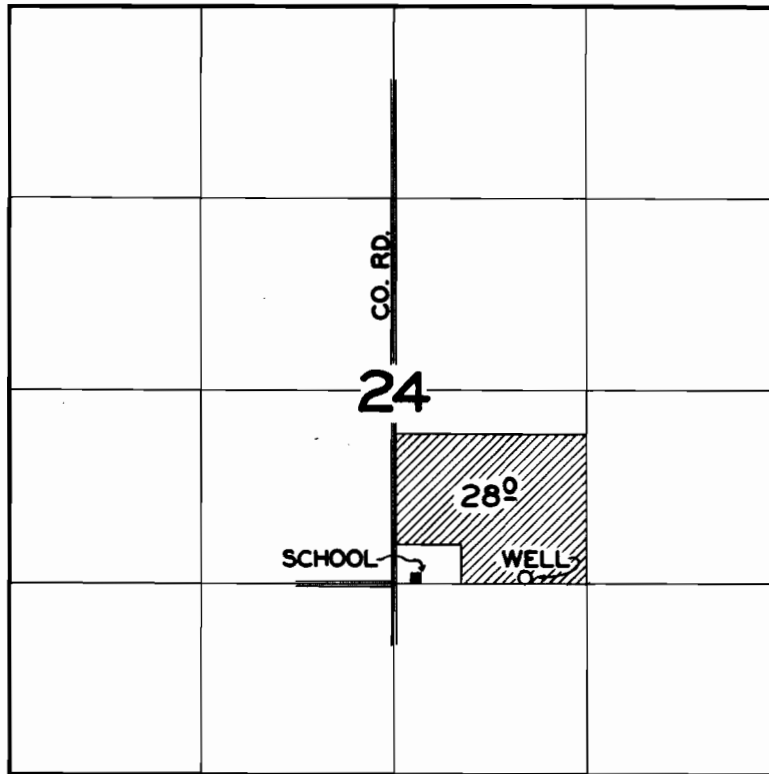

FINAL PROOF SURVEY

UNDER

Application No. U-330 Permit No. U-304

IN NAME OF

J.F. CHVATAL

Surveyed JUNE 2 1957, by C.O. Burtch