


34  
Gravel  
5760  
x 5792

MALHEUR NATIONAL FOREST

STOCK WATER

*Antelope* allotment  
FS Temporary Id. # 83P34  
SCALE 4 IN. : 1 MILE  
T 18S R 35E Sec. 4 North

application no. R-67494  
permit no. R-10928

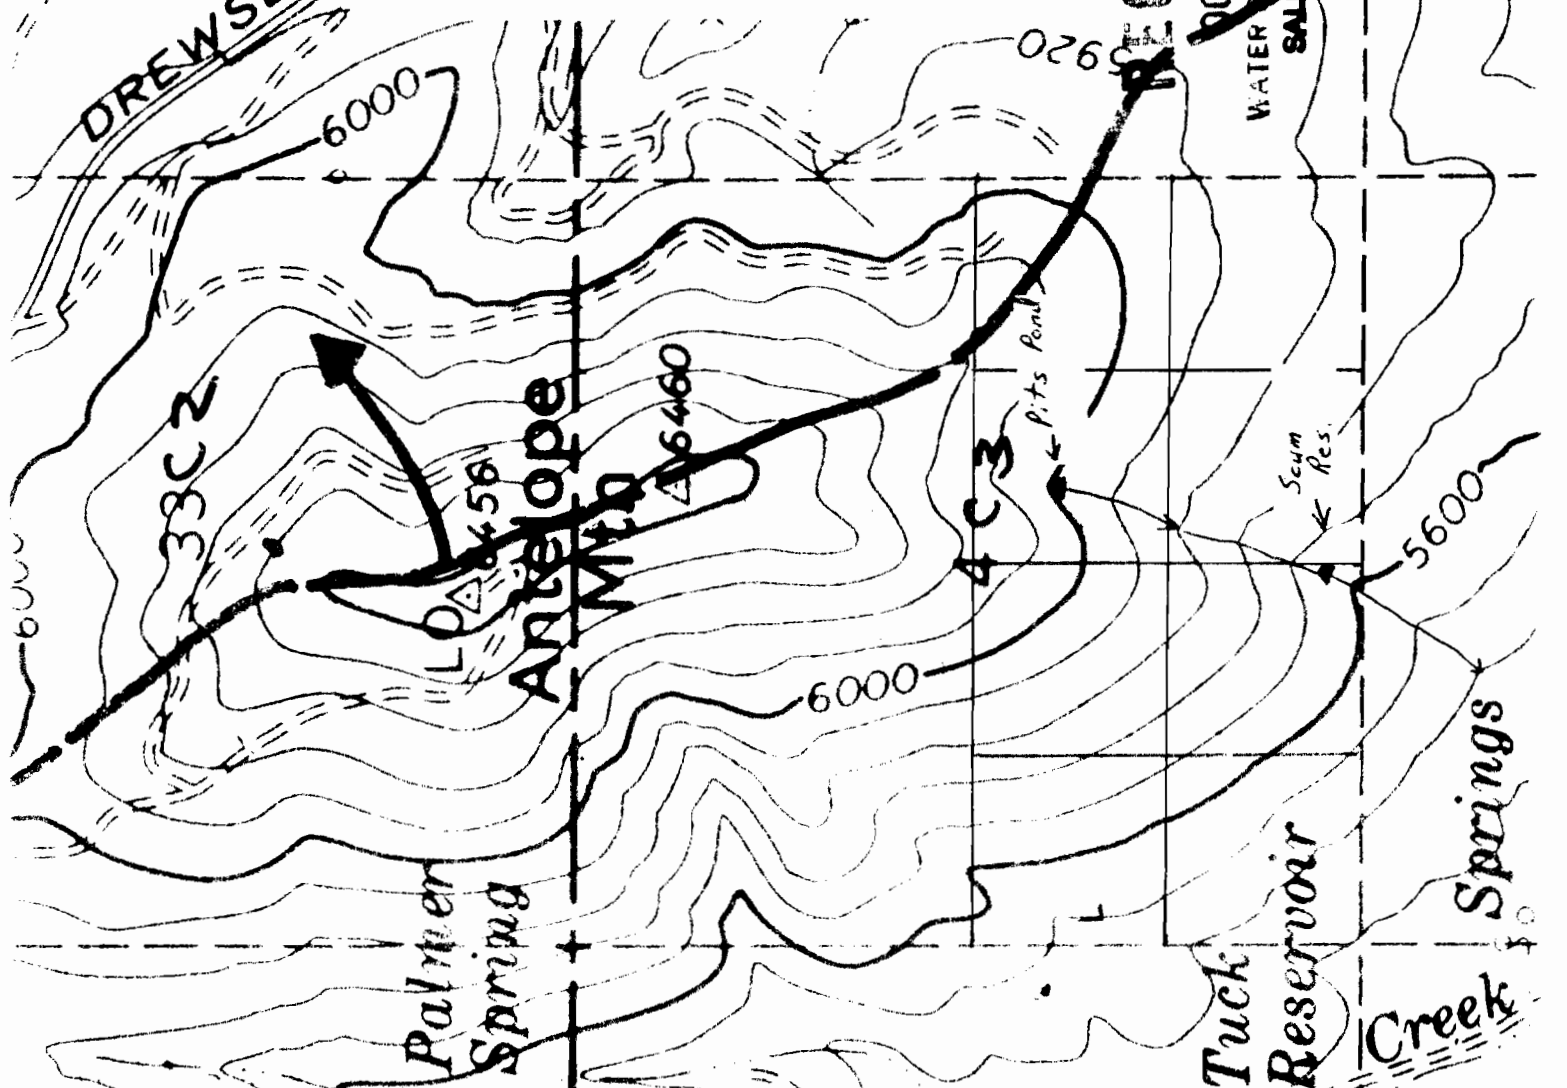

RECEIVED

OCT 11 1983  
WATER RESOURCES DEPT.  

BM X 5442