

MALHEUR NATIONAL FOREST

STOCK WATER

Antelope allotment



FS Temporary Id. # 83235

SCALE 4 IN. : 1 MILE

T18S R35E North

application no. R-267495

permit no. P-10929

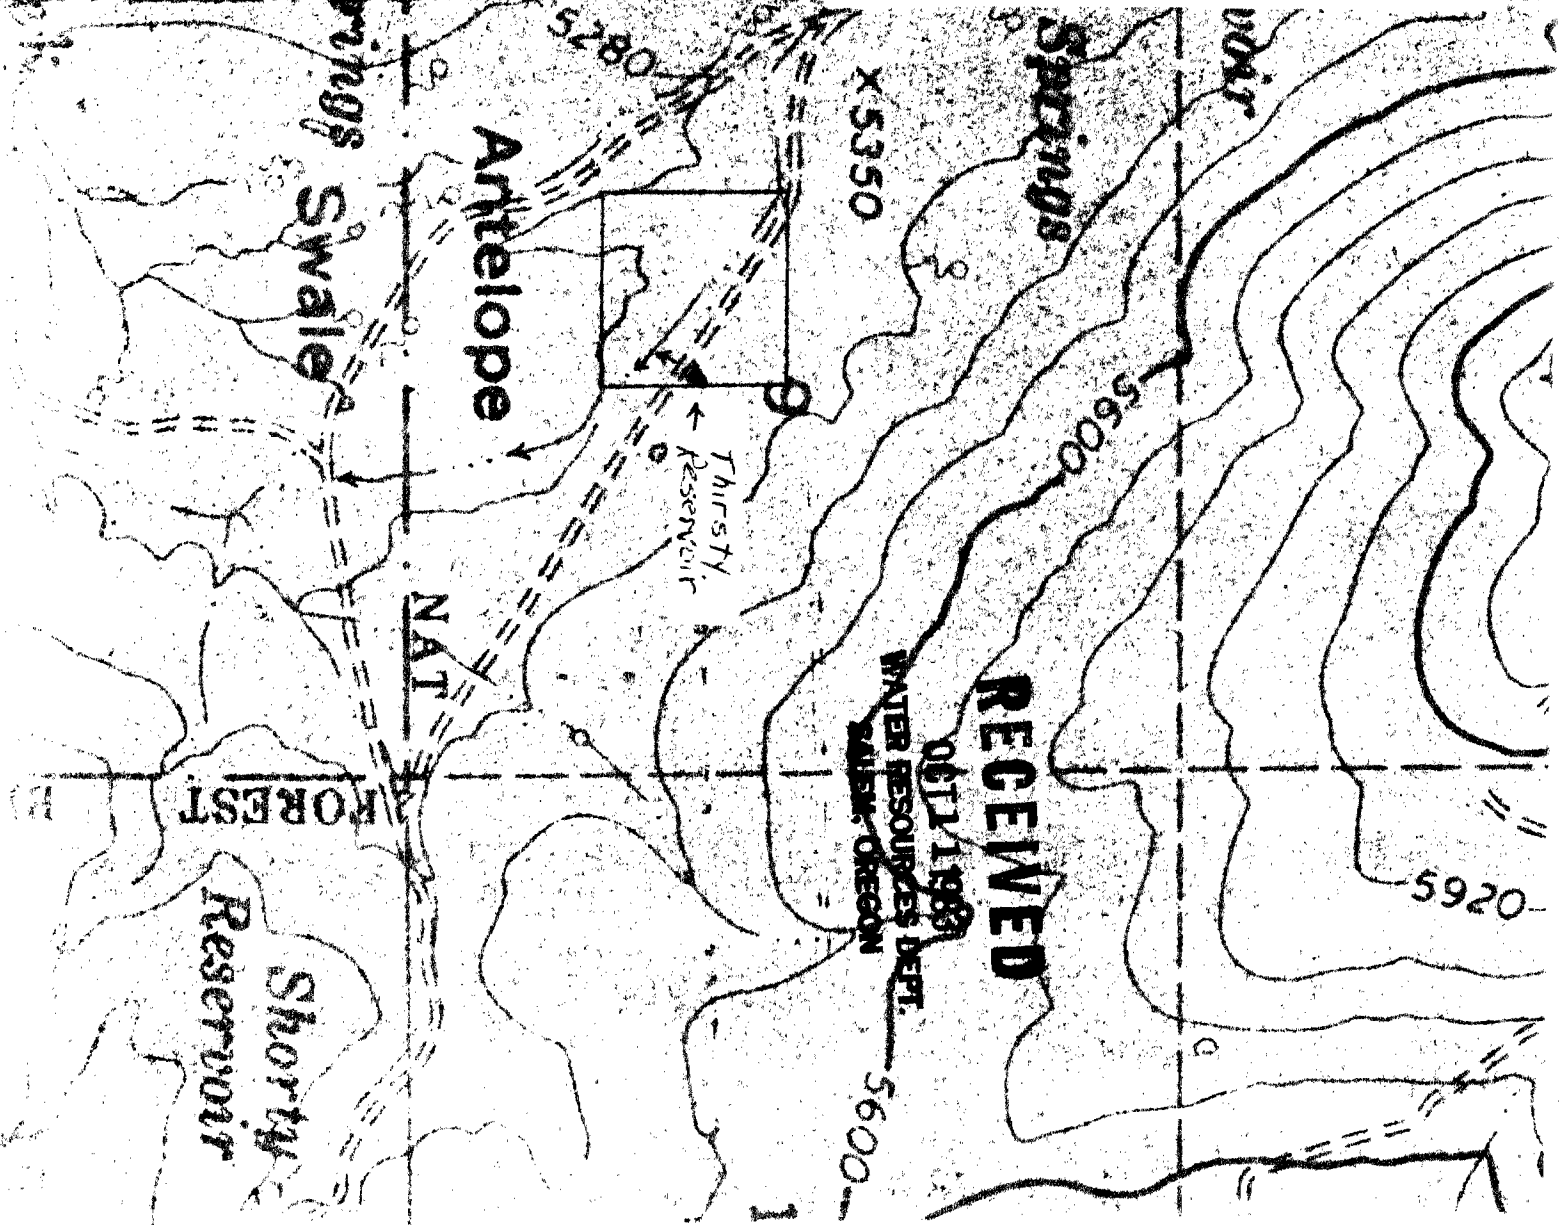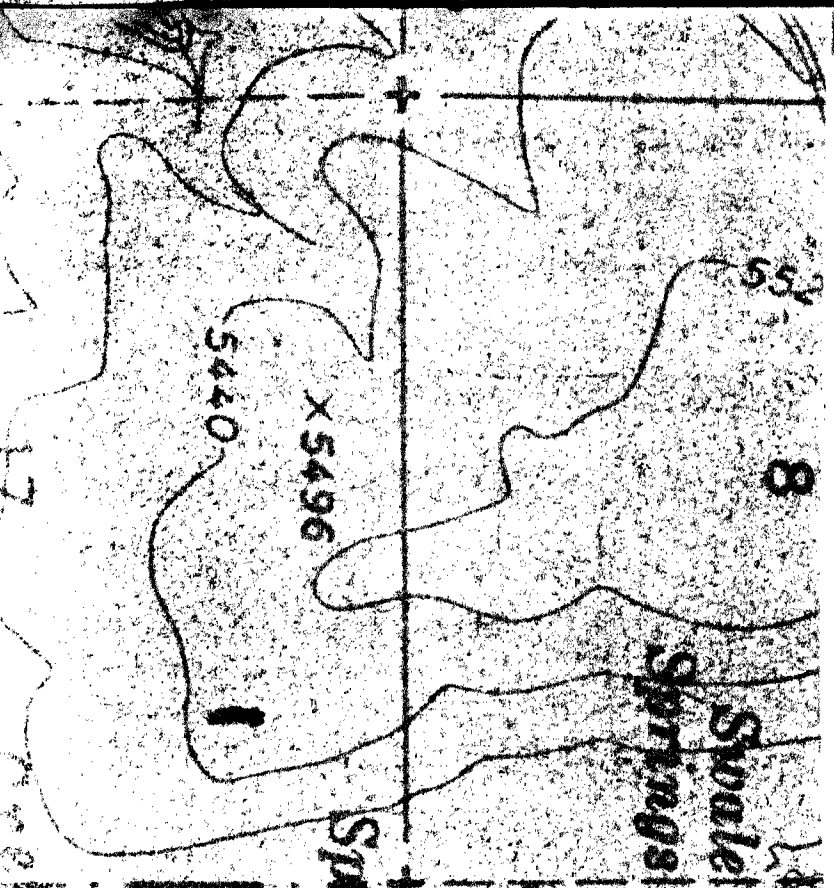

RECEIVED

OCT 11 1981
WATER RESOURCES DEPT.
