

G 9137

52637

78329

T 8713

T 8750


80439

T 8713

80437

T 8750

T.25S.,R.14E.,W.M.

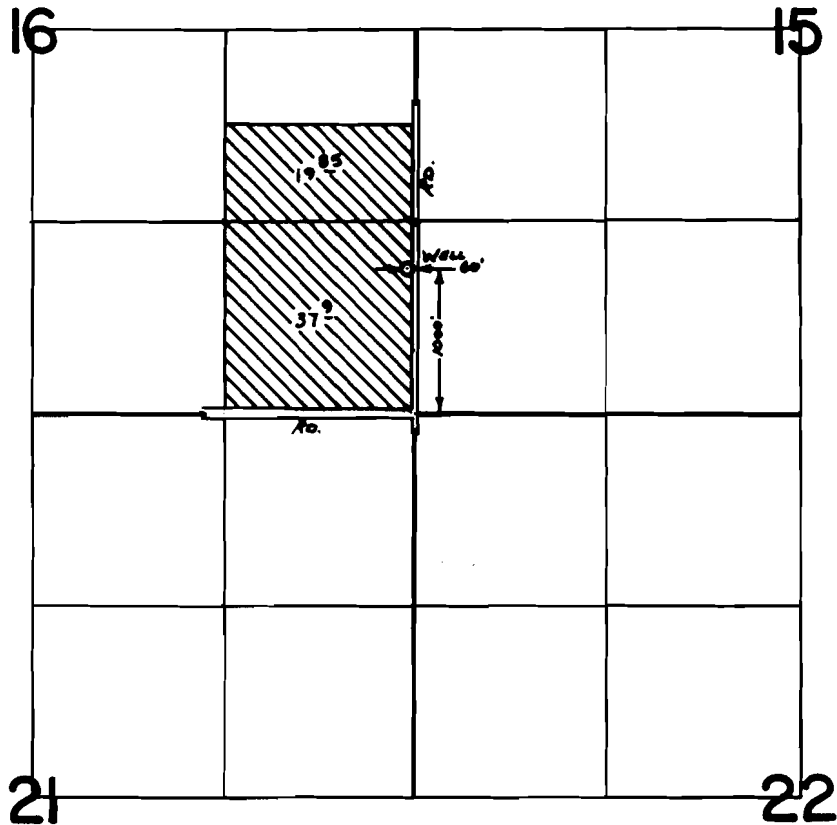

FINAL PROOF SURVEY UNDER

Application No. G:10072 Permit No. G:9137.....
IN NAME OF

.....**ROBERT E. TUTTLE**.....

Surveyed Aug. 27... 1983., by ..L.M. JOLL.....