


Application No. R-64303
Permit No. R10115

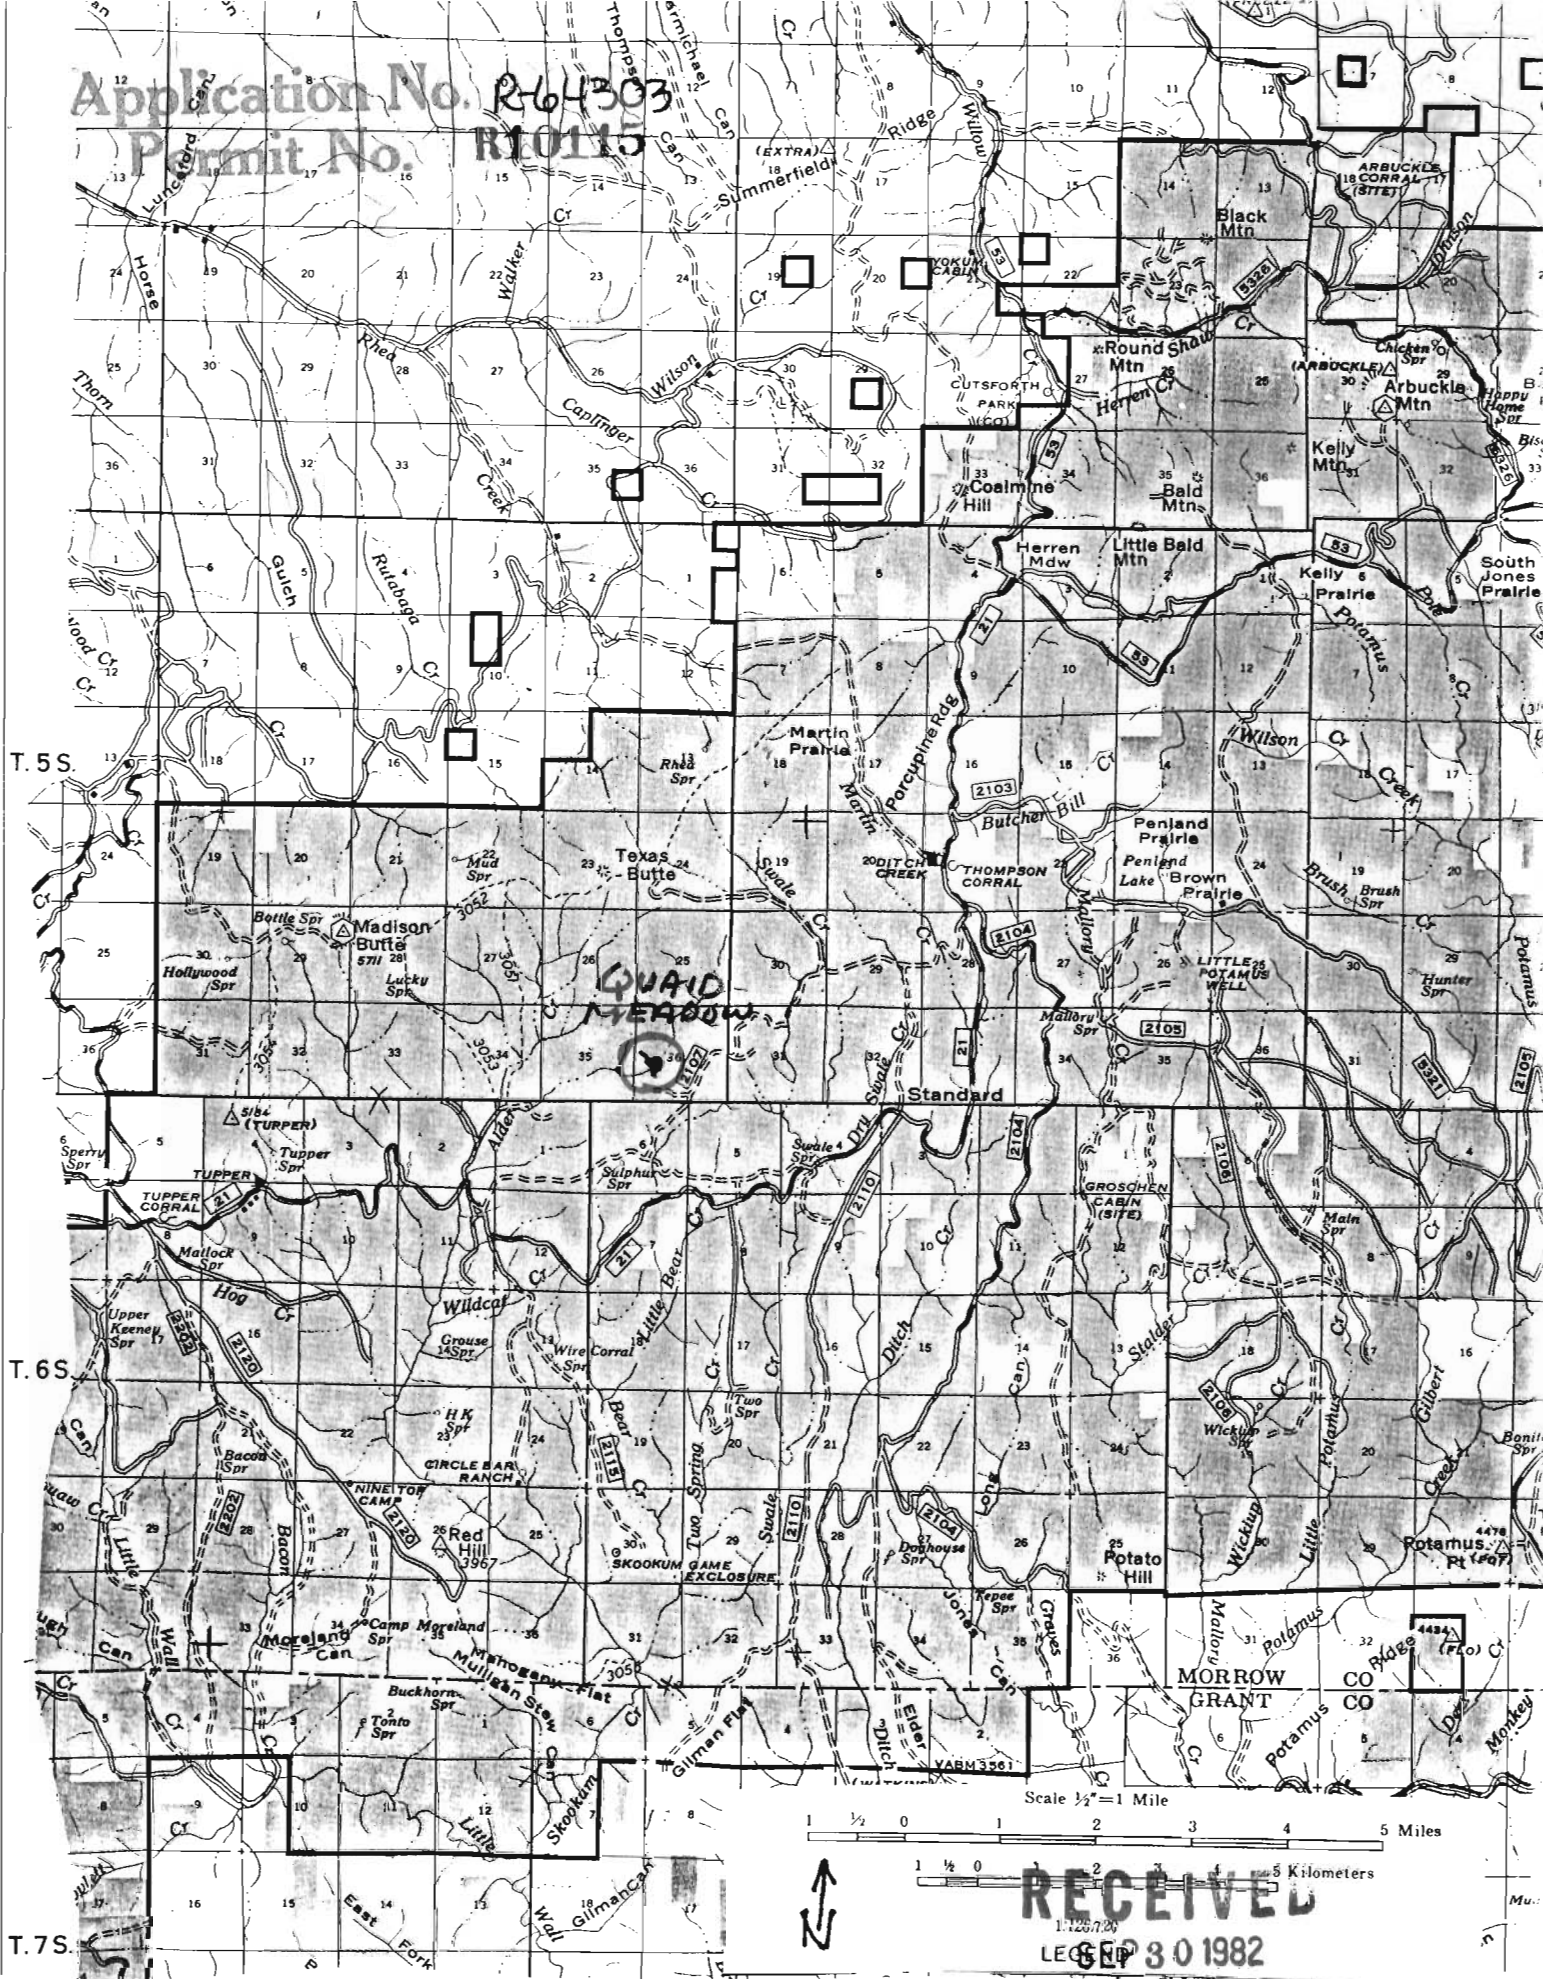

RECEIVED

SEP 30 1982

WATER RESOURCES DIV.
SALEM, OREGON

TOWNSHIP 5 S, RANGE 27 E, SECTION 36, W.M.

35

36

4

Application No. R-64303
Permit No. R10115

2

1

NAME Quaid Member Rev

COUNTY Morrow

RECEIVED
SEP 30 1982
WATER RESOURCES DEPT.
SALEM, OREGON