

T 65

R 24 E

Section 28

Application No. R-64307
Permit No. R10119

Perry Spring

Tall Grass
Pond

U M A T I L L A

RECEIVED


DEC 19 1983

WATER RESOURCES DEPT.
SALEM, OREGON

F T S T

Application No. R-64307

Permit No. R10119

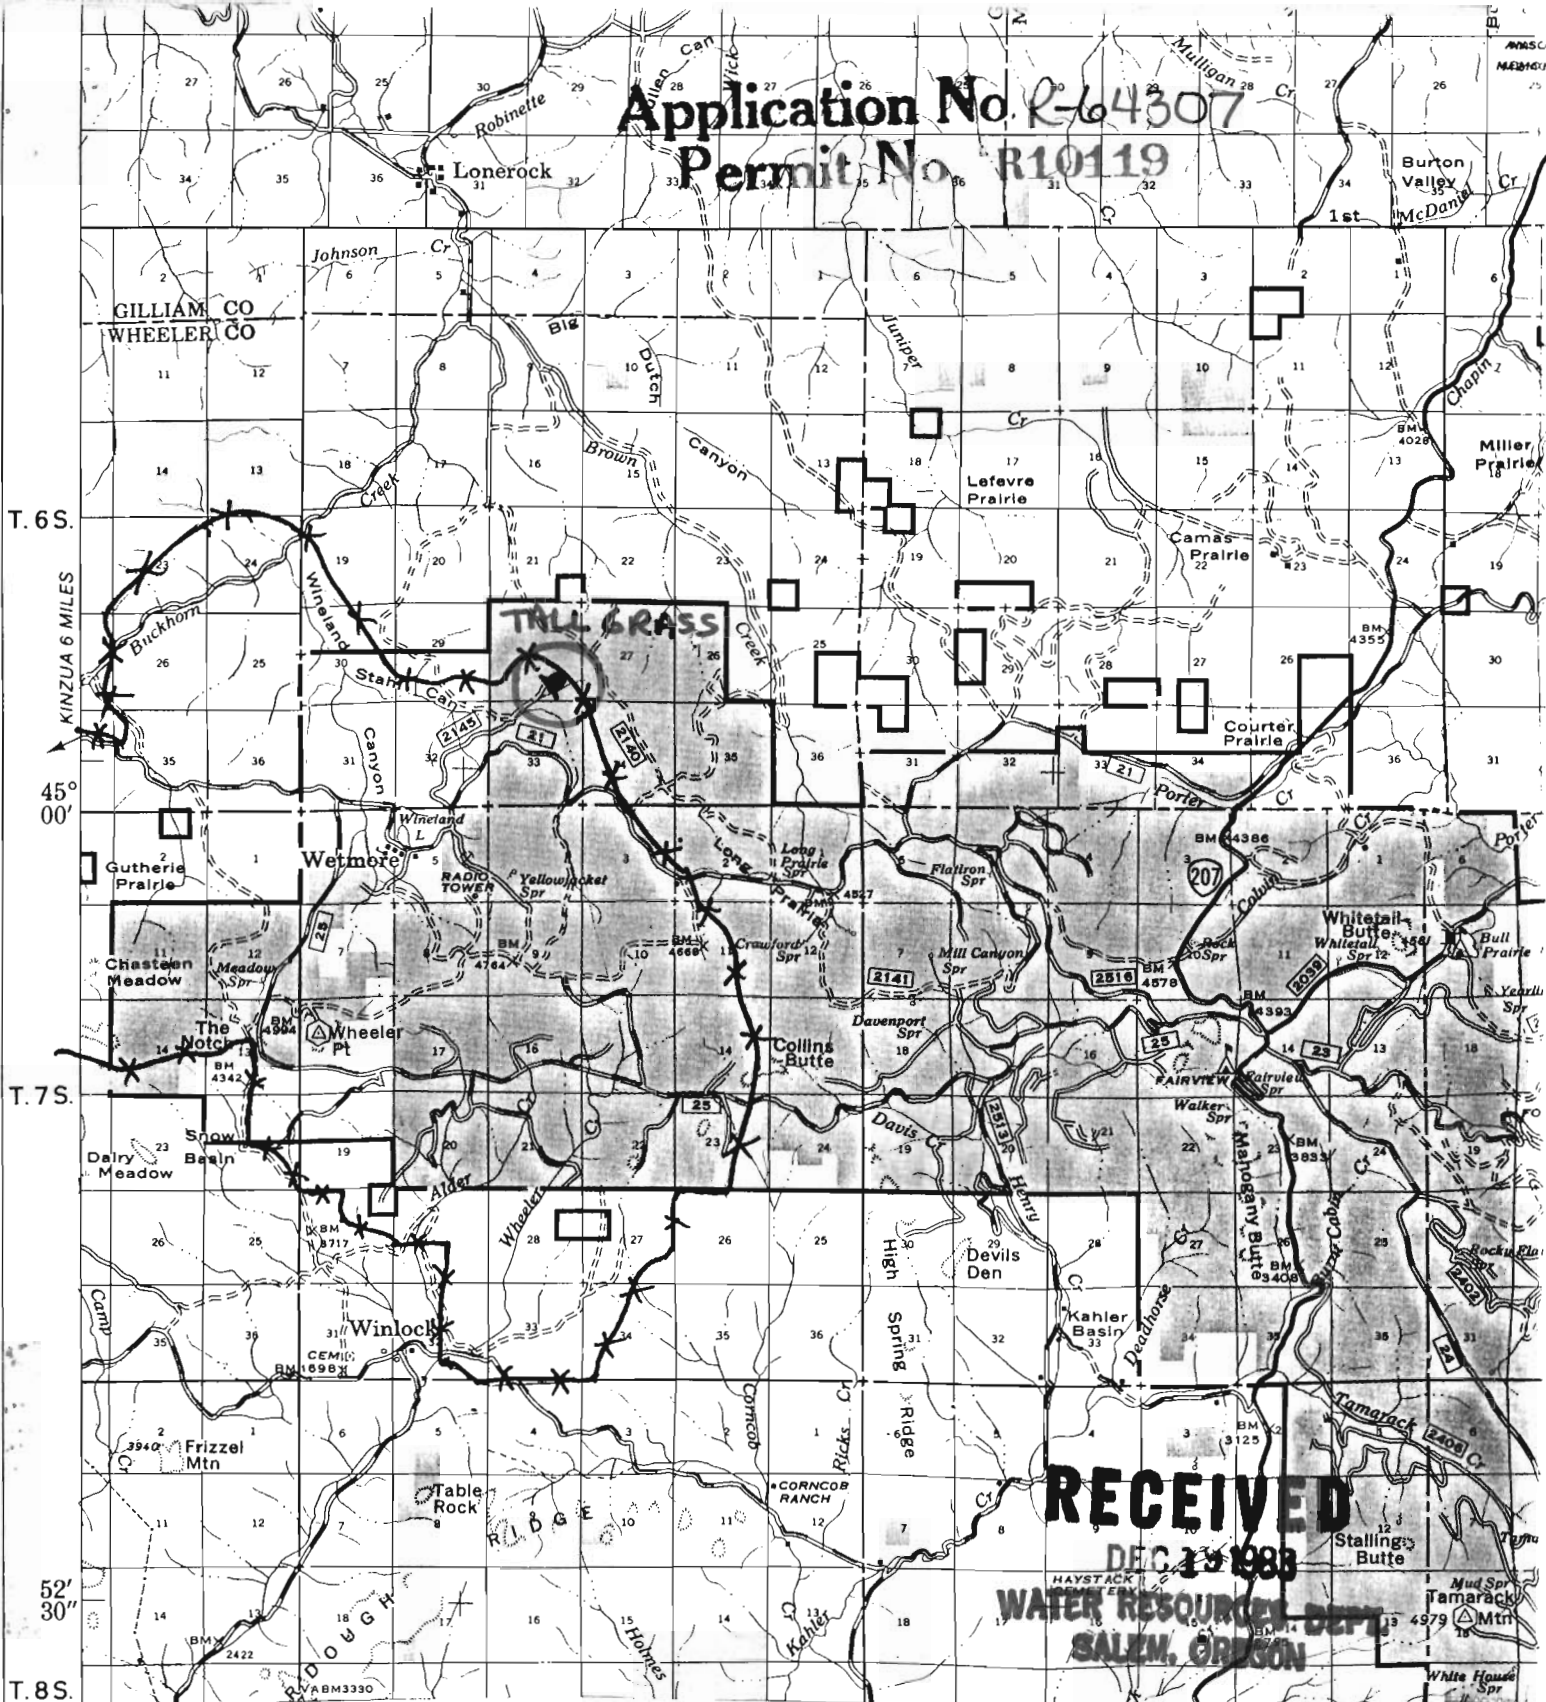

RECEIVED

DEC 15 1983

WATER RESOURCES DEPT.
SALEM, OREGON

1976

Scale 1/2"=1 Mile

1 1/2 0 1 2 3 4 5 Miles

1 1/2 0 1 2 3 4 5 Kilometers

1:126,720

LEGEND

WHEELER - YELLOW JACKET

RECEIVED

SEP 30 1982

WATER RESOURCES DEPT.
SALEM, OREGON

R. 23 E.

R. 24 E.

R. 25 E.