



Application No. R-64308
Permit No. R10120

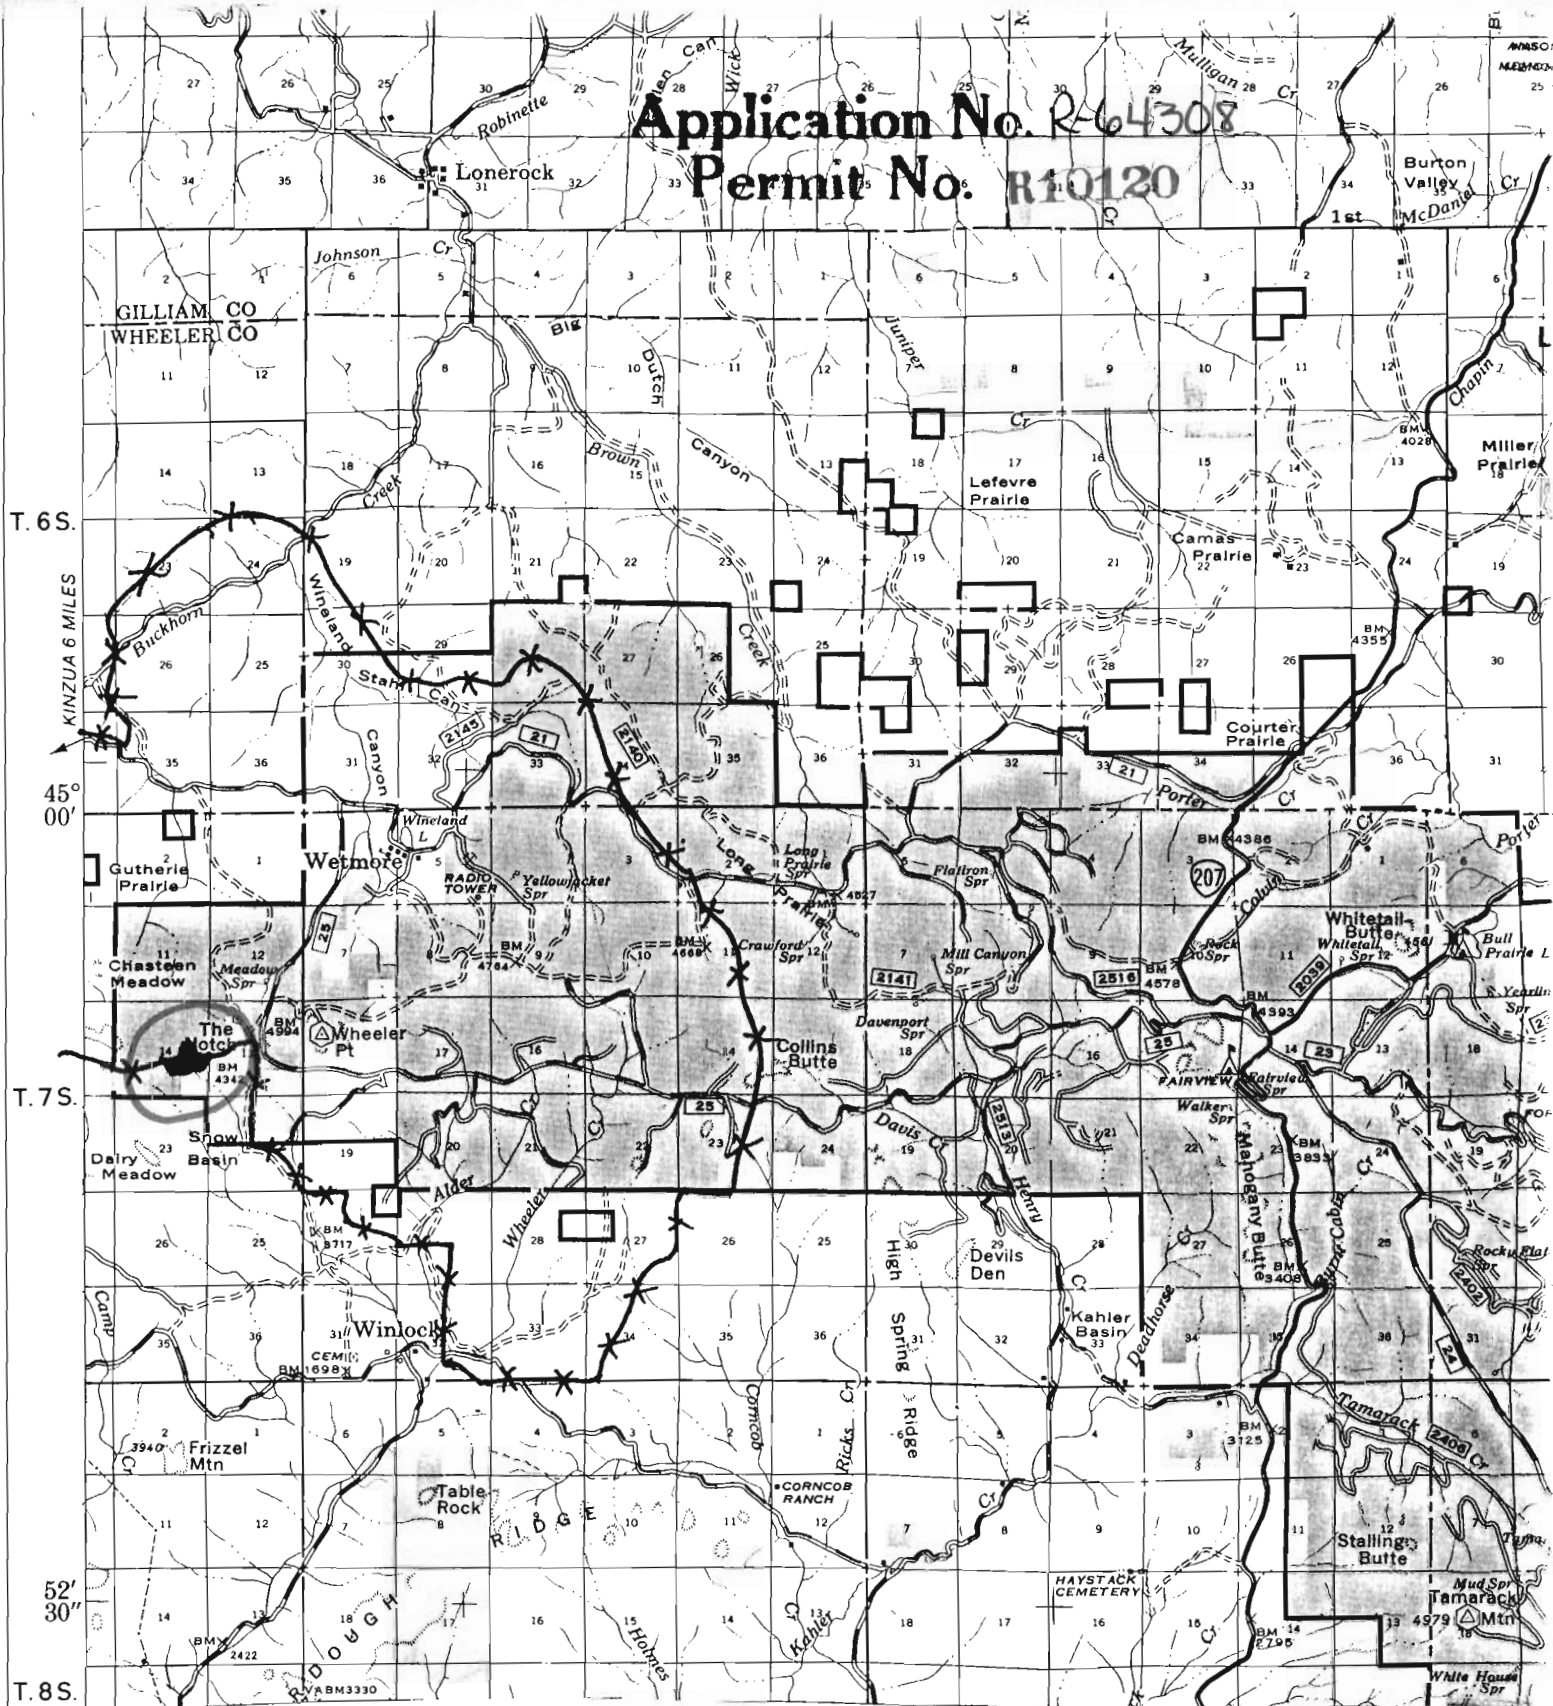

1976

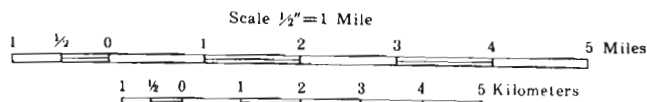

1:126,720

LEGEND

WHEELER - YELLOW JACKET

XXX ALLOTMENT BNDRY

RECEIVED

SEP 30 1982

WATER RESOURCES

SALEM, OREGON

R. 25 E.

TOWNSHIP 75, RANGE 23E, SECTION 14, W.M.

14

13

Application No. R-64308
Permit No. R10120

23

24

NAME

Louise M. Pond

COUNTY

Wheeler

RECEIVED

SEP 30 1982

WATER RESOURCES
SALEM, OREGON