



Application No. R-64317
Permit No. R10129

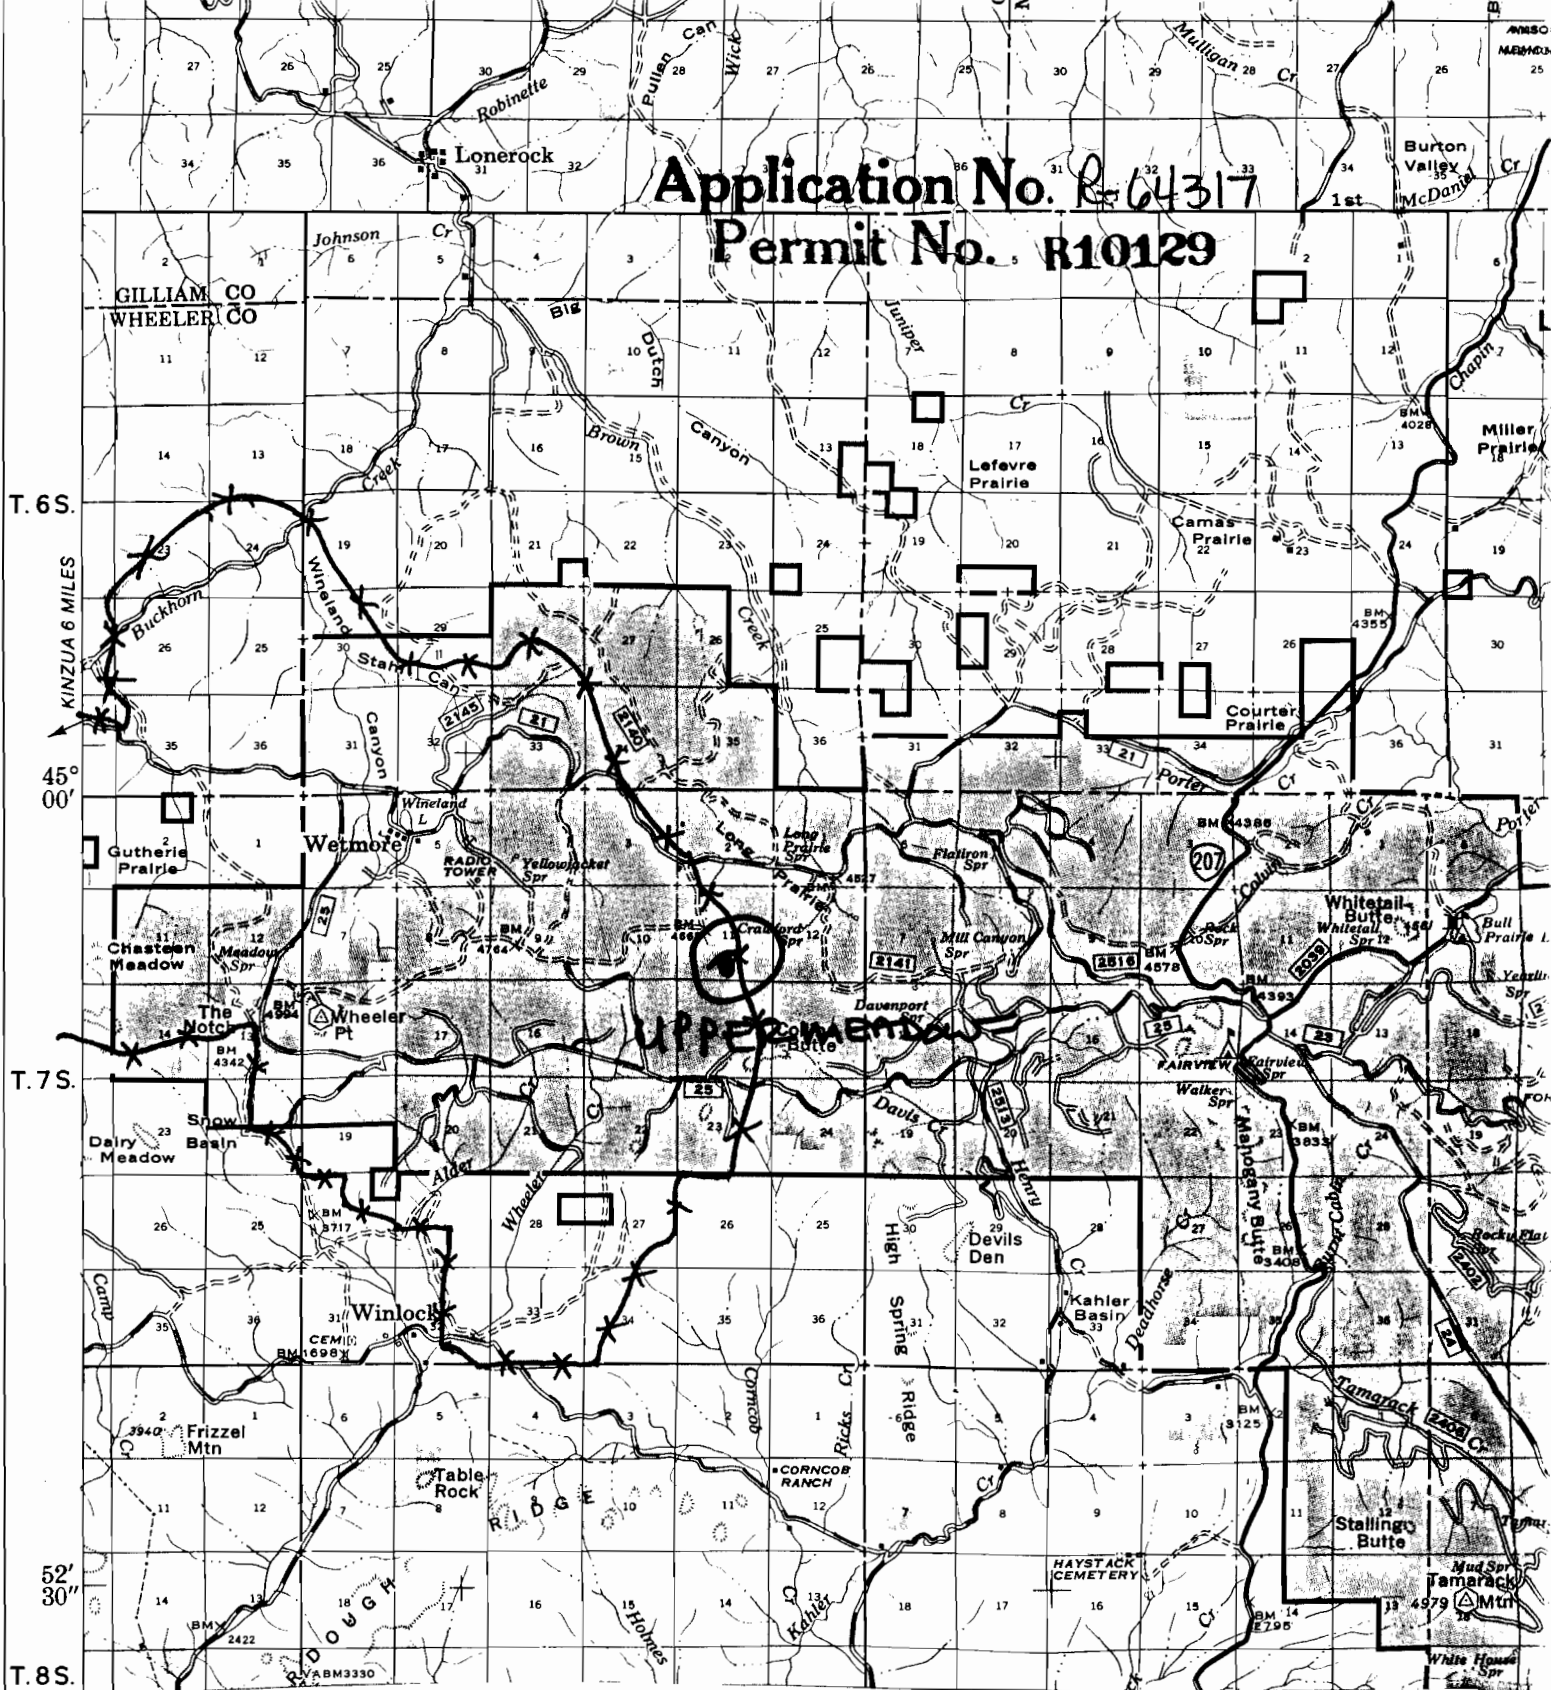

1976

Scale 1/2" = 1 Mile

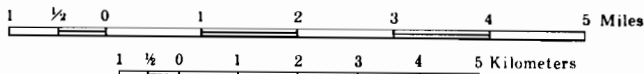

1:126,720

LEGEND

WHEELER - YELLOW JACKET

*** AUGMENT 3 NOPY
RECEIVED

SEP 30 1982

WATER RESOURCES

SALEM, OREGON

R. 23 E.

R. 24 E.

R. 25 E.

TOWNSHIP 75, RANGE 24E, SECTION 11, W.M.

10

11

Application No. R-64317
Permit No. R10129

15

14

NAME Upper Meadow Res.

COUNTY Ches. Co.