



Application No. R-64318
Permit No. H10130

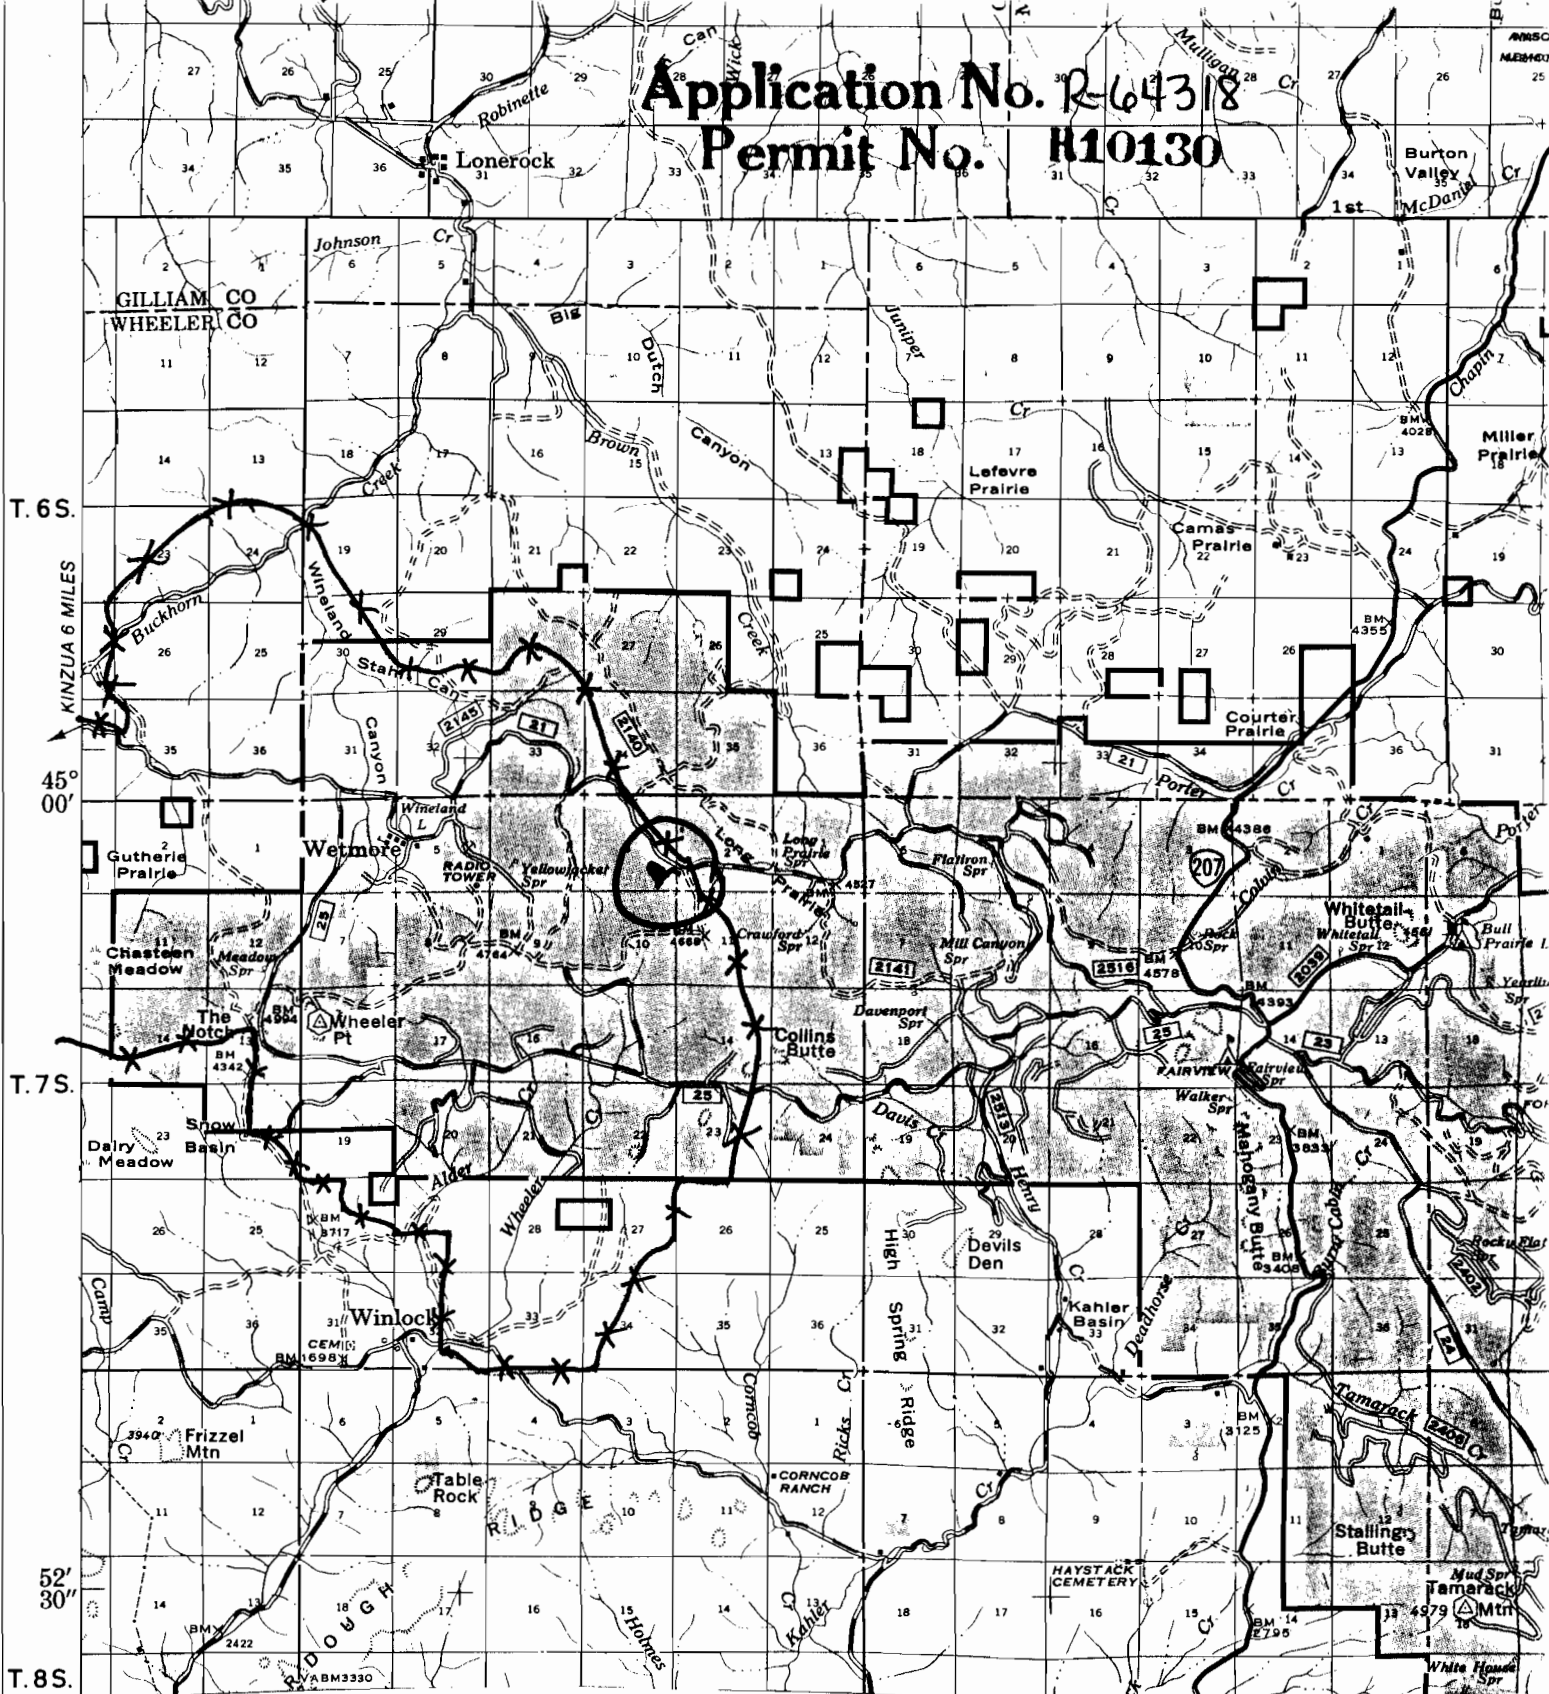

1976

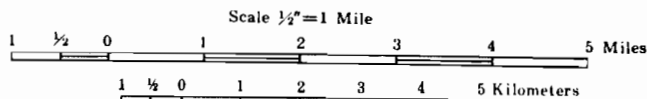

1:126,720
LEGEND

WHEELER - YELLOW JACKET

*** RECEIVED ***

SEP 30 1982

WATER RESOURCES
SALEM, OREGON

R. 23 E.

R. 24 E.

R. 25 E.

FOSSIL 25 MILES

TOWNSHIP 75, RANGE 24E, SECTION 3, W.M.

3

2

Application No. R-64318
Permit No. R10130

10

11

NAME Brentley Wood

COUNTY Wheeler

RECEIVED

SEP 30 1982

WATER RESOURCES
SALEM, OREGON