


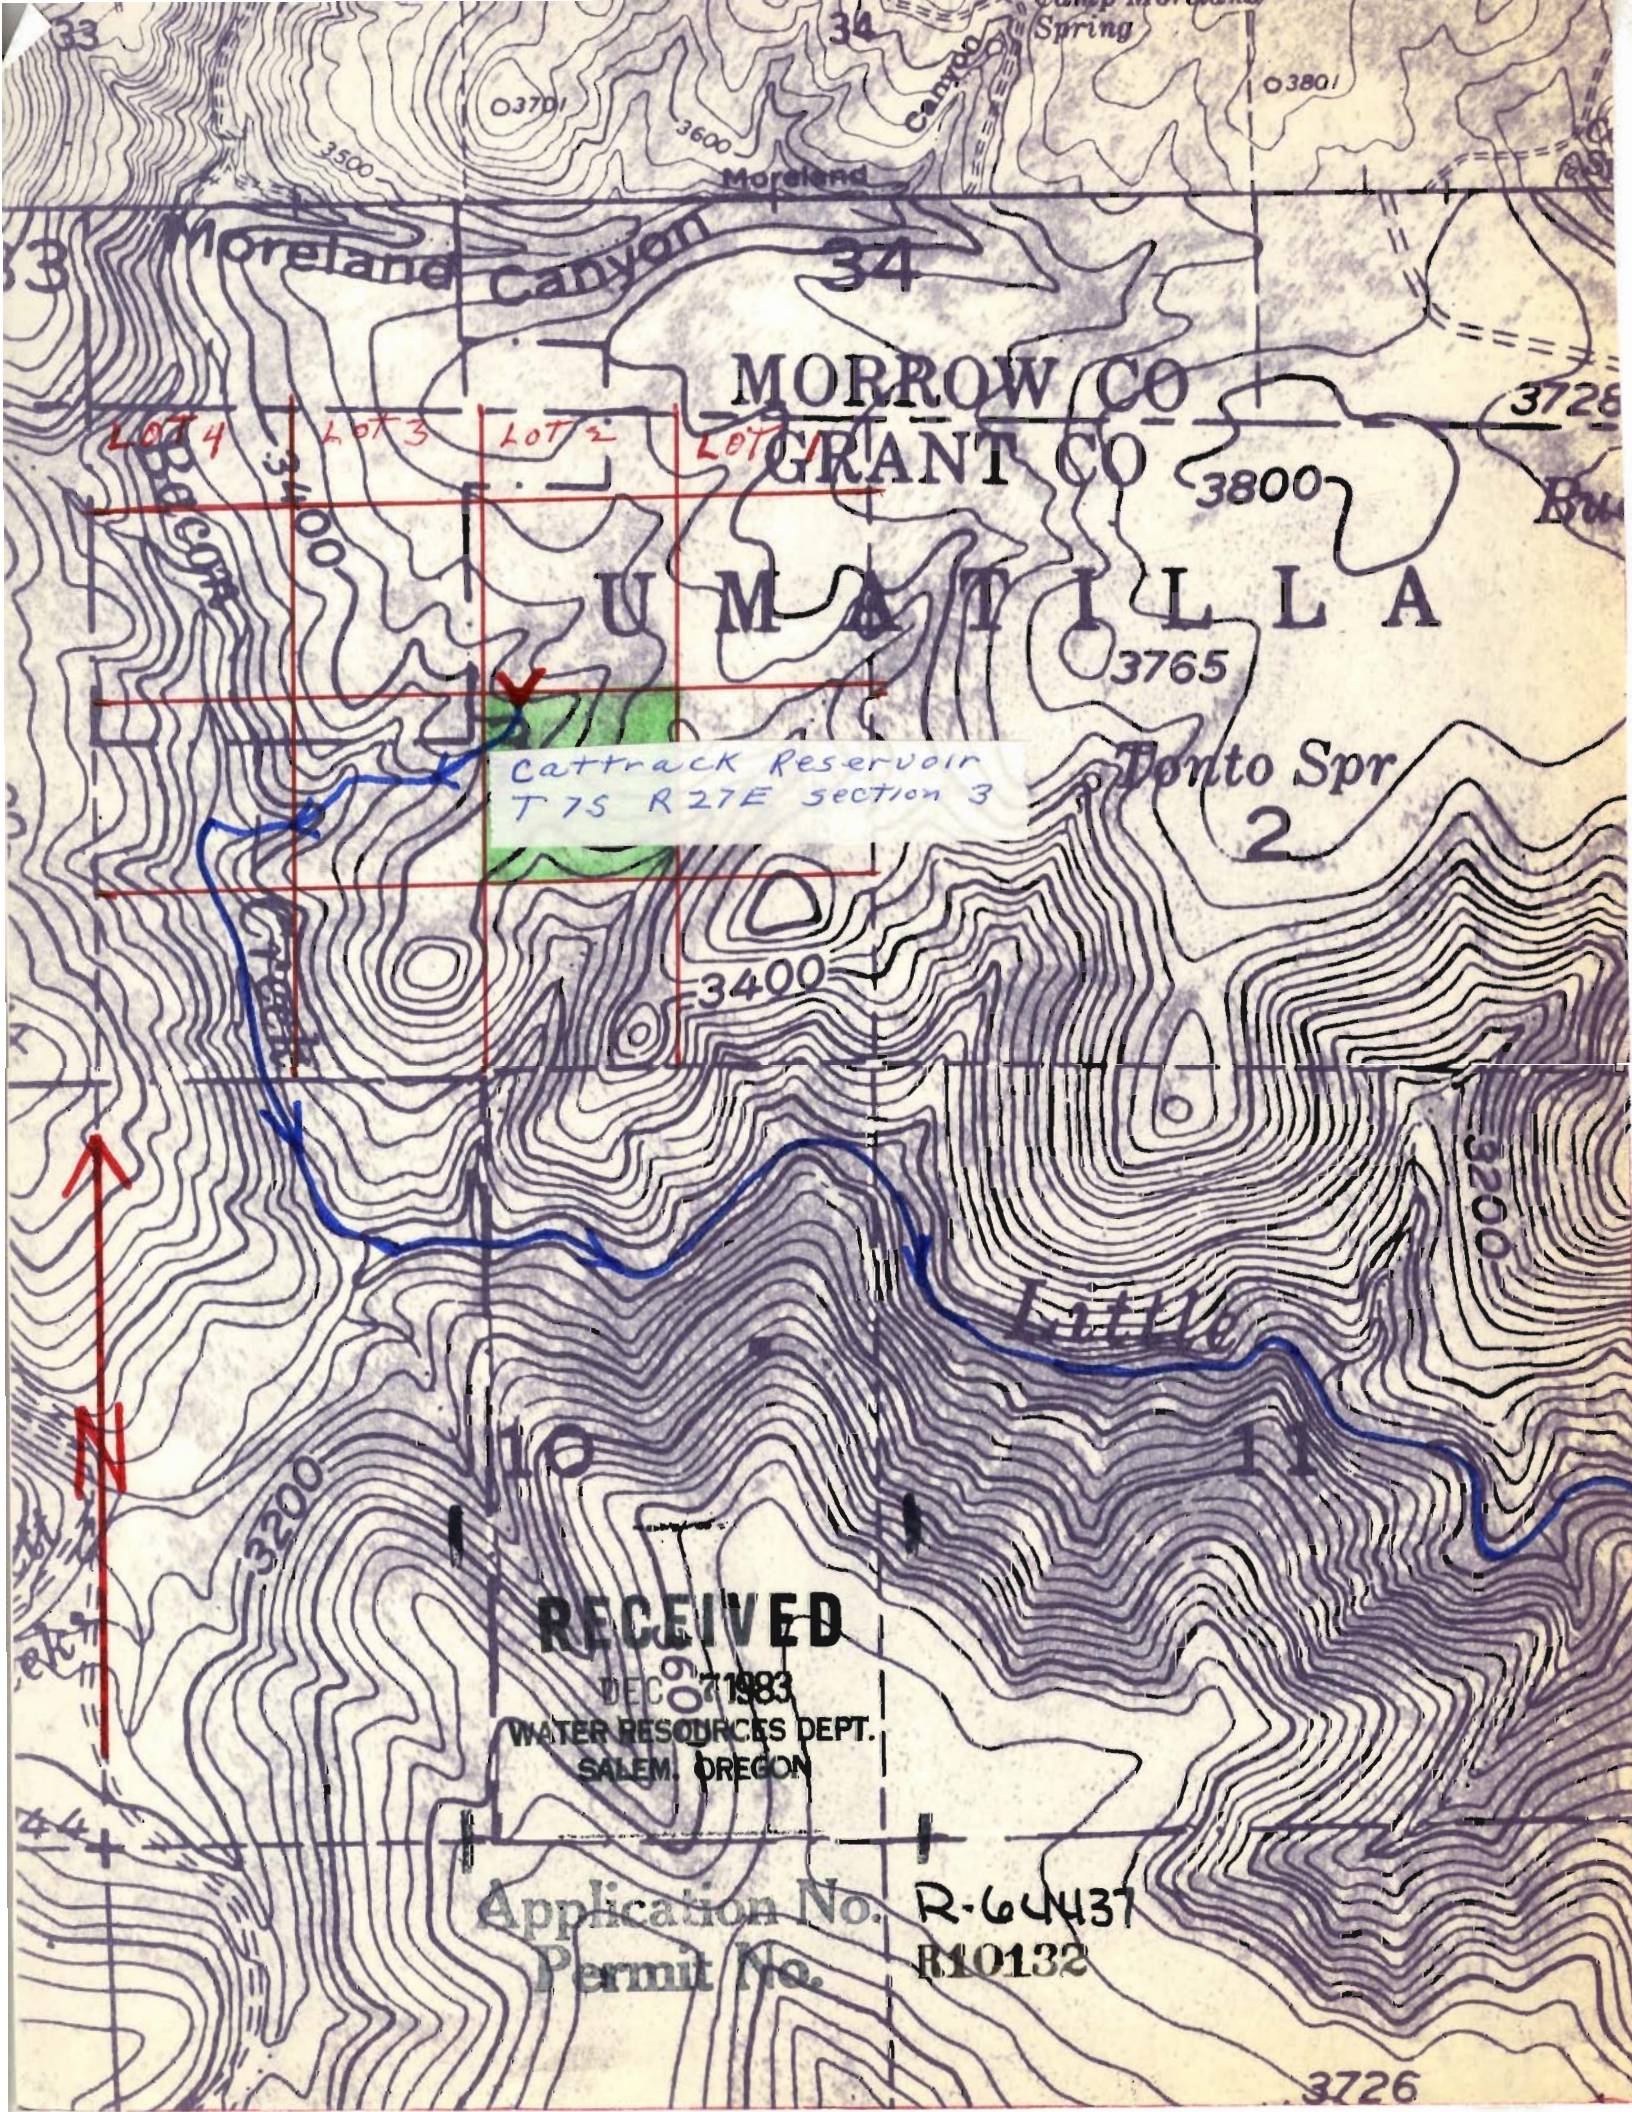

MORROW CO
GRANT CO

UMATILLA


Cattrack Reservoir
T7S R27E section 3

RECEIVED

DEC 7 1983
WATER RESOURCES DEPT.
SALEM, OREGON

Application No. R-64437
Permit No. R10132

Township 7.5 Range 27E Section 3 W.M.

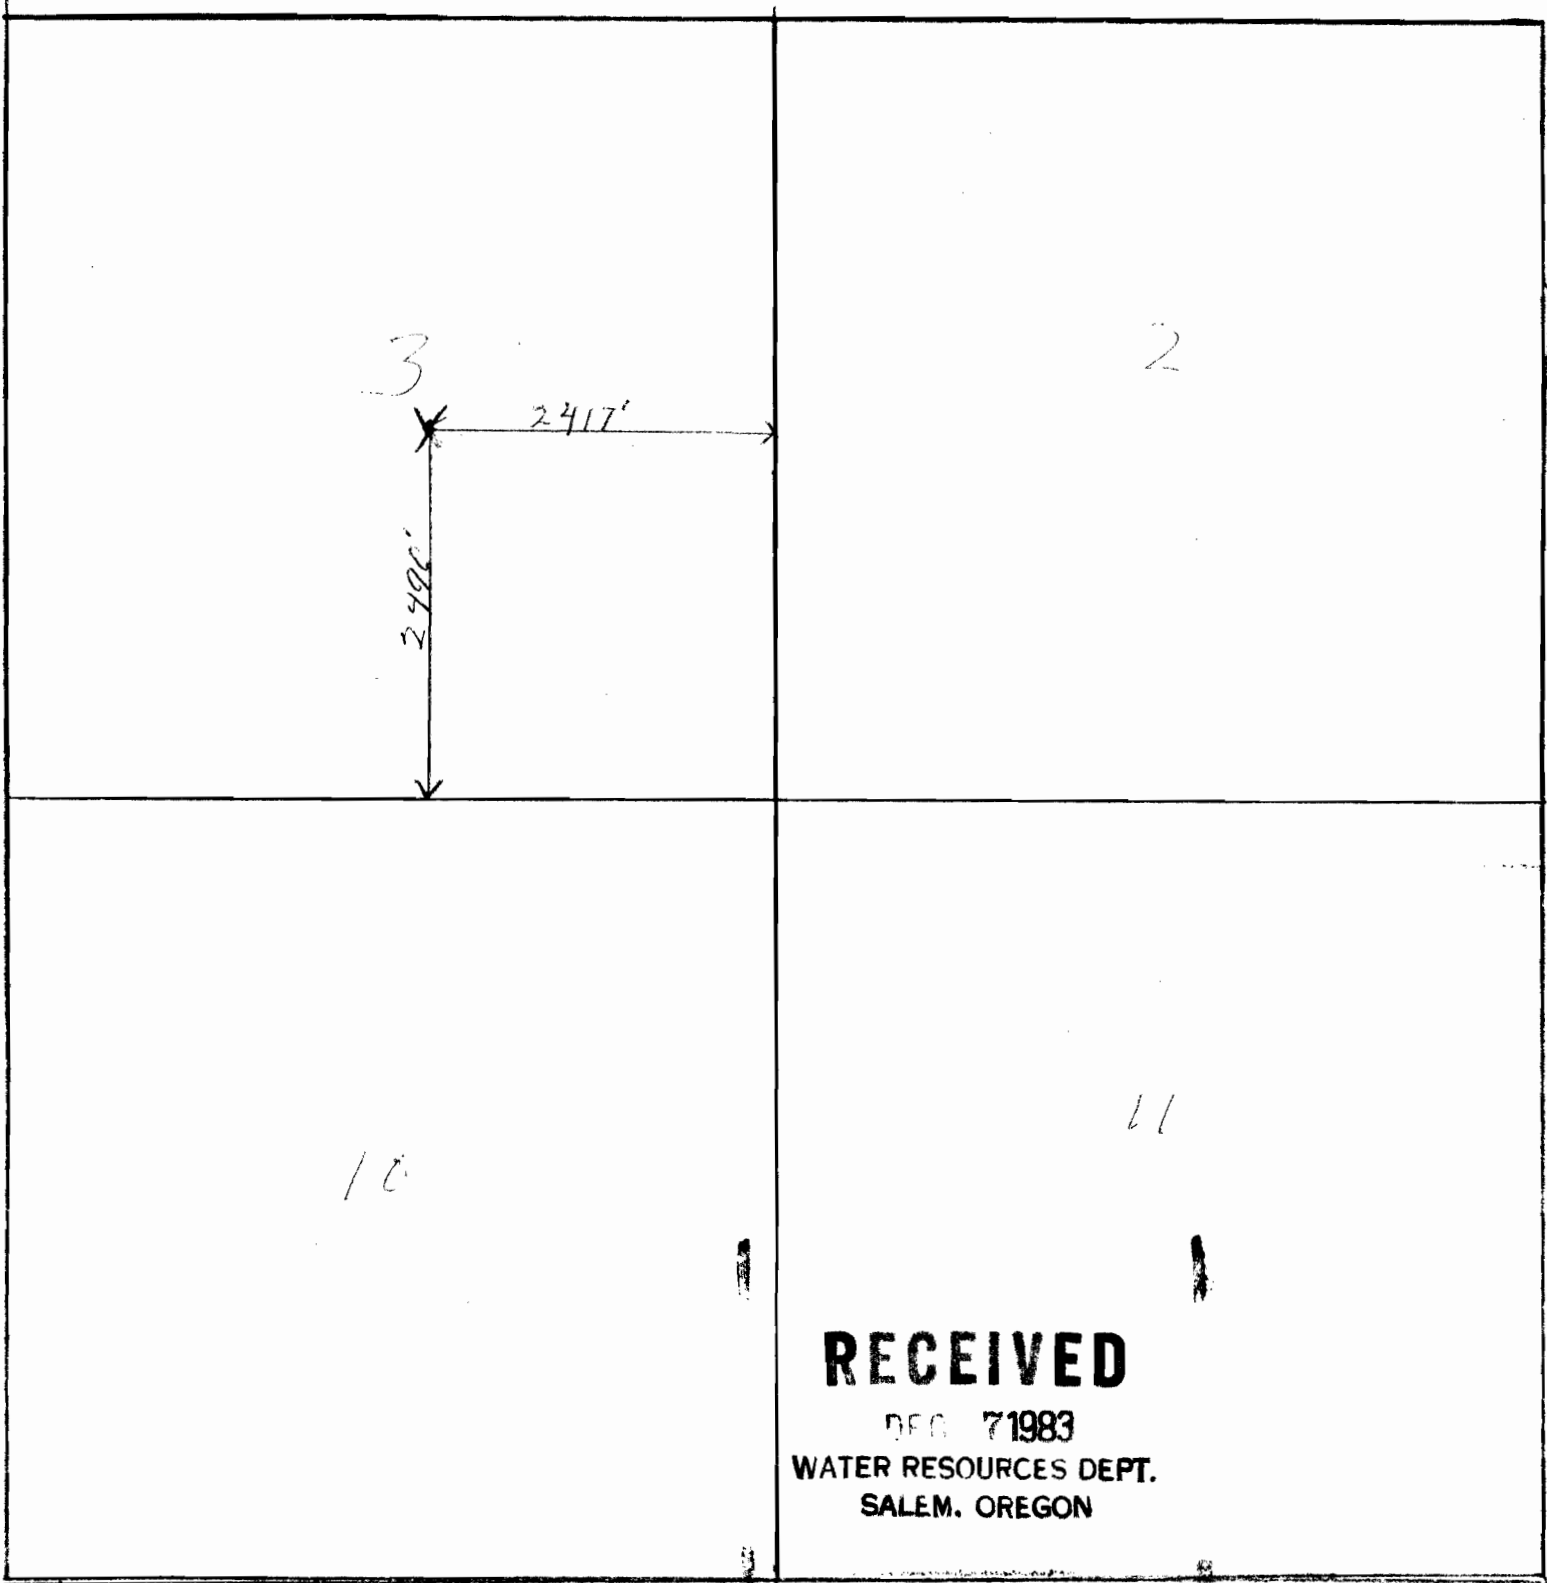

NAME Cattrack Reservoir County Gnant

Application No. R-64437

Permit No.