

RECEIVED

DEC 7 1983

WATER RESOURCES DEPT.
SALEM, OREGON

JEOP

TRAIL

Moss
Spring

CABLE RESERVOIR

O R E S T

Stalder

McMurry
Cabin


Application No. **R-641634**
Permit Nos **R10134**


CABLE RESERVOIR
LOT 7., T6S., R29E



Title and Encumbrance & Use Restriction
Maps are diagrammatic only — should not
be used for GLO survey plat locations.

71983
WATER RESOURCES DEPT
SALEM, OREGON

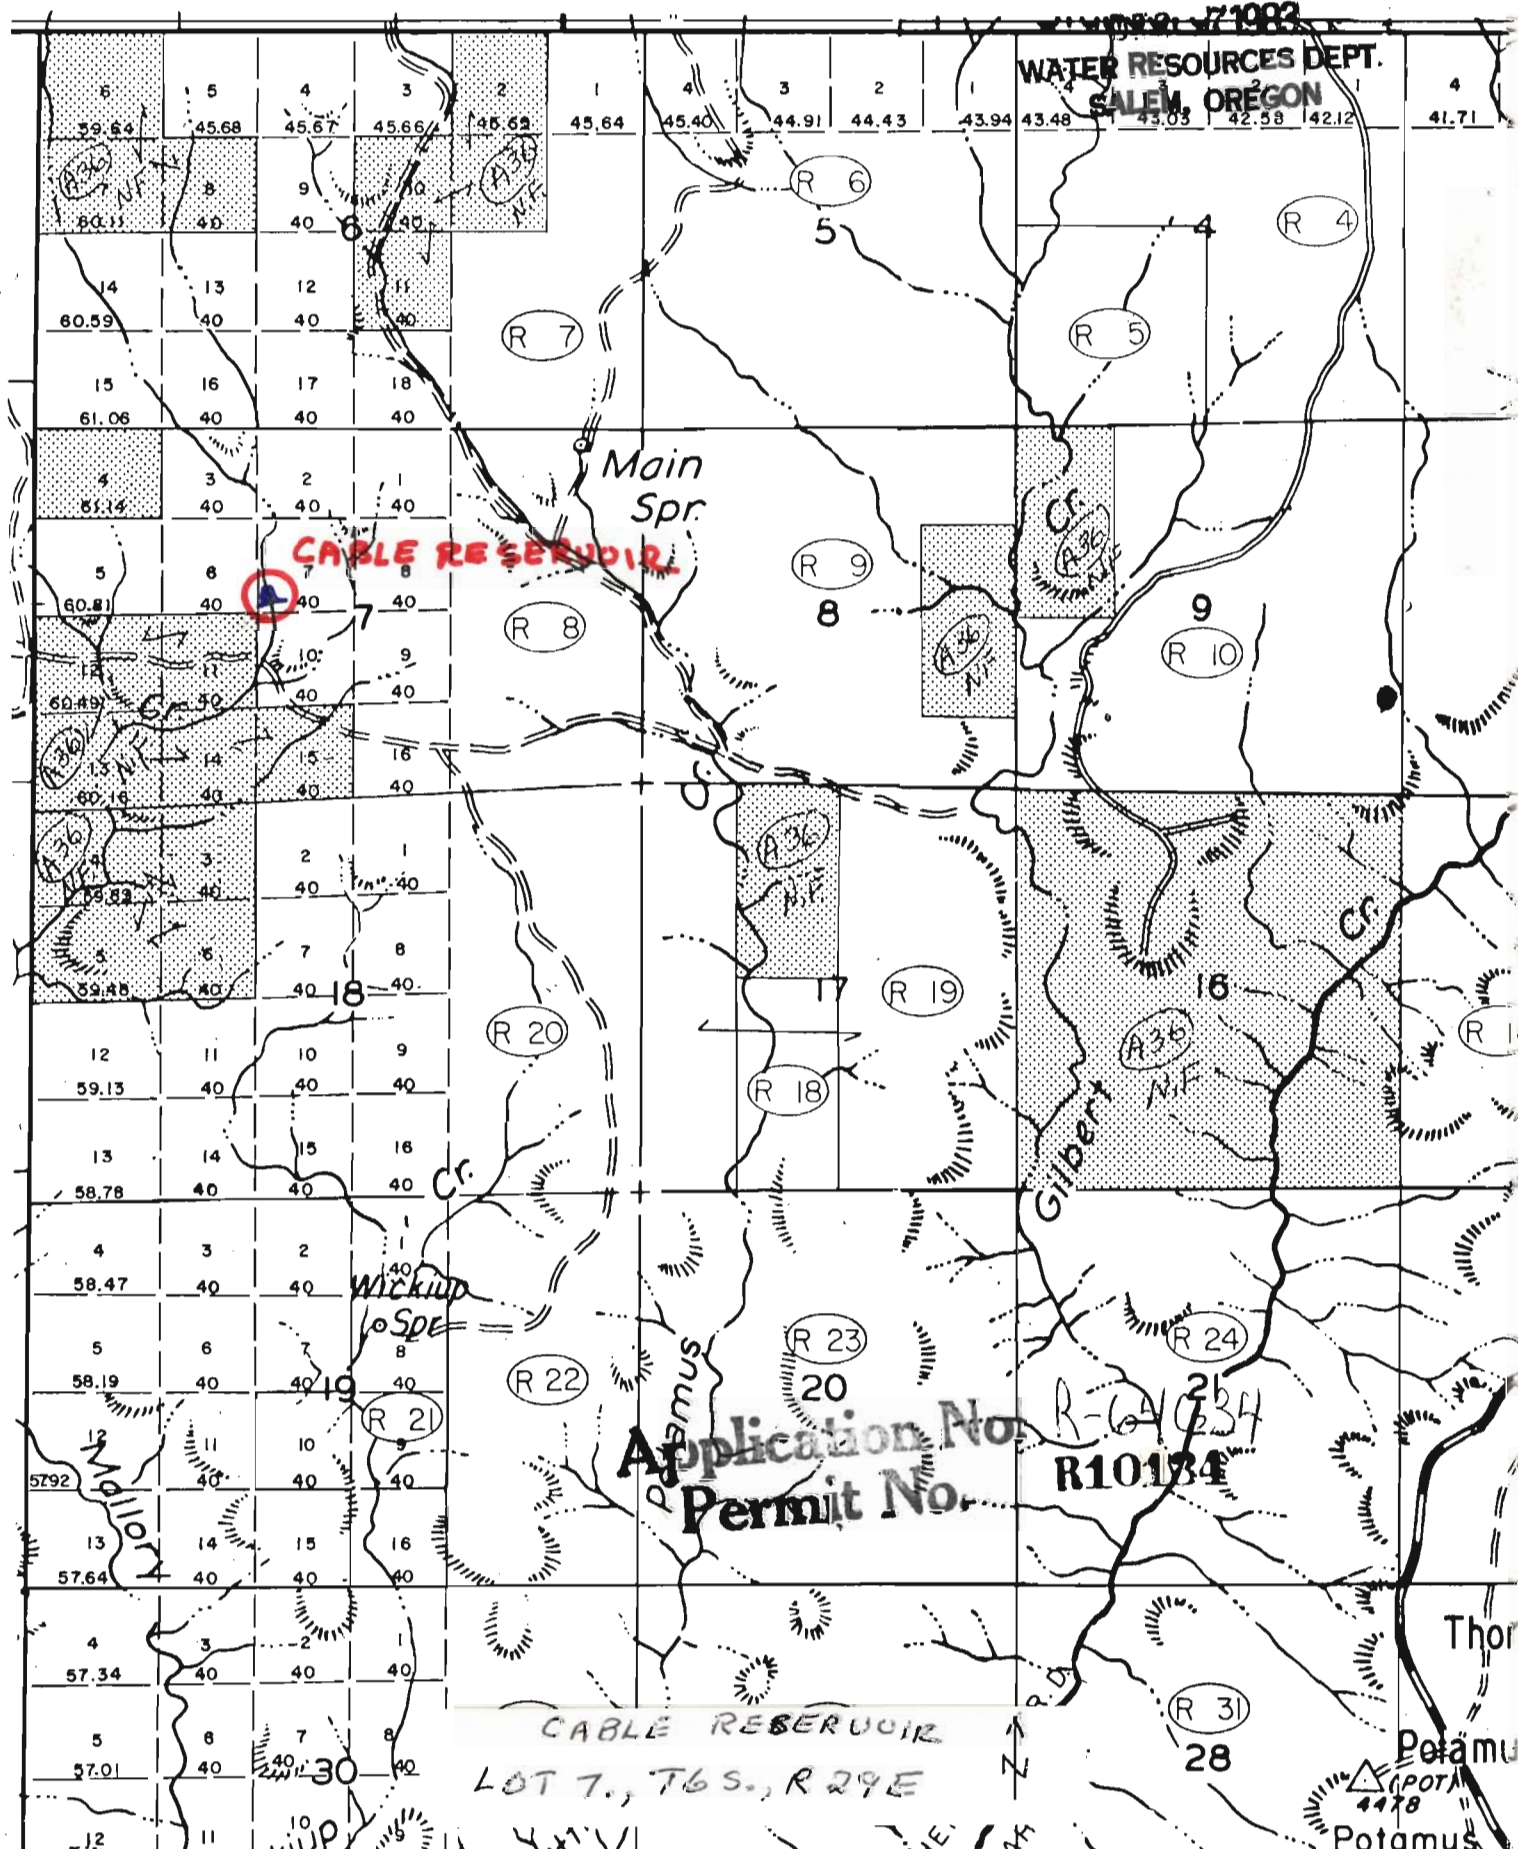


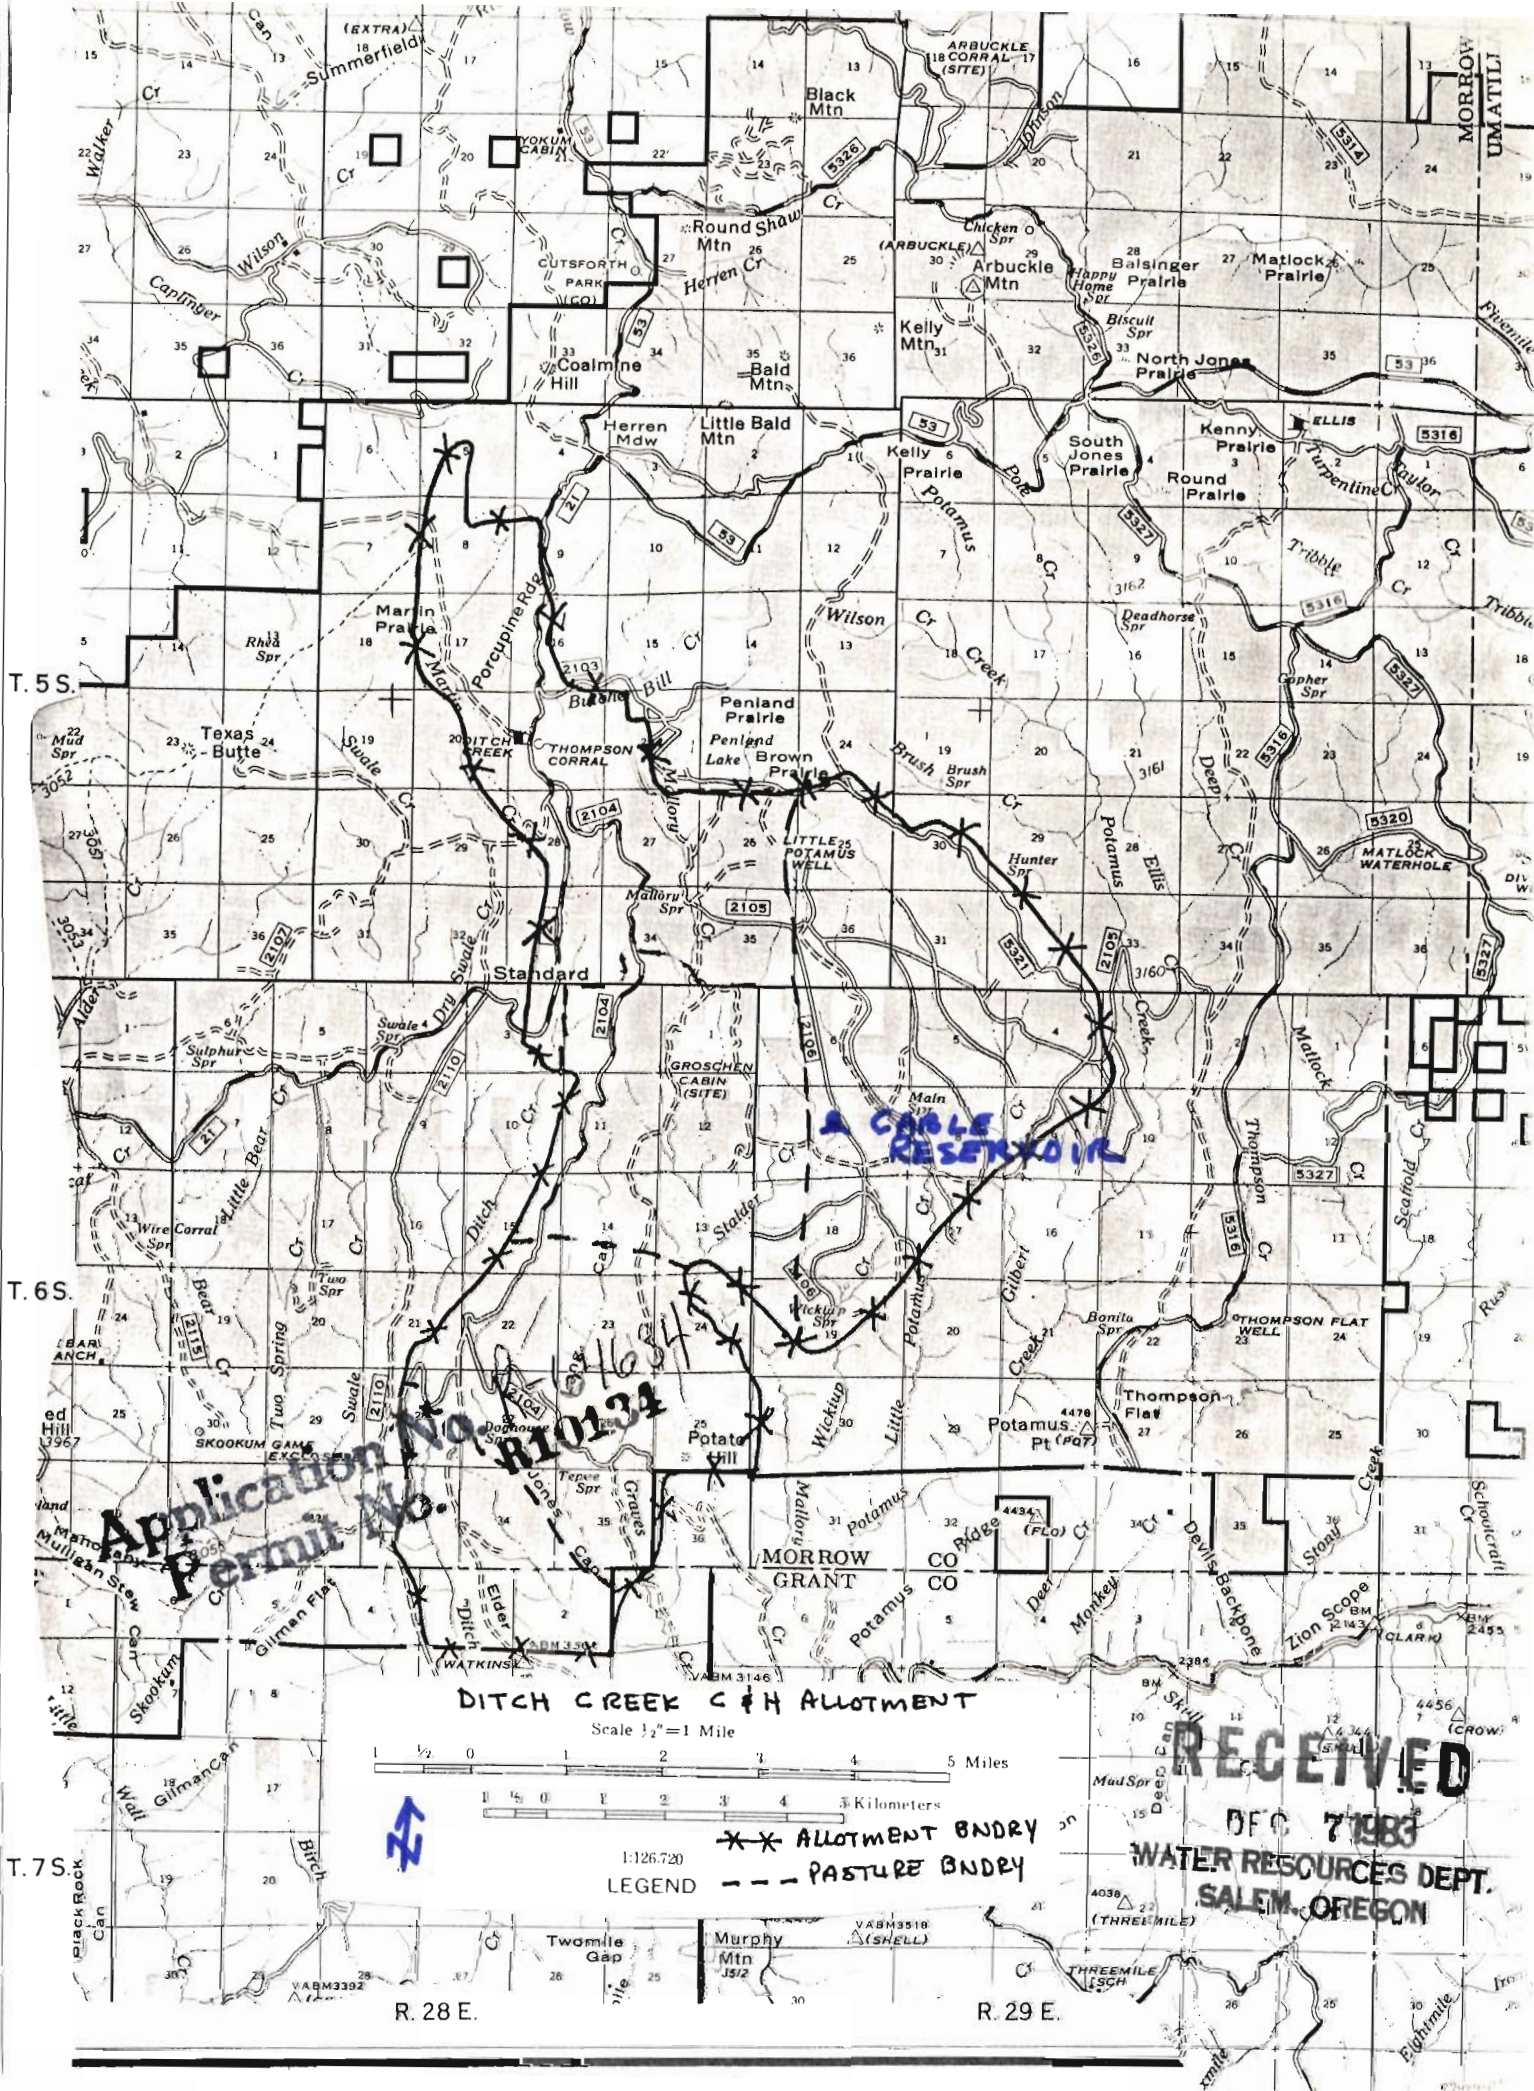

Application No. H10134
Permit No.

DITCH CREEK C & H ALLOTMENT

Scale 1/2"=1 Mile

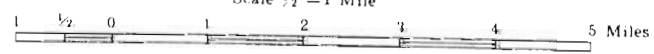

1:126,720
LEGEND

--- ALLOTMENT BNDRY
--- PASTURE BNDRY

RECEIVED
DEC 7 1983
WATER RESOURCES DEPT.
SALEM, OREGON