

RECEIVED

DEC 7 1983
WATER RESOURCES DEPT.
SALEM, OREGON

PUMPER
FILL
RESERVOIR

14


13

Application No. 64637
Permit No. R10135

23

24

PUMPER FILL RESERVOIR
T6S, R28E, Section 14, SE NE

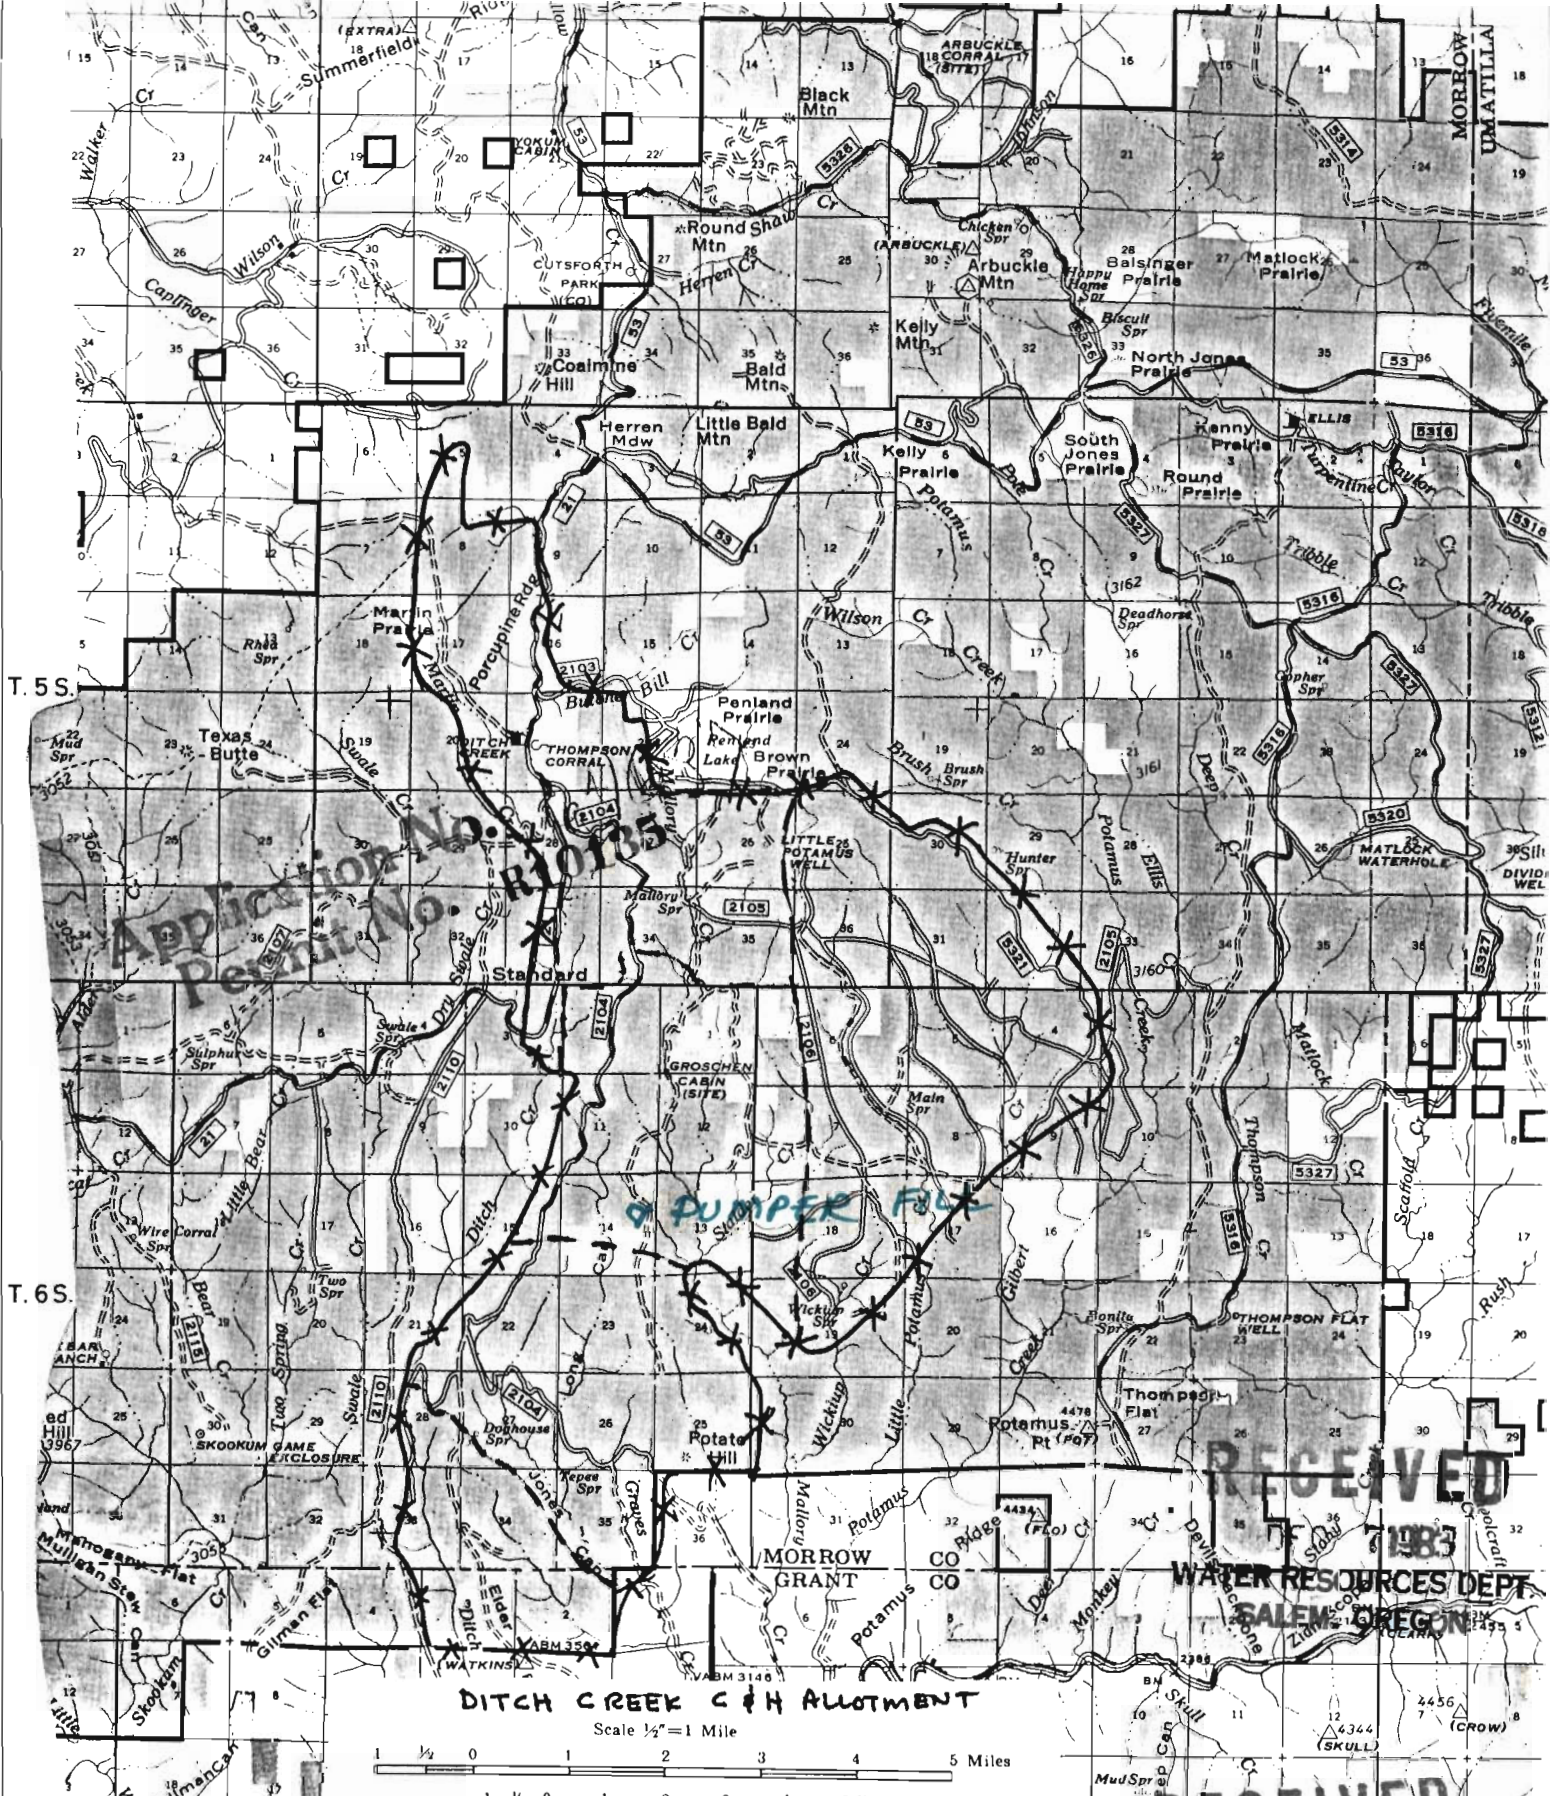

Application No. R-64637
Ditch Creek C & H Allotment

LEGEND
--- ALLOTMENT BNDRY
--- PASTURE BNDRY

RECEIVED
JAN 10 1983
WATER RESOURCES DEPT.
SALEM, OREGON

R. 28 E.

R. 29 E.