



MAP
SHOWING
WARNER WATER SYSTEM
IN
N.E. 1/4 of N.W. 1/4 SEC. 5-T.1 S.R.4E. OF THE W.M.
MULTNOMAH COUNTY OREGON
SCALE 1" = 200'

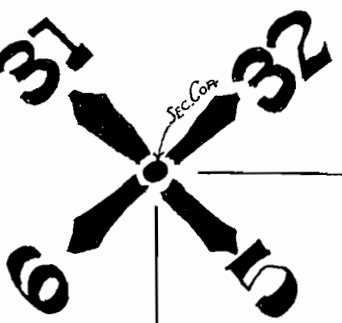


T.1 N. R.4 E. W.M.
T.1 S. R.4 E. W.M.

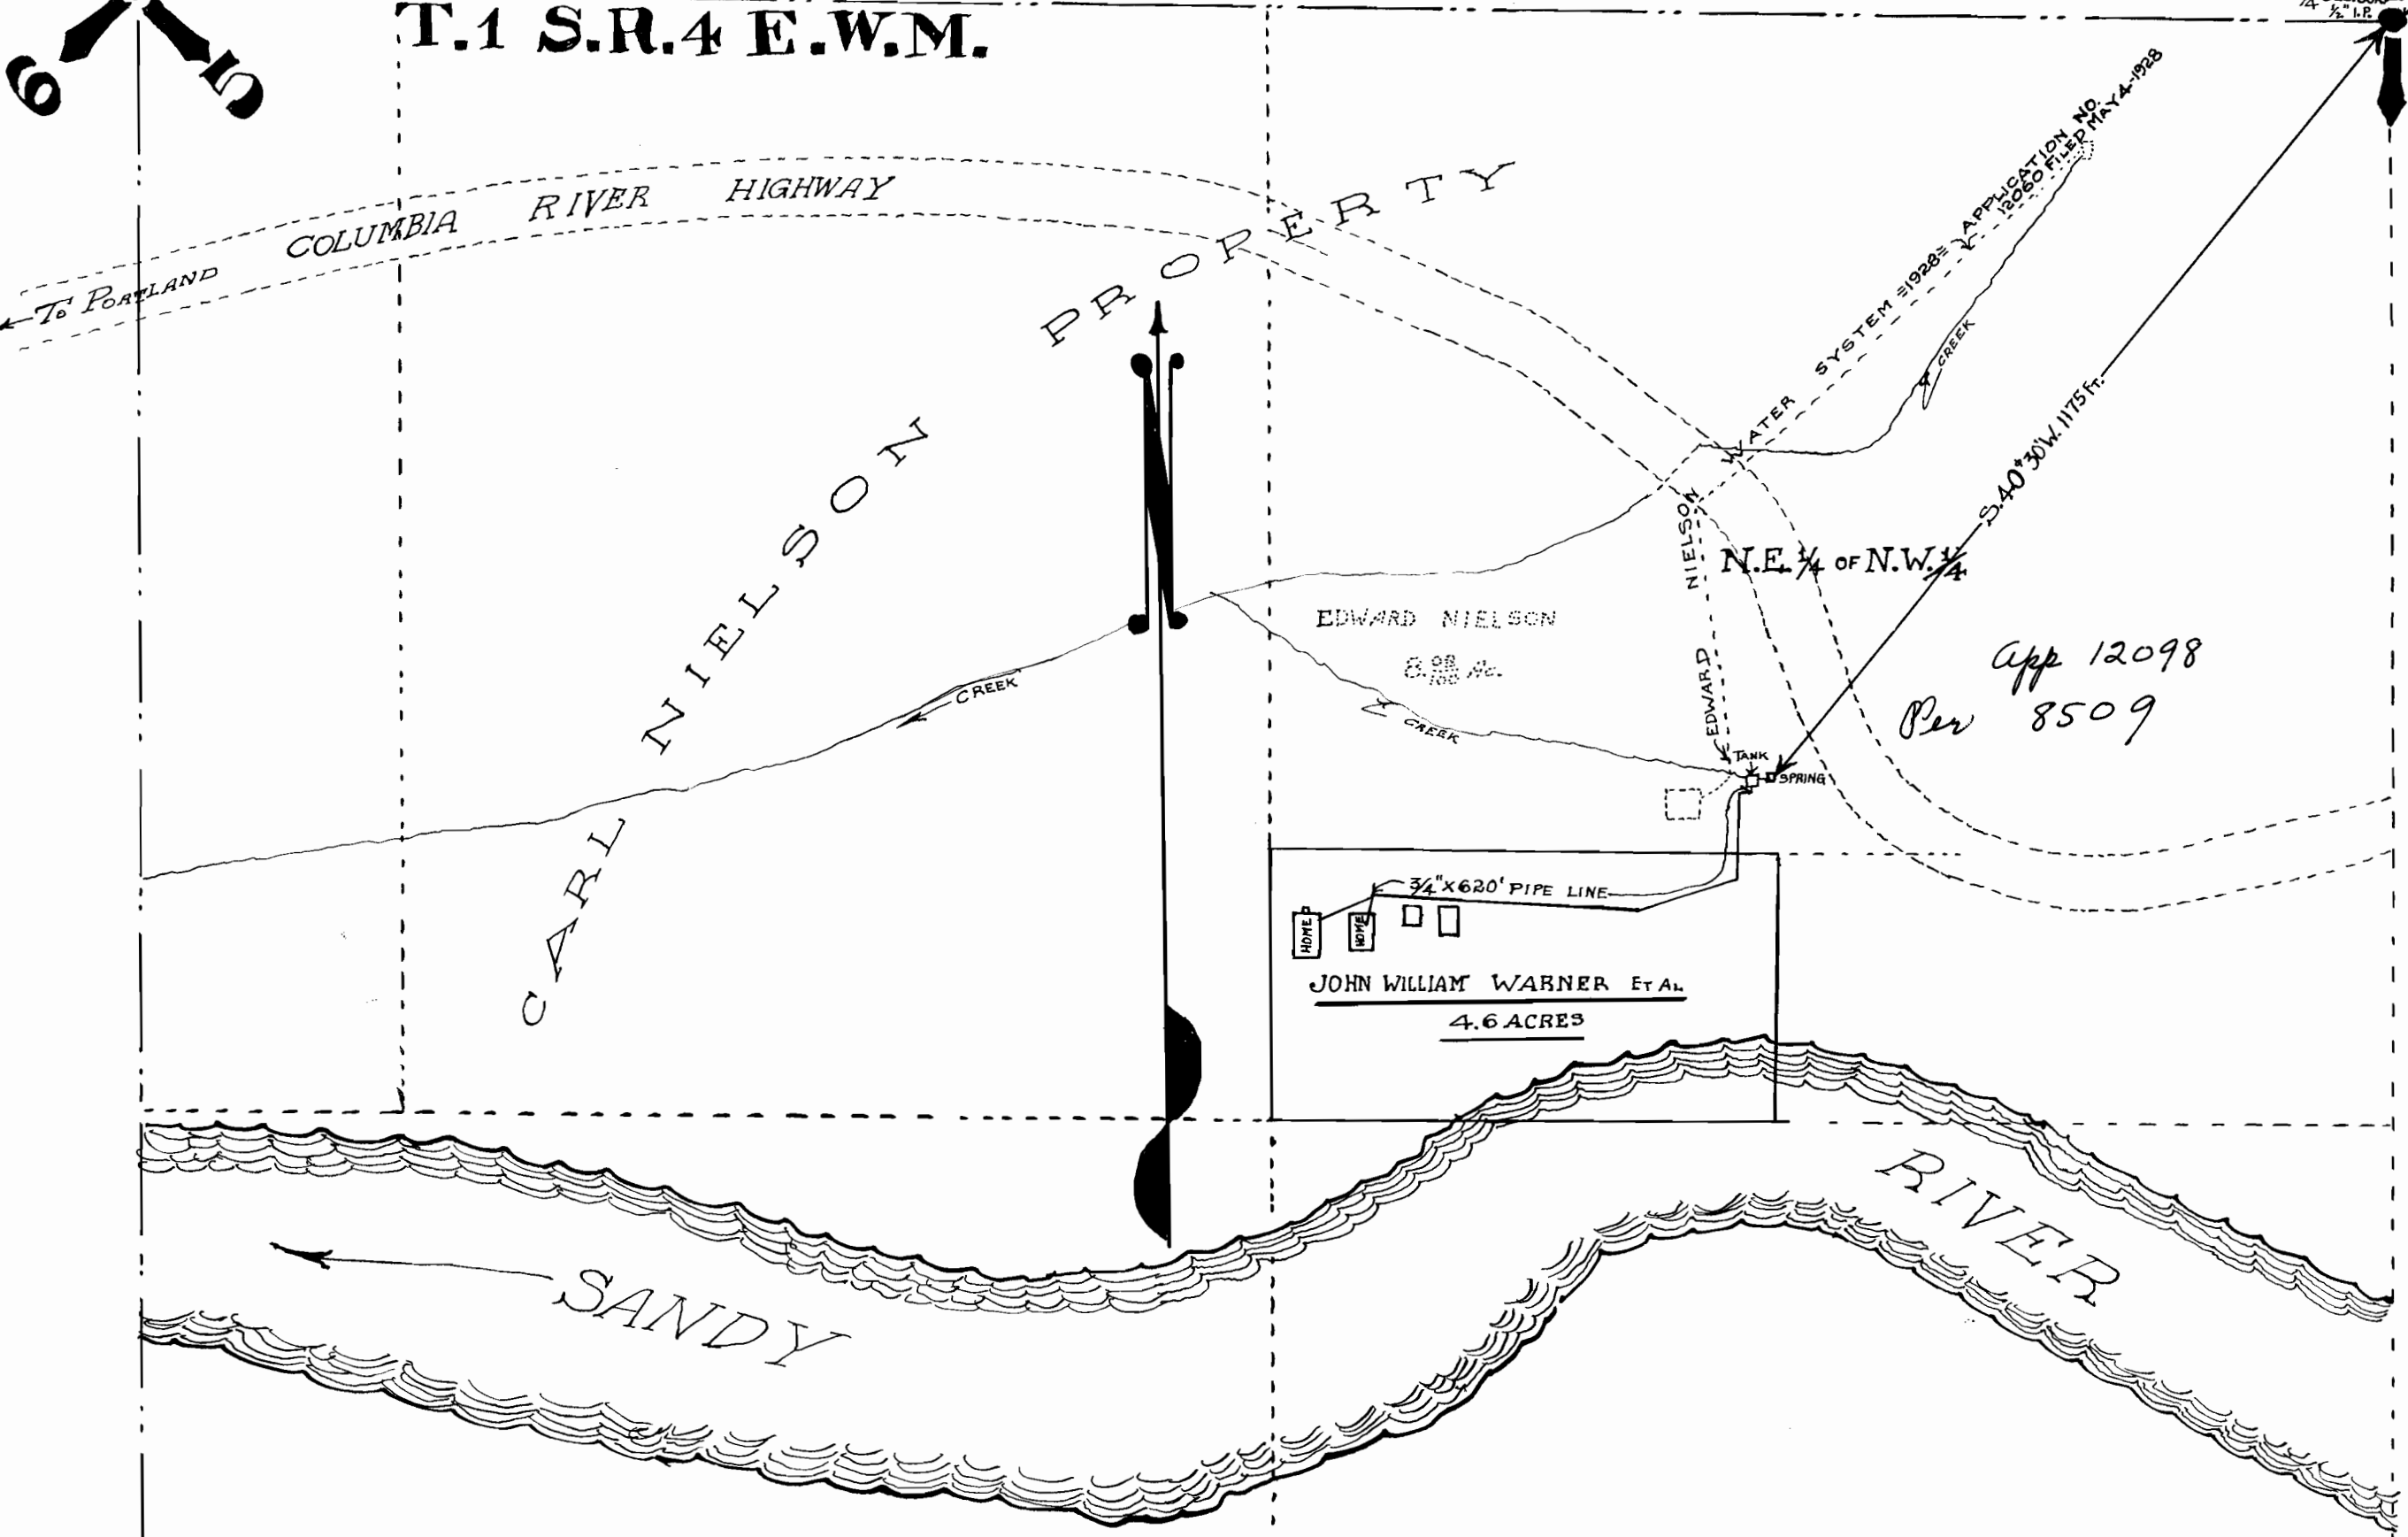

I, O.G. PORTER OF PORTLAND, OREGON, DO HEREBY CERTIFY,
THAT, THIS MAP WAS MADE FROM NOTES TAKEN DURING AN ACTUAL
SURVEY MADE BY ME IN MAY 1927 & MAY 1928 AND THAT IT
CORRECTLY REPRESENTS THE WORK DESCRIBED IN THE AC-
COMPANYING APPLICATION, TOGETHER WITH THE LOCATION OF
STREAMS, SPRINGS & DITCHES IN THE IMMEDIATE VICINITY.
O.G. Porter
REGISTERED PROFESSIONAL ENGINEER
OREGON No. 472
Nov. 25, 1919
(DATE OF REGISTRATION.)

Application No. 12098
Permit No. 8509

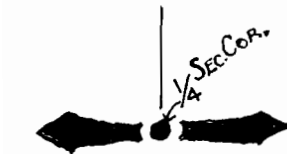

Gen. of Sec.