



Skookum
me Enclosure

Streak
Spring

REGISTERED


DEC 7 1983
WATER RESOURCES DEPT.
SALEM, OREGON

Application No. R-64652


T65
R28E

Flat

Gilman

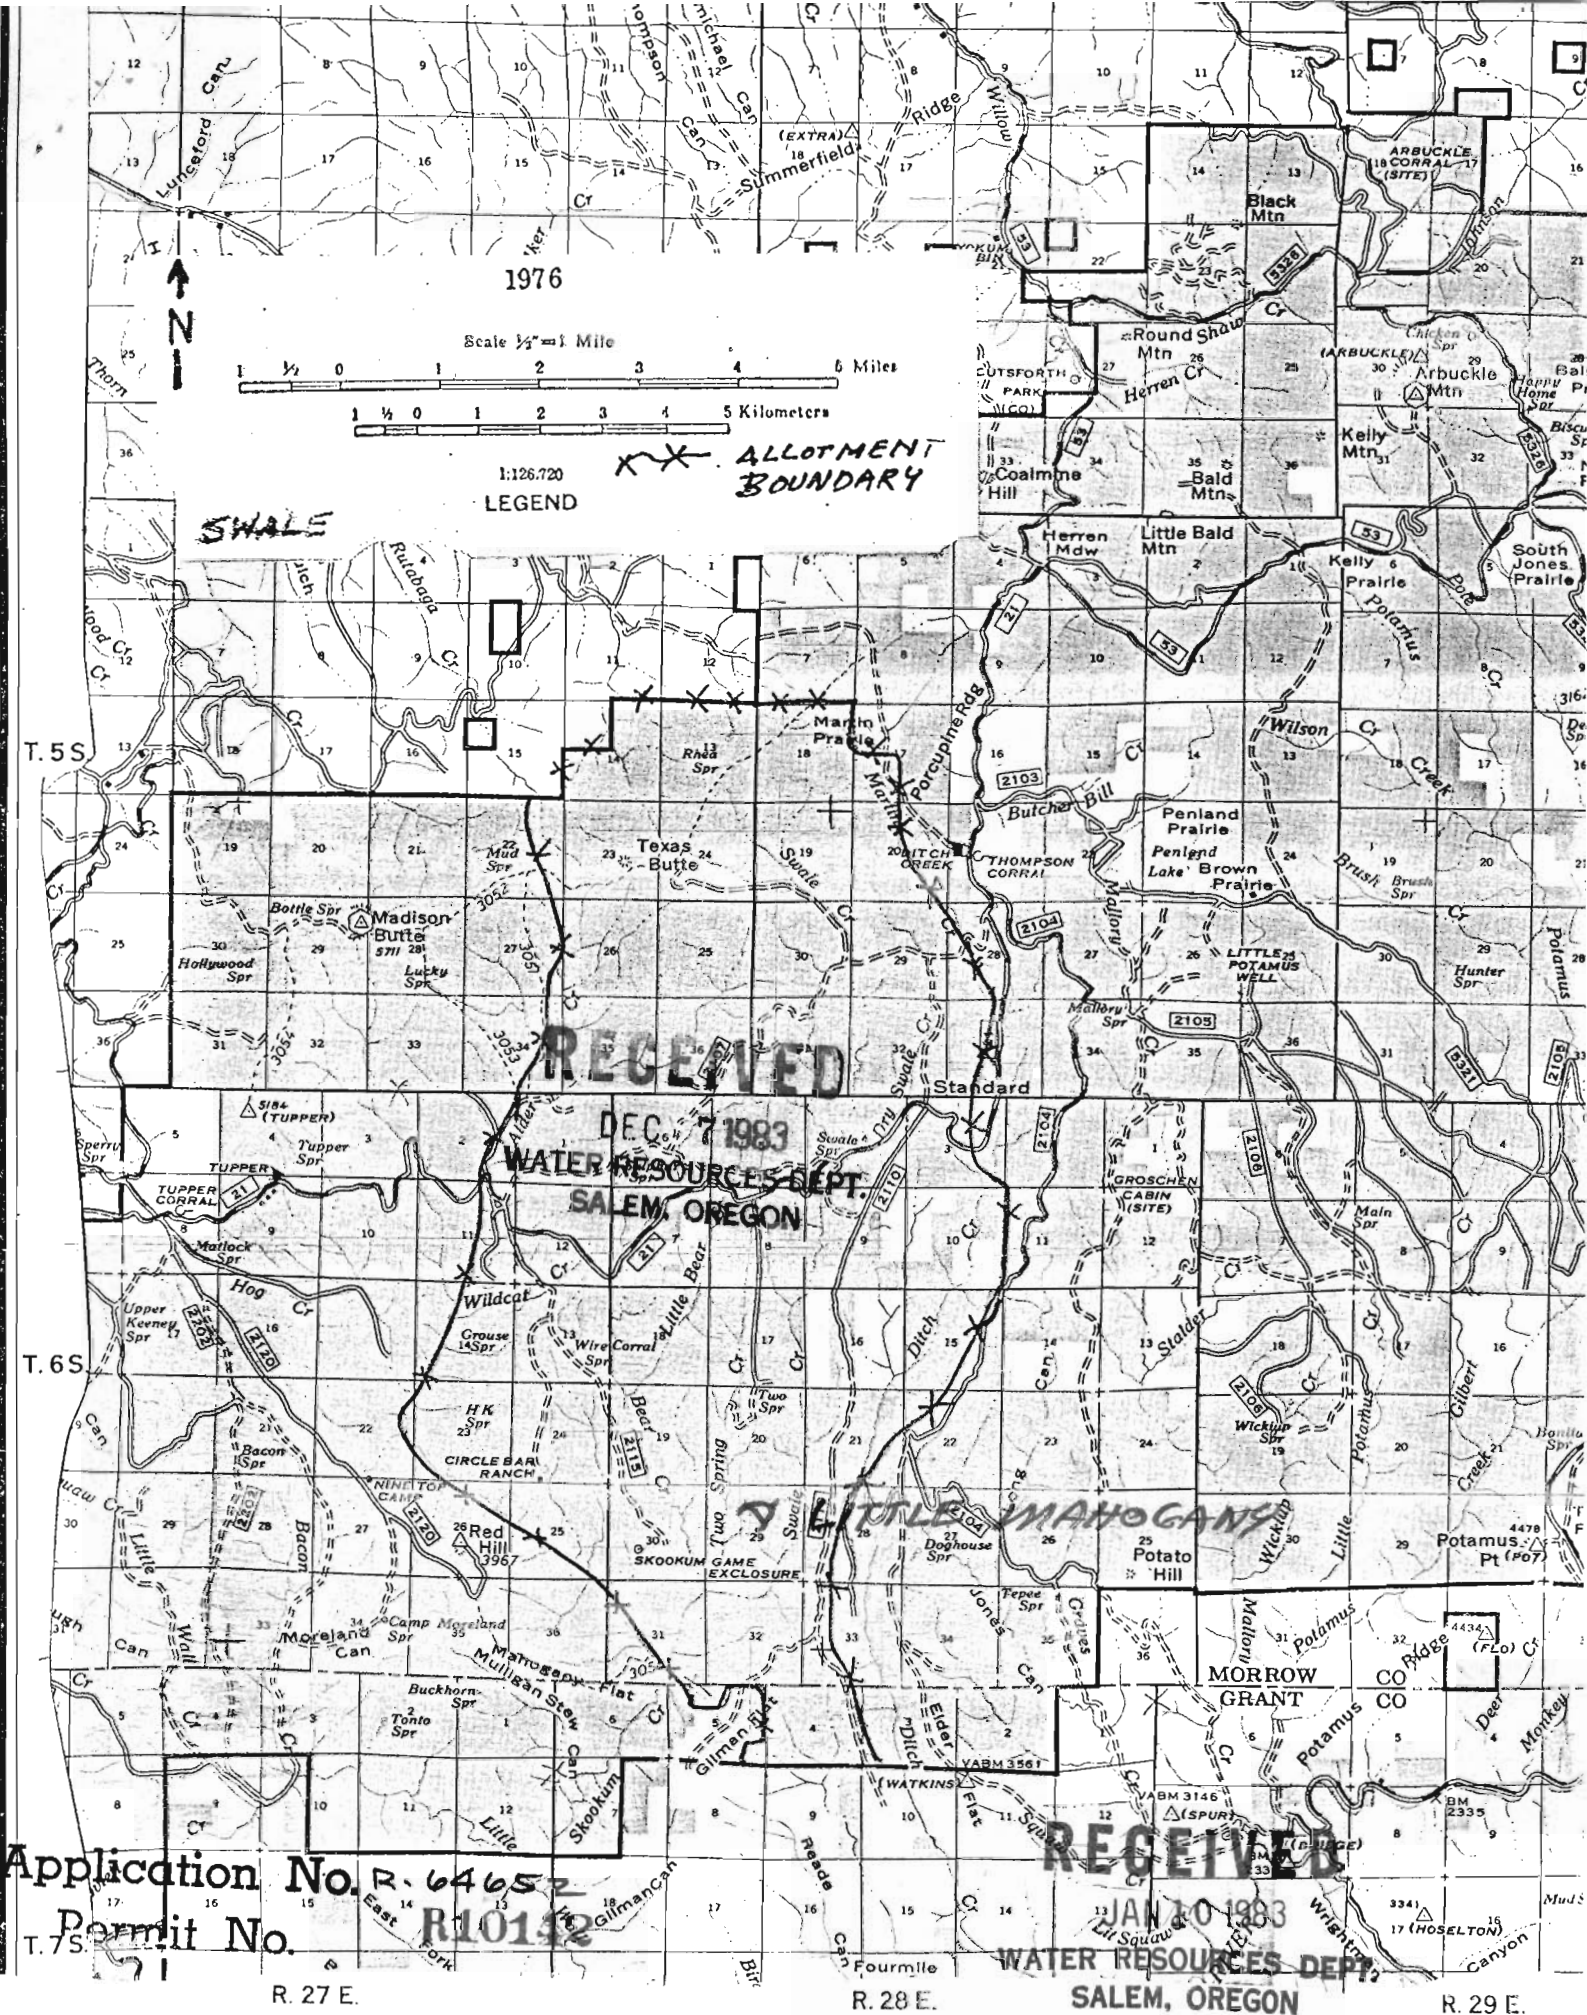

1

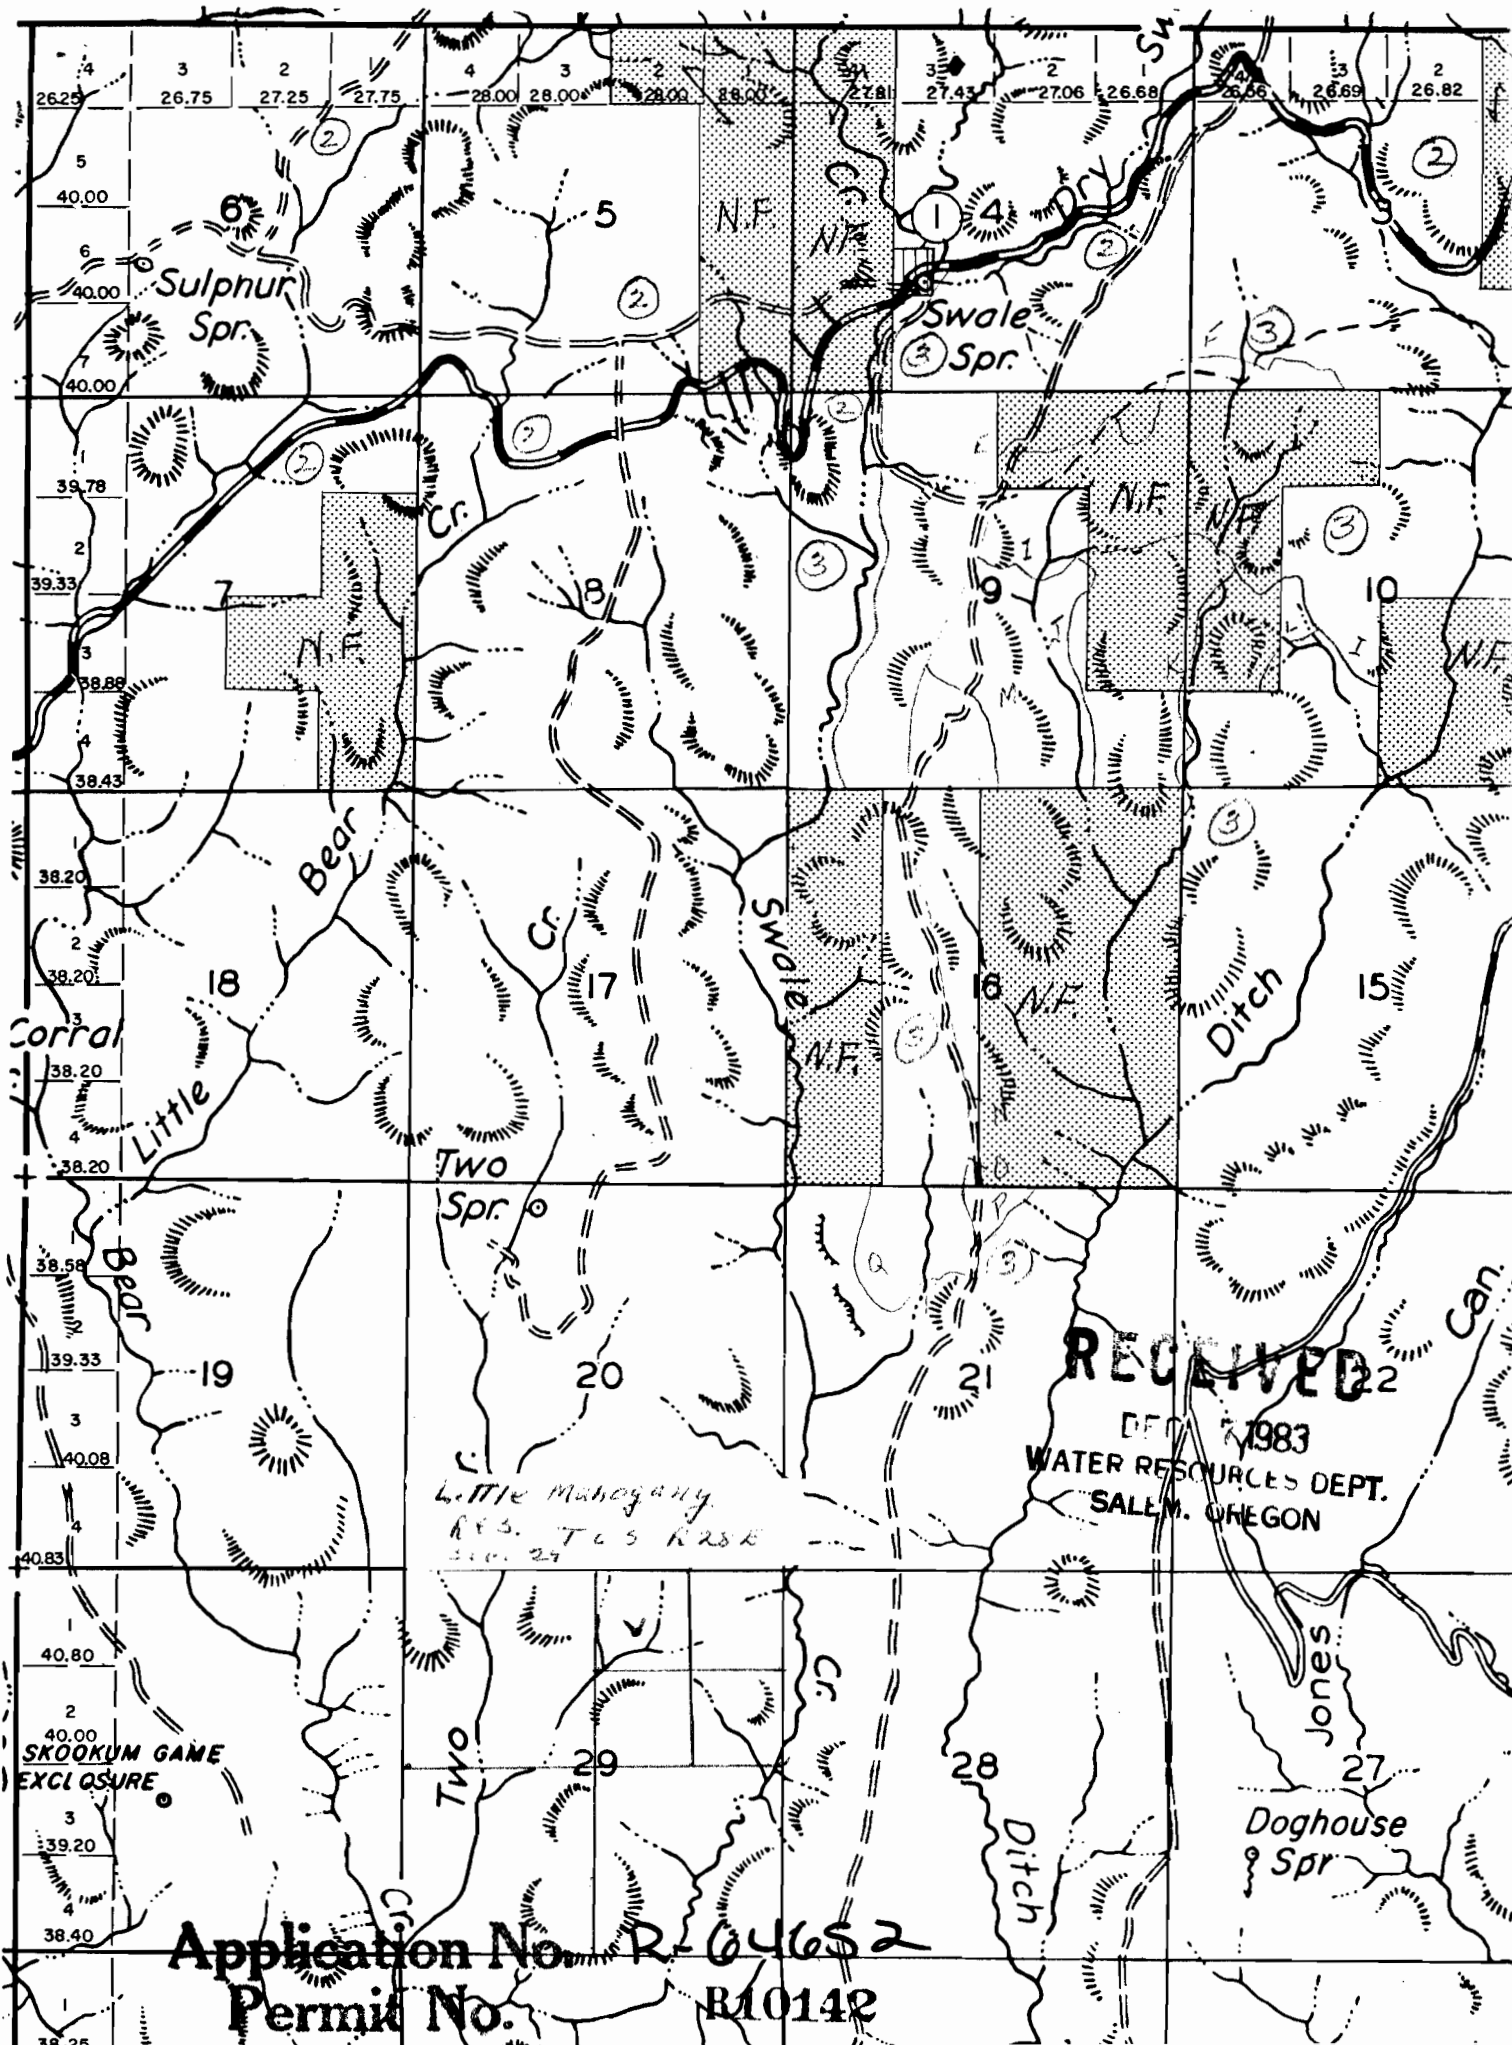


Application No. R-64652
Permit No. R10142

TOWNSHIP 6S, RANGE 28E, SECTION 29, W.M.

20

21

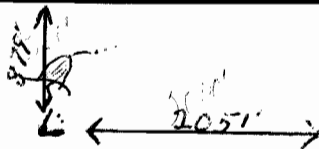

29

28

RECEIVED

DEC 7 1983
WATER RESOURCES DEPT.
SALEM, OREGON

NAME LITTLE MAHOGANY RES. COUNTY MORROW
Application No. R-64652
Permit No. R10142 6

RECEIVED

JAN 10 1983
WATER RESOURCES DEPT.
SALEM, OREGON