



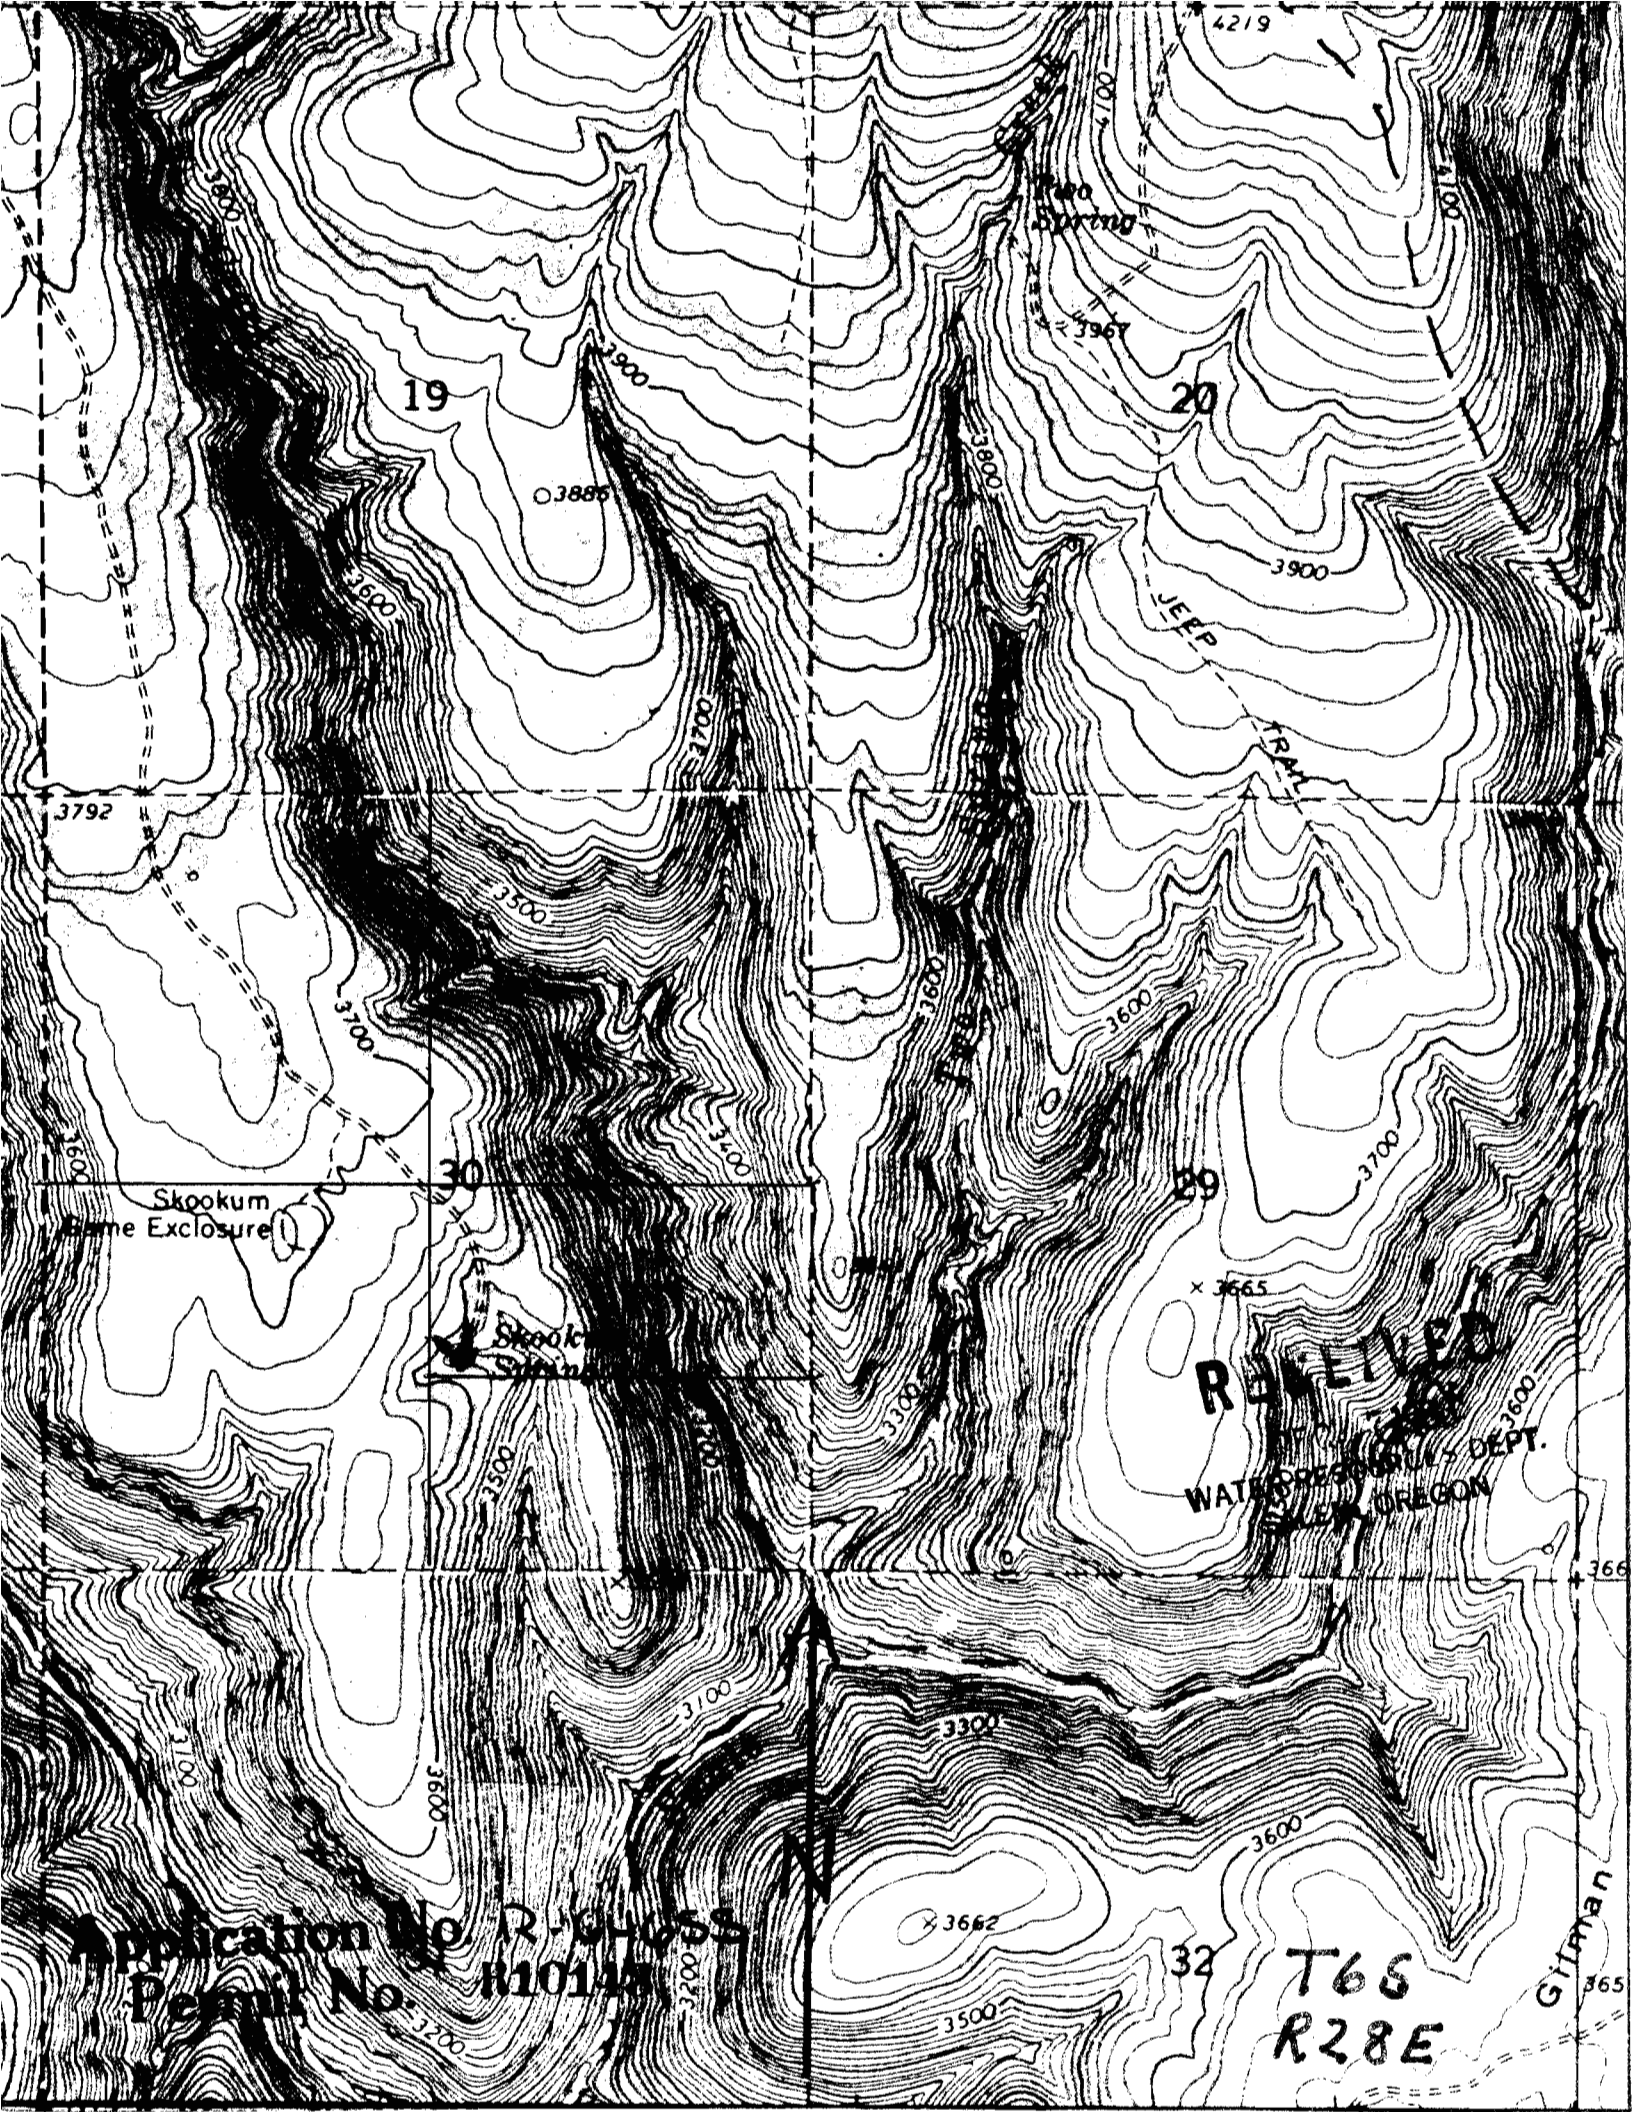

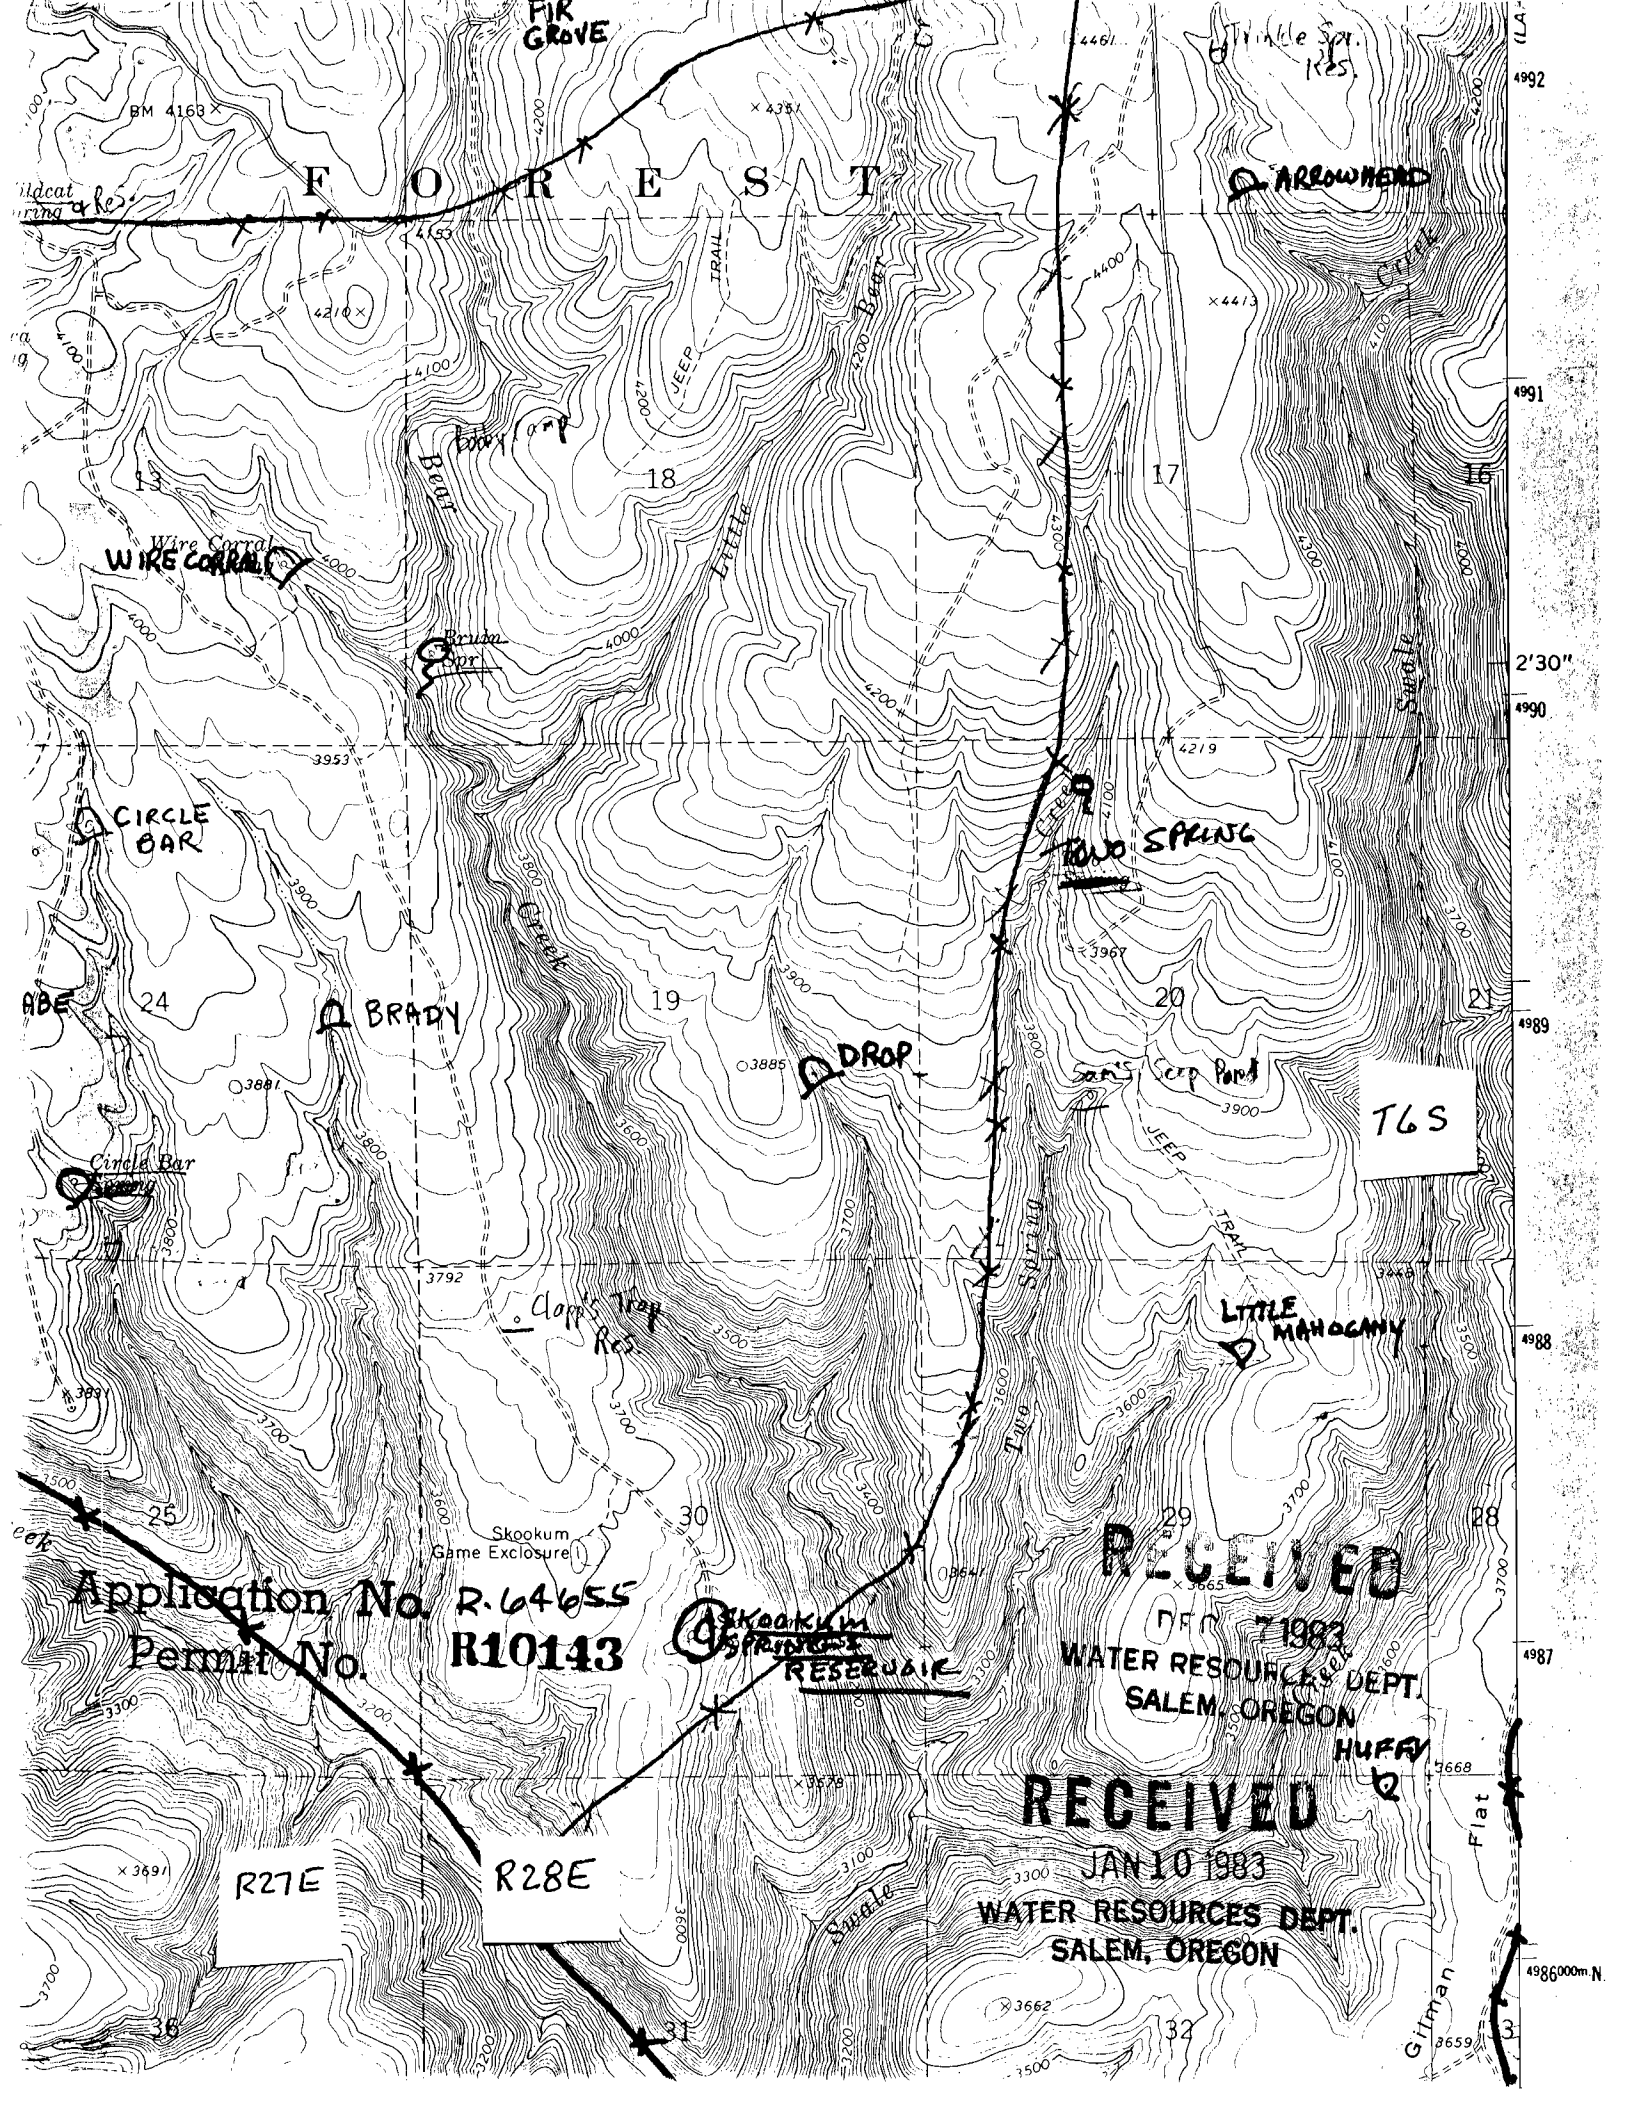

FOREST

FIR GROVE

ARROWHEAD

WIRE CORRAL

CIRCLE BAR

BRADY

DROP

SPRING

LITTLE MANOCANY

Clapp's Tray Res.

Skookum Game Enclosure

Skookum SPRINGS RESERVAIR

RECEIVED

WATER RESOURCES DEPT.
SALEM, OREGON

RECEIVED

JAN 10 1983
WATER RESOURCES DEPT.
SALEM, OREGON

R27E

R28E

HUFFY

Flat

Gilman


4986000m N

Application No. R.64655
Permit No. R10143


1976

Scale 1/2" = 1 Mile

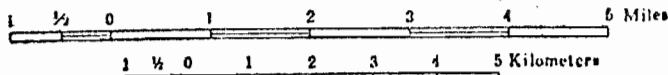

1:126,720

LEGEND

XX ALLOTMENT BOUNDARY

SWALE

T. 5 S.

T. 6 S.

T. 7 S.

R. 27 E.

R. 28 E.

R. 29 E.

Application No. R-64655

Permit No. R10148


RECEIVED
DEC 7 1983

WATER RESOURCES DEPT.
SALEM, OREGON
MORROW GRANT

RECEIVED

JAN 10 1983

WATER RESOURCES DEPT.
SALEM, OREGON

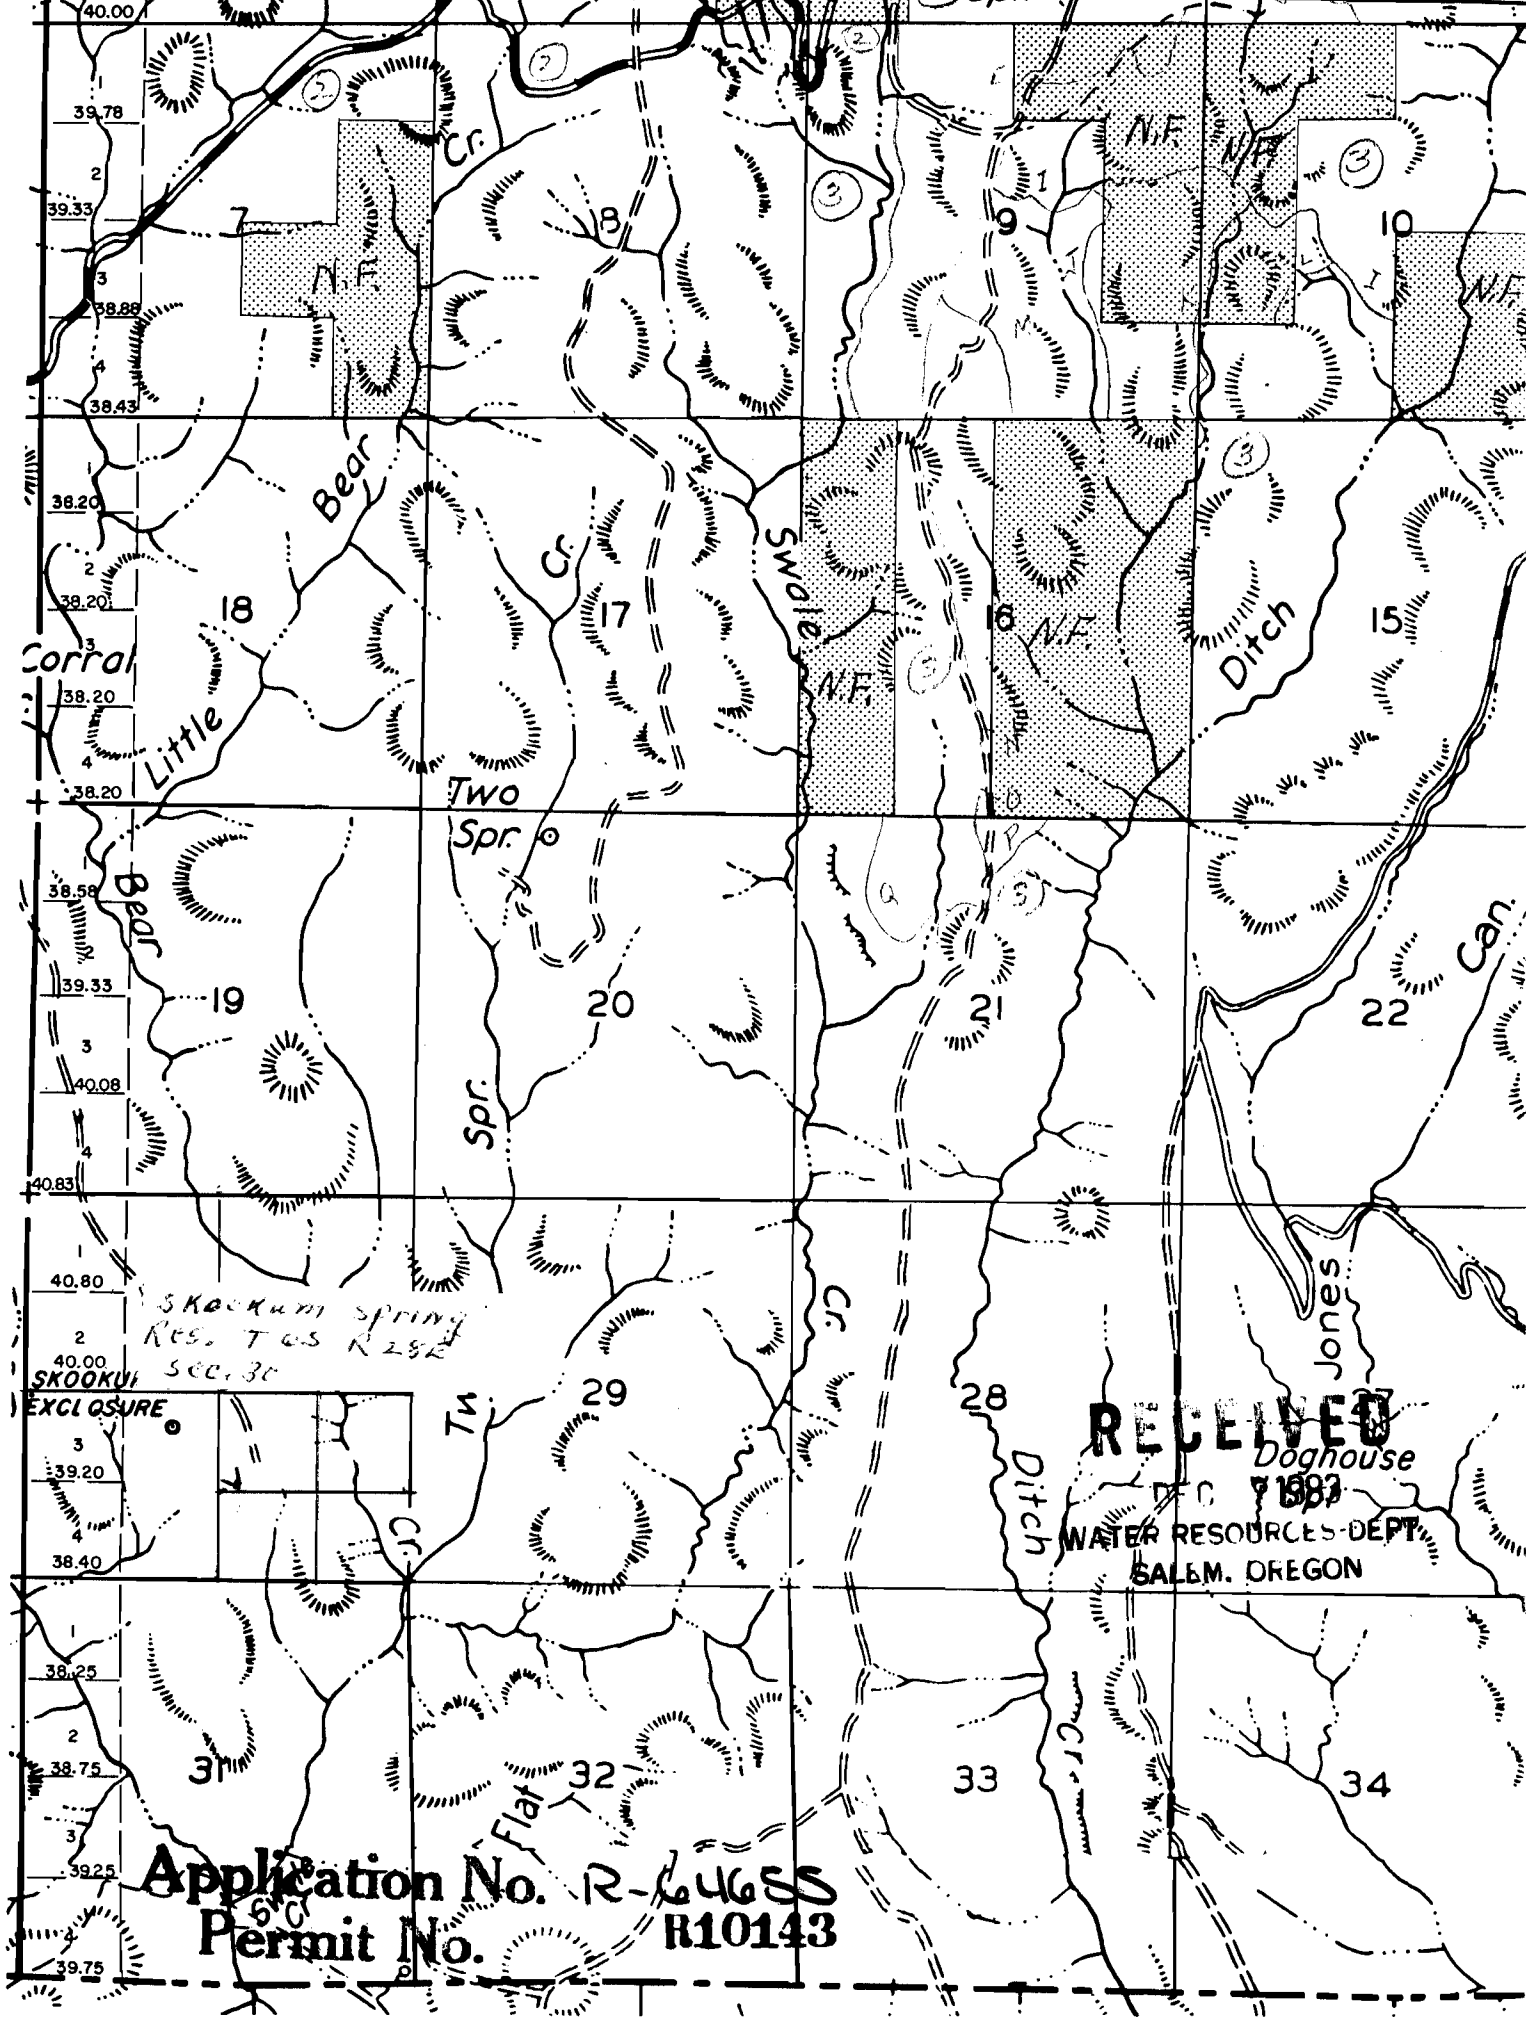


Permit No. R10143

RECEIVED
Doghouse
WATER RESOURCES DEPT.
SALEM, OREGON

TOWNSHIP 6S, RANGE 28E, SECTION 30, W.M.

30

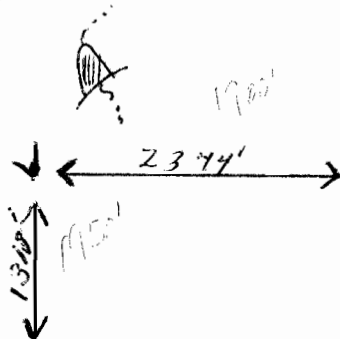

29

31

32

RECEIVED

DEC 7 1983
WATER RESOURCES DEPT.
SALEM, OREGON

NAME SKOOKUM SPRING RES. COUNTY MORROW

RECEIVED

JAN 10 1983

WATER RESOURCES DEPT.
SALEM, OREGON

Application No. R-64655

Permit No. R10143

9