

Drop Res.  
T6S R28E sec. 19

Q3885

Tree Spring

JEEP


TRAIL


Skookum  
Game Enclosure


Skookum  
Spring

RECEIVED  
MAY 7 1985  
WATER RESOURCES DEPT.  
SALEM, OREGON


Application No. R-64657  
Permit No. R10115

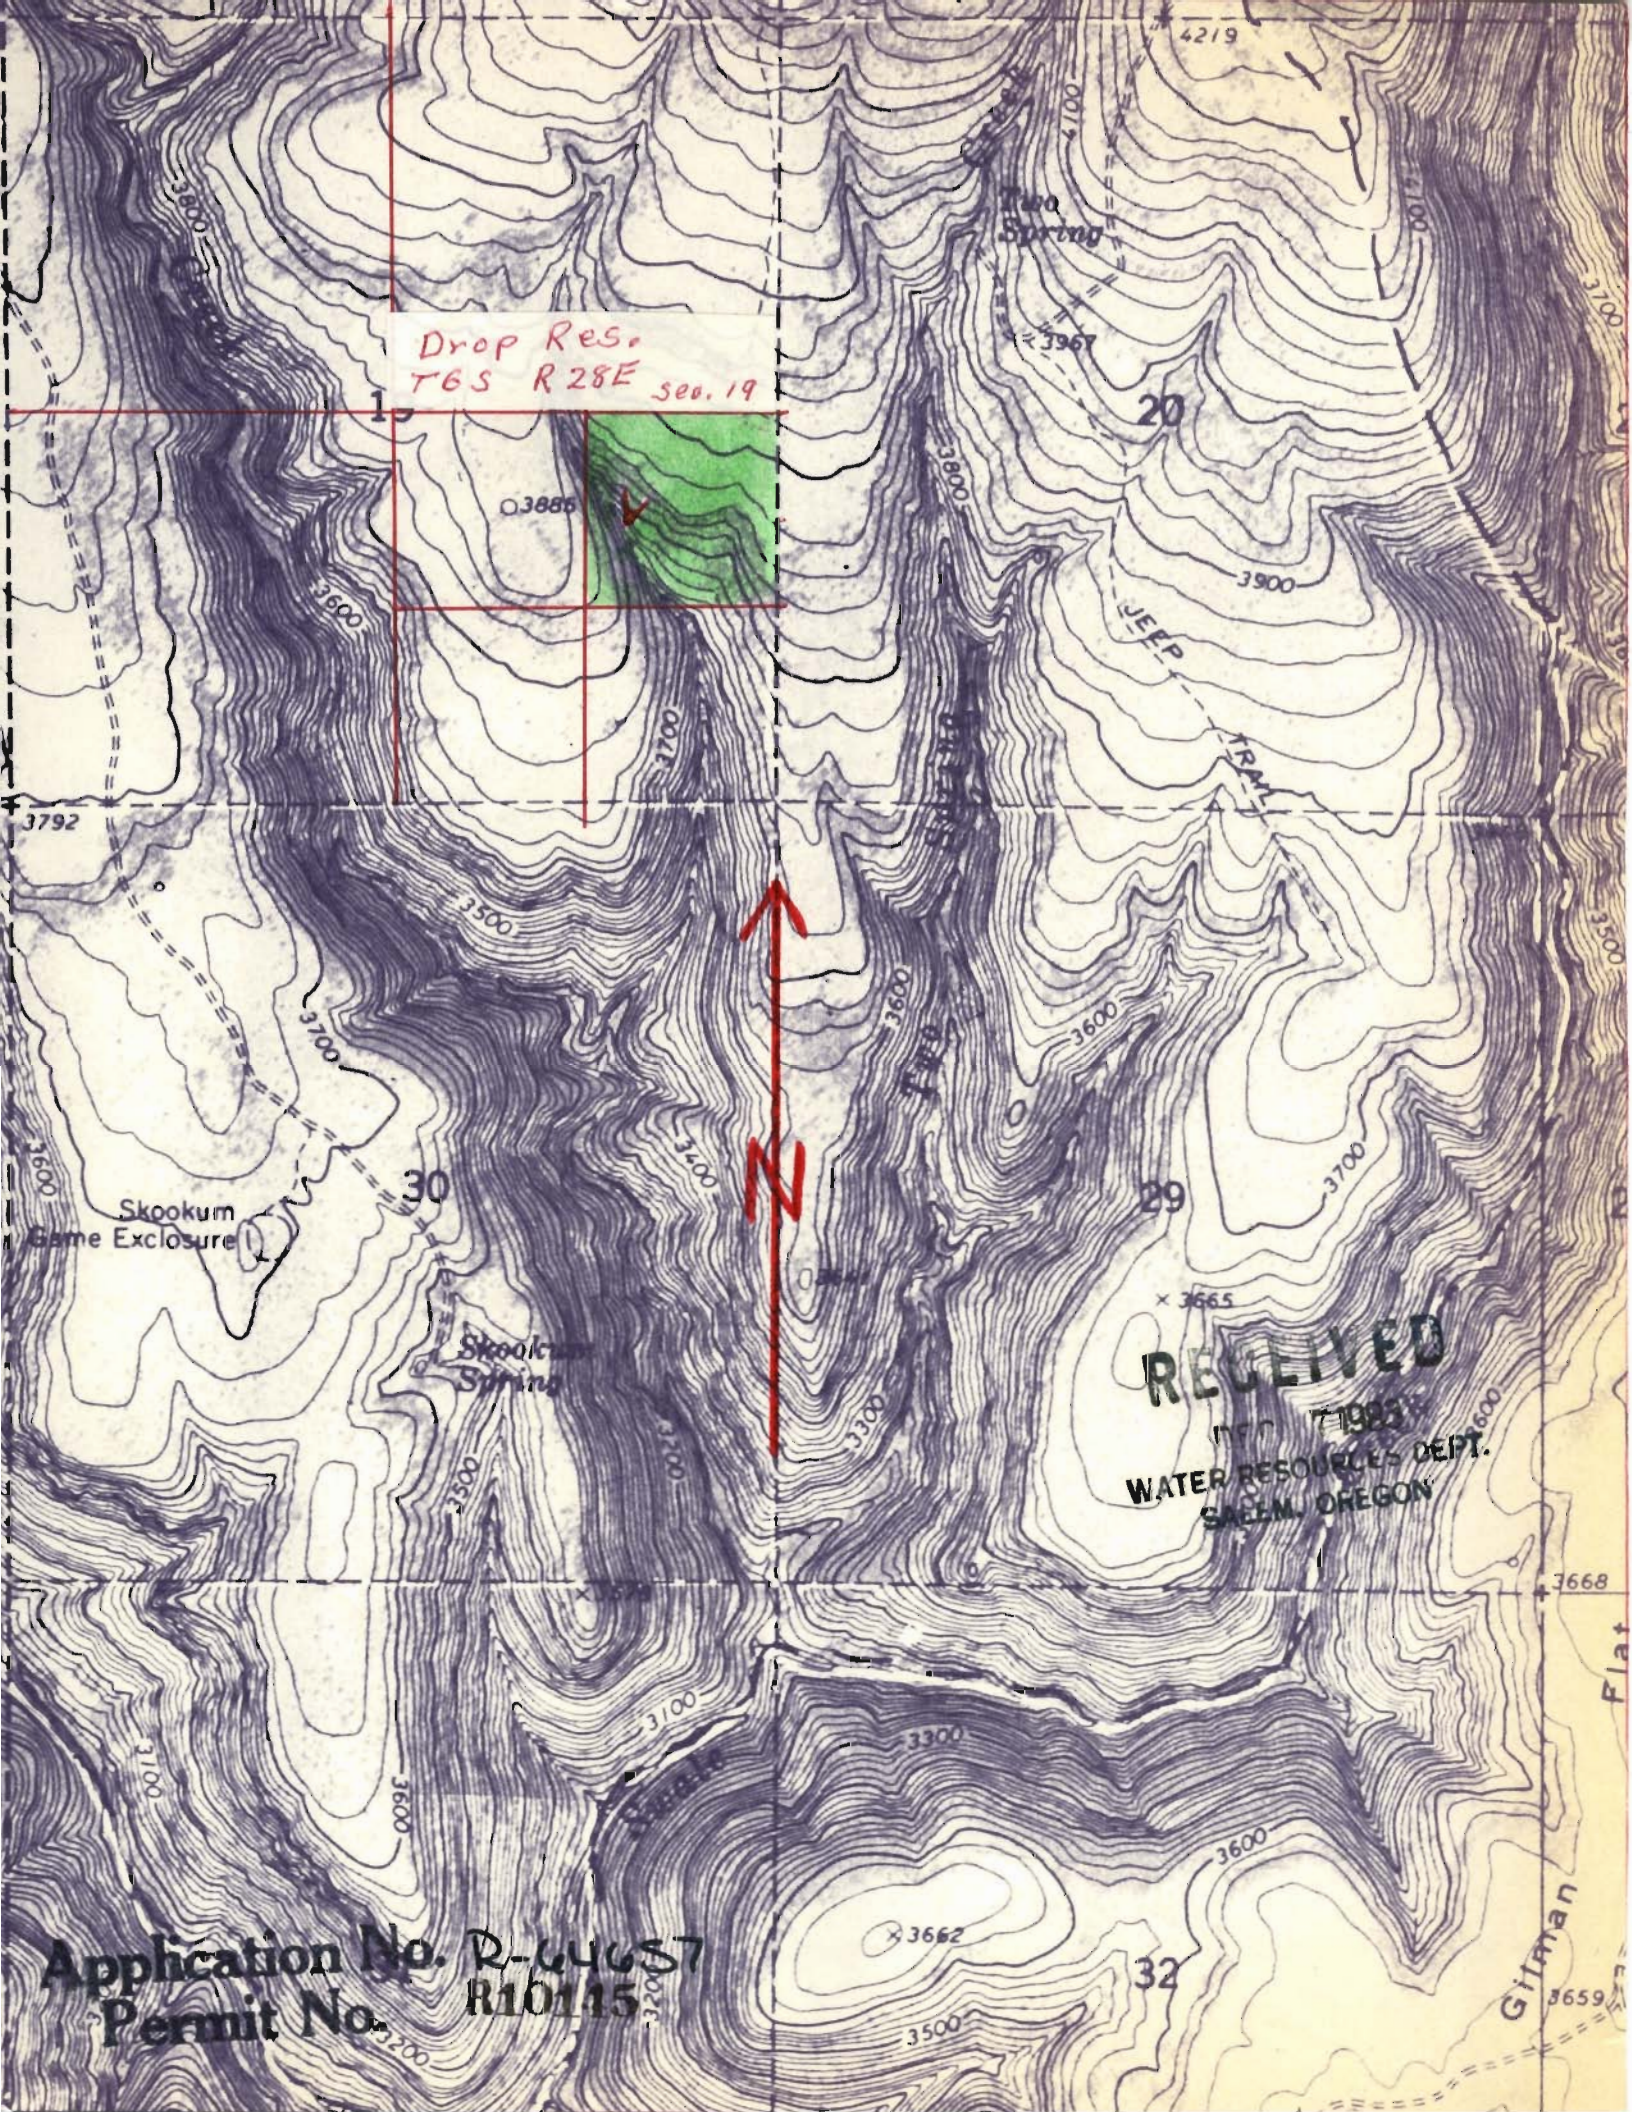

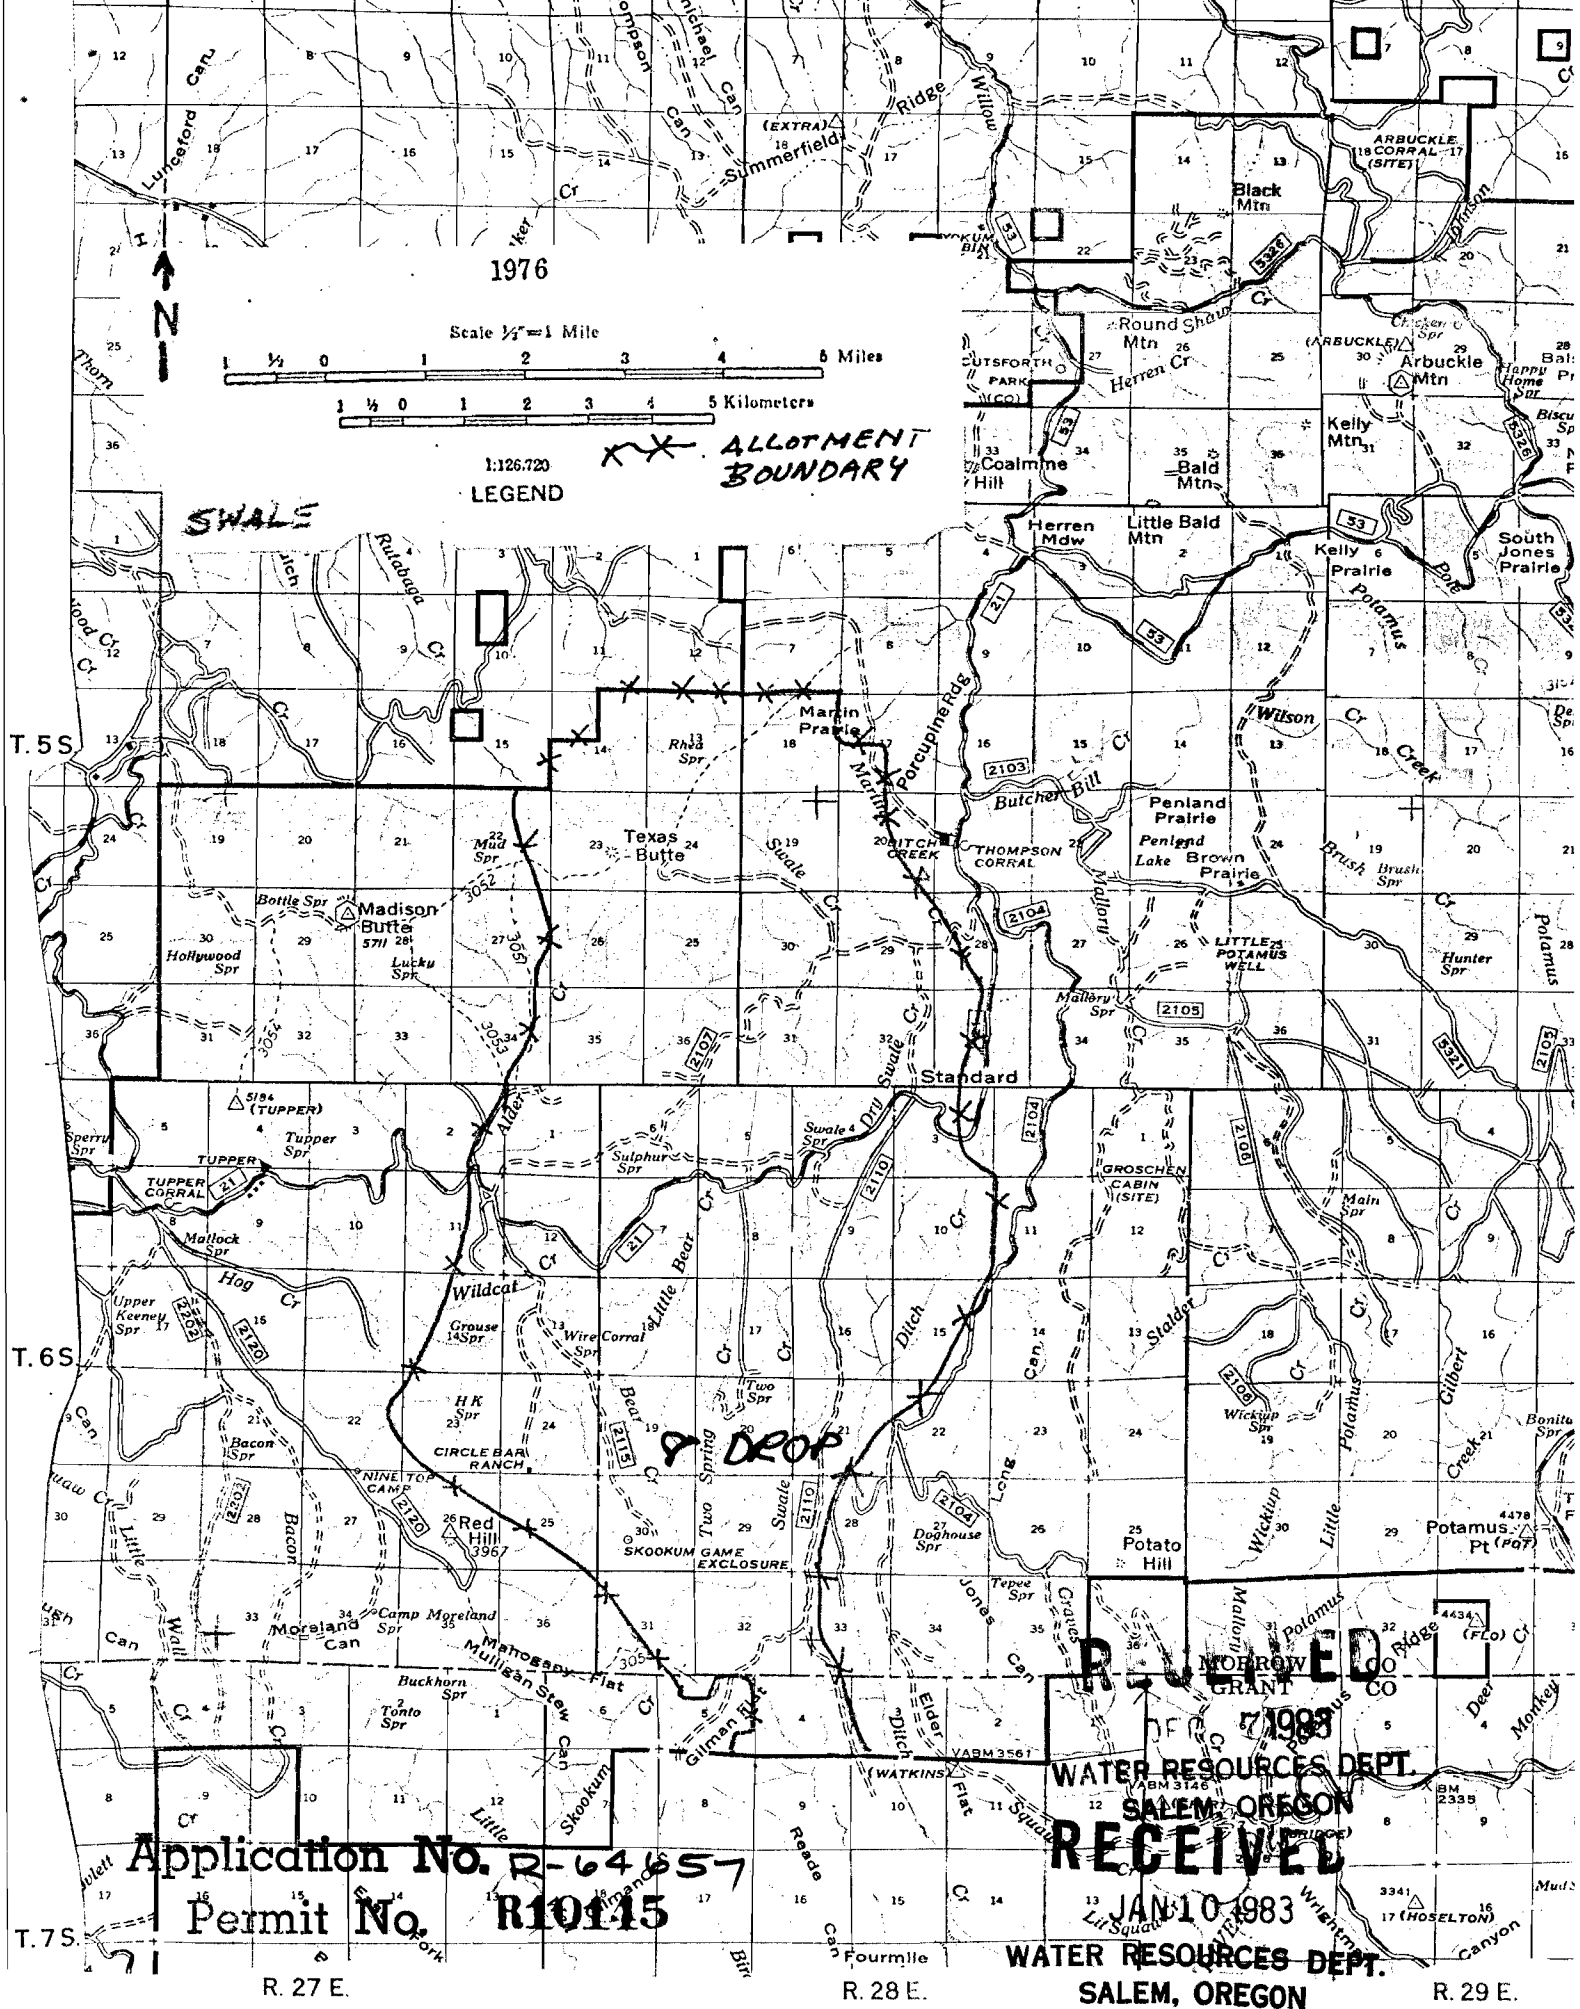

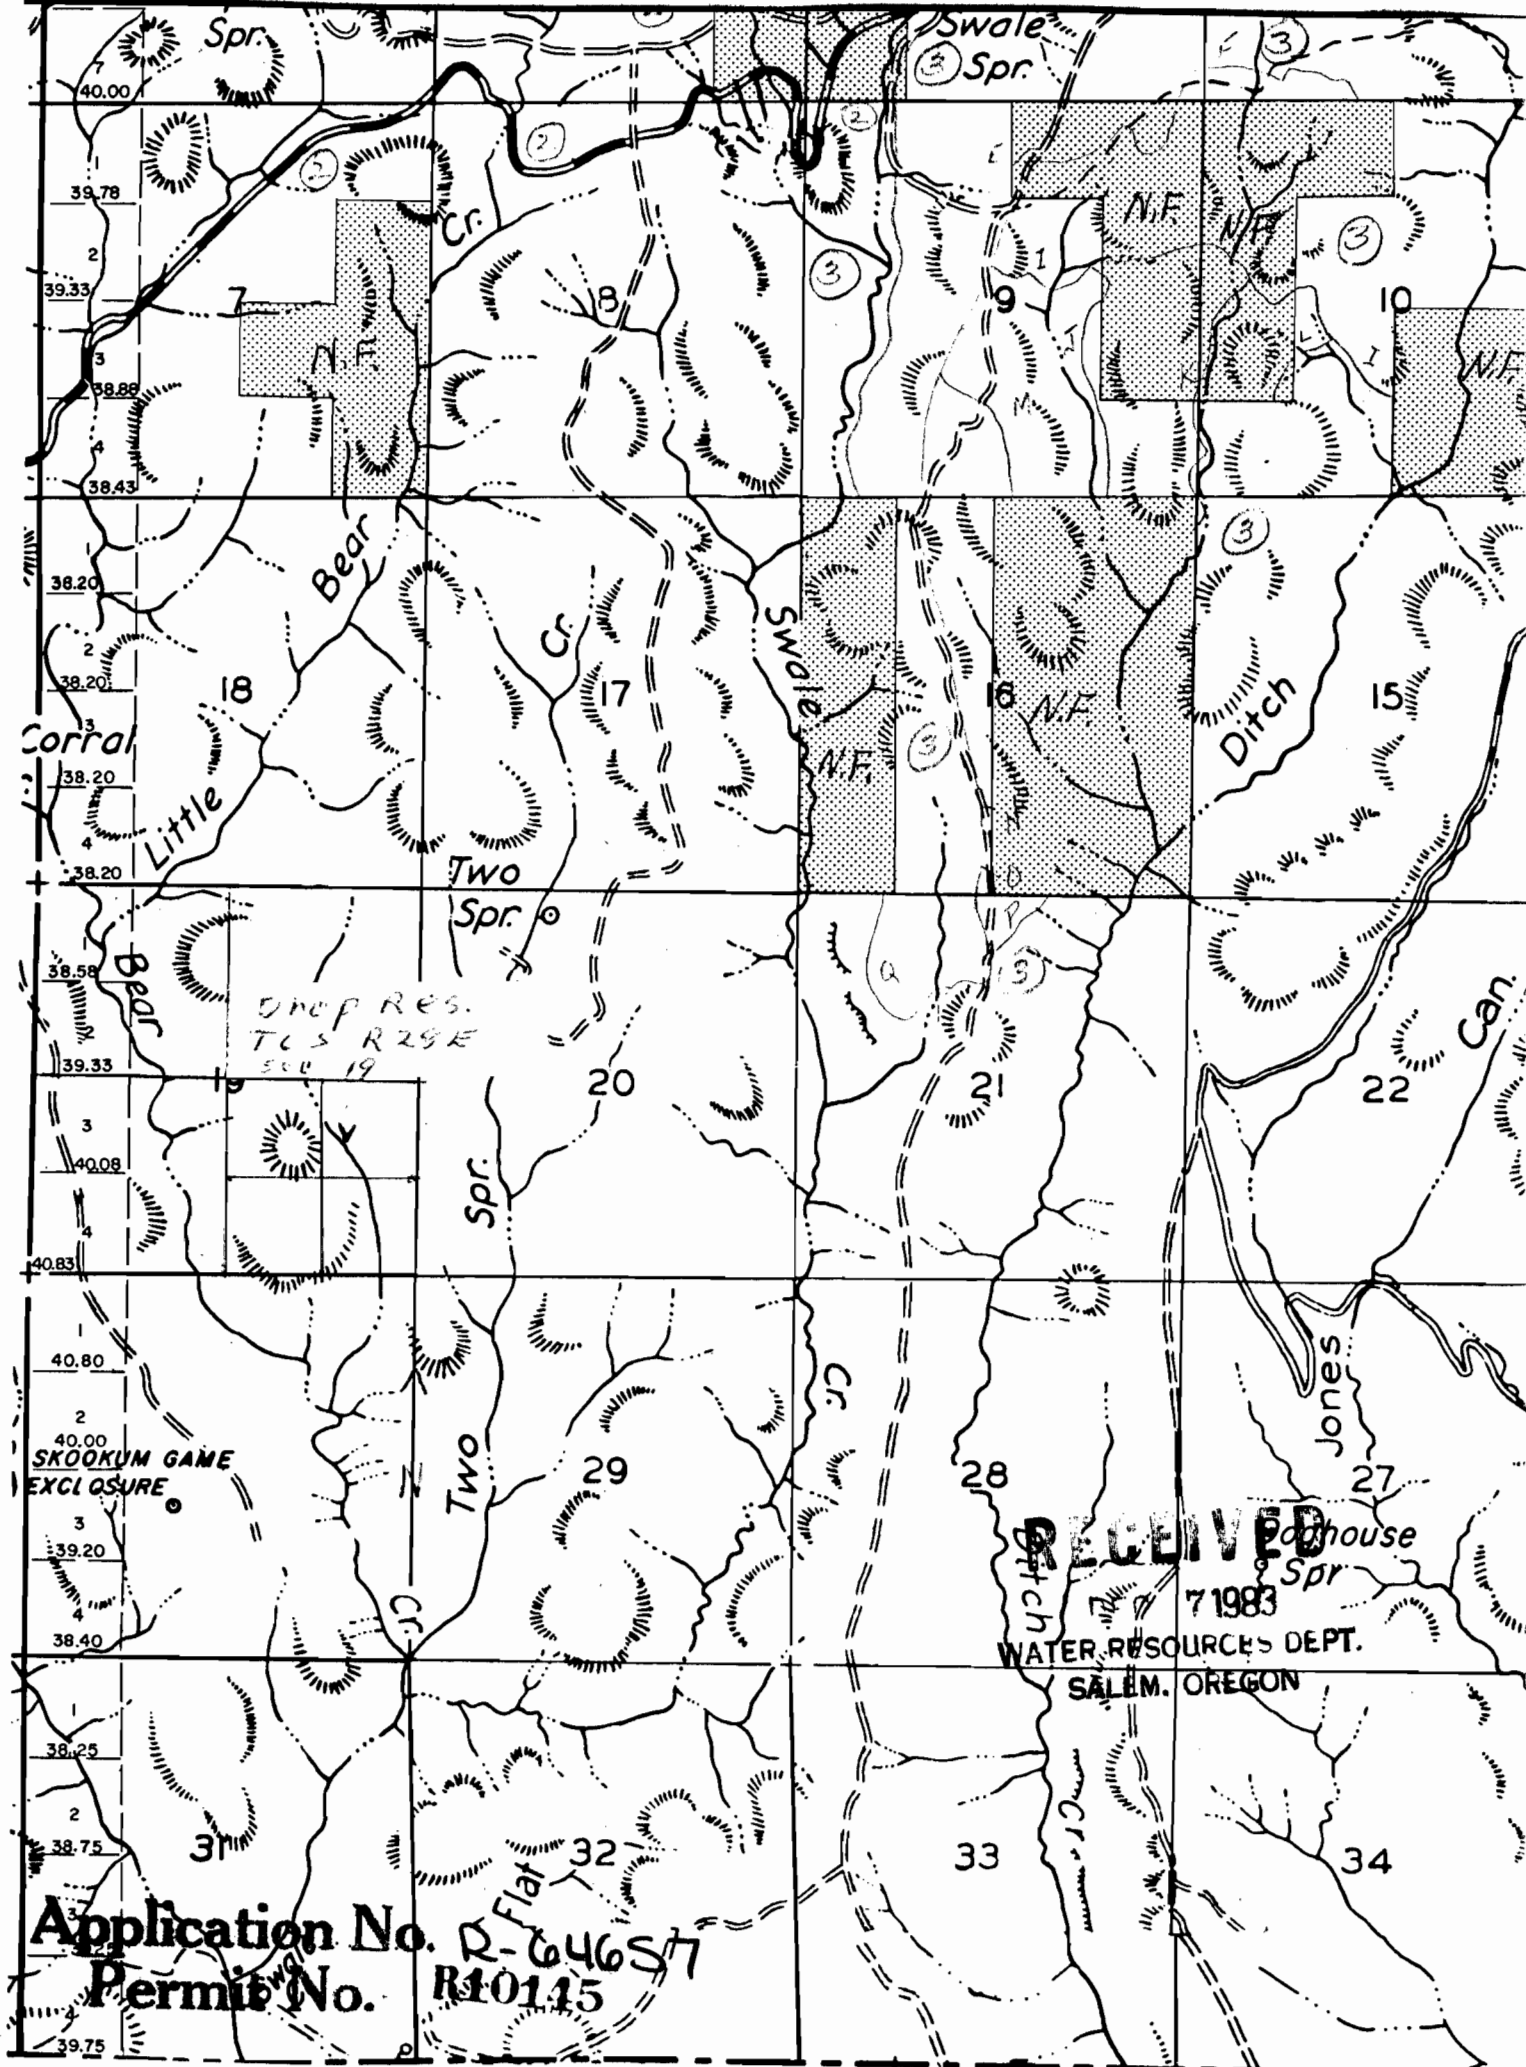

Application No. R-646S7  
Permit No. R40145

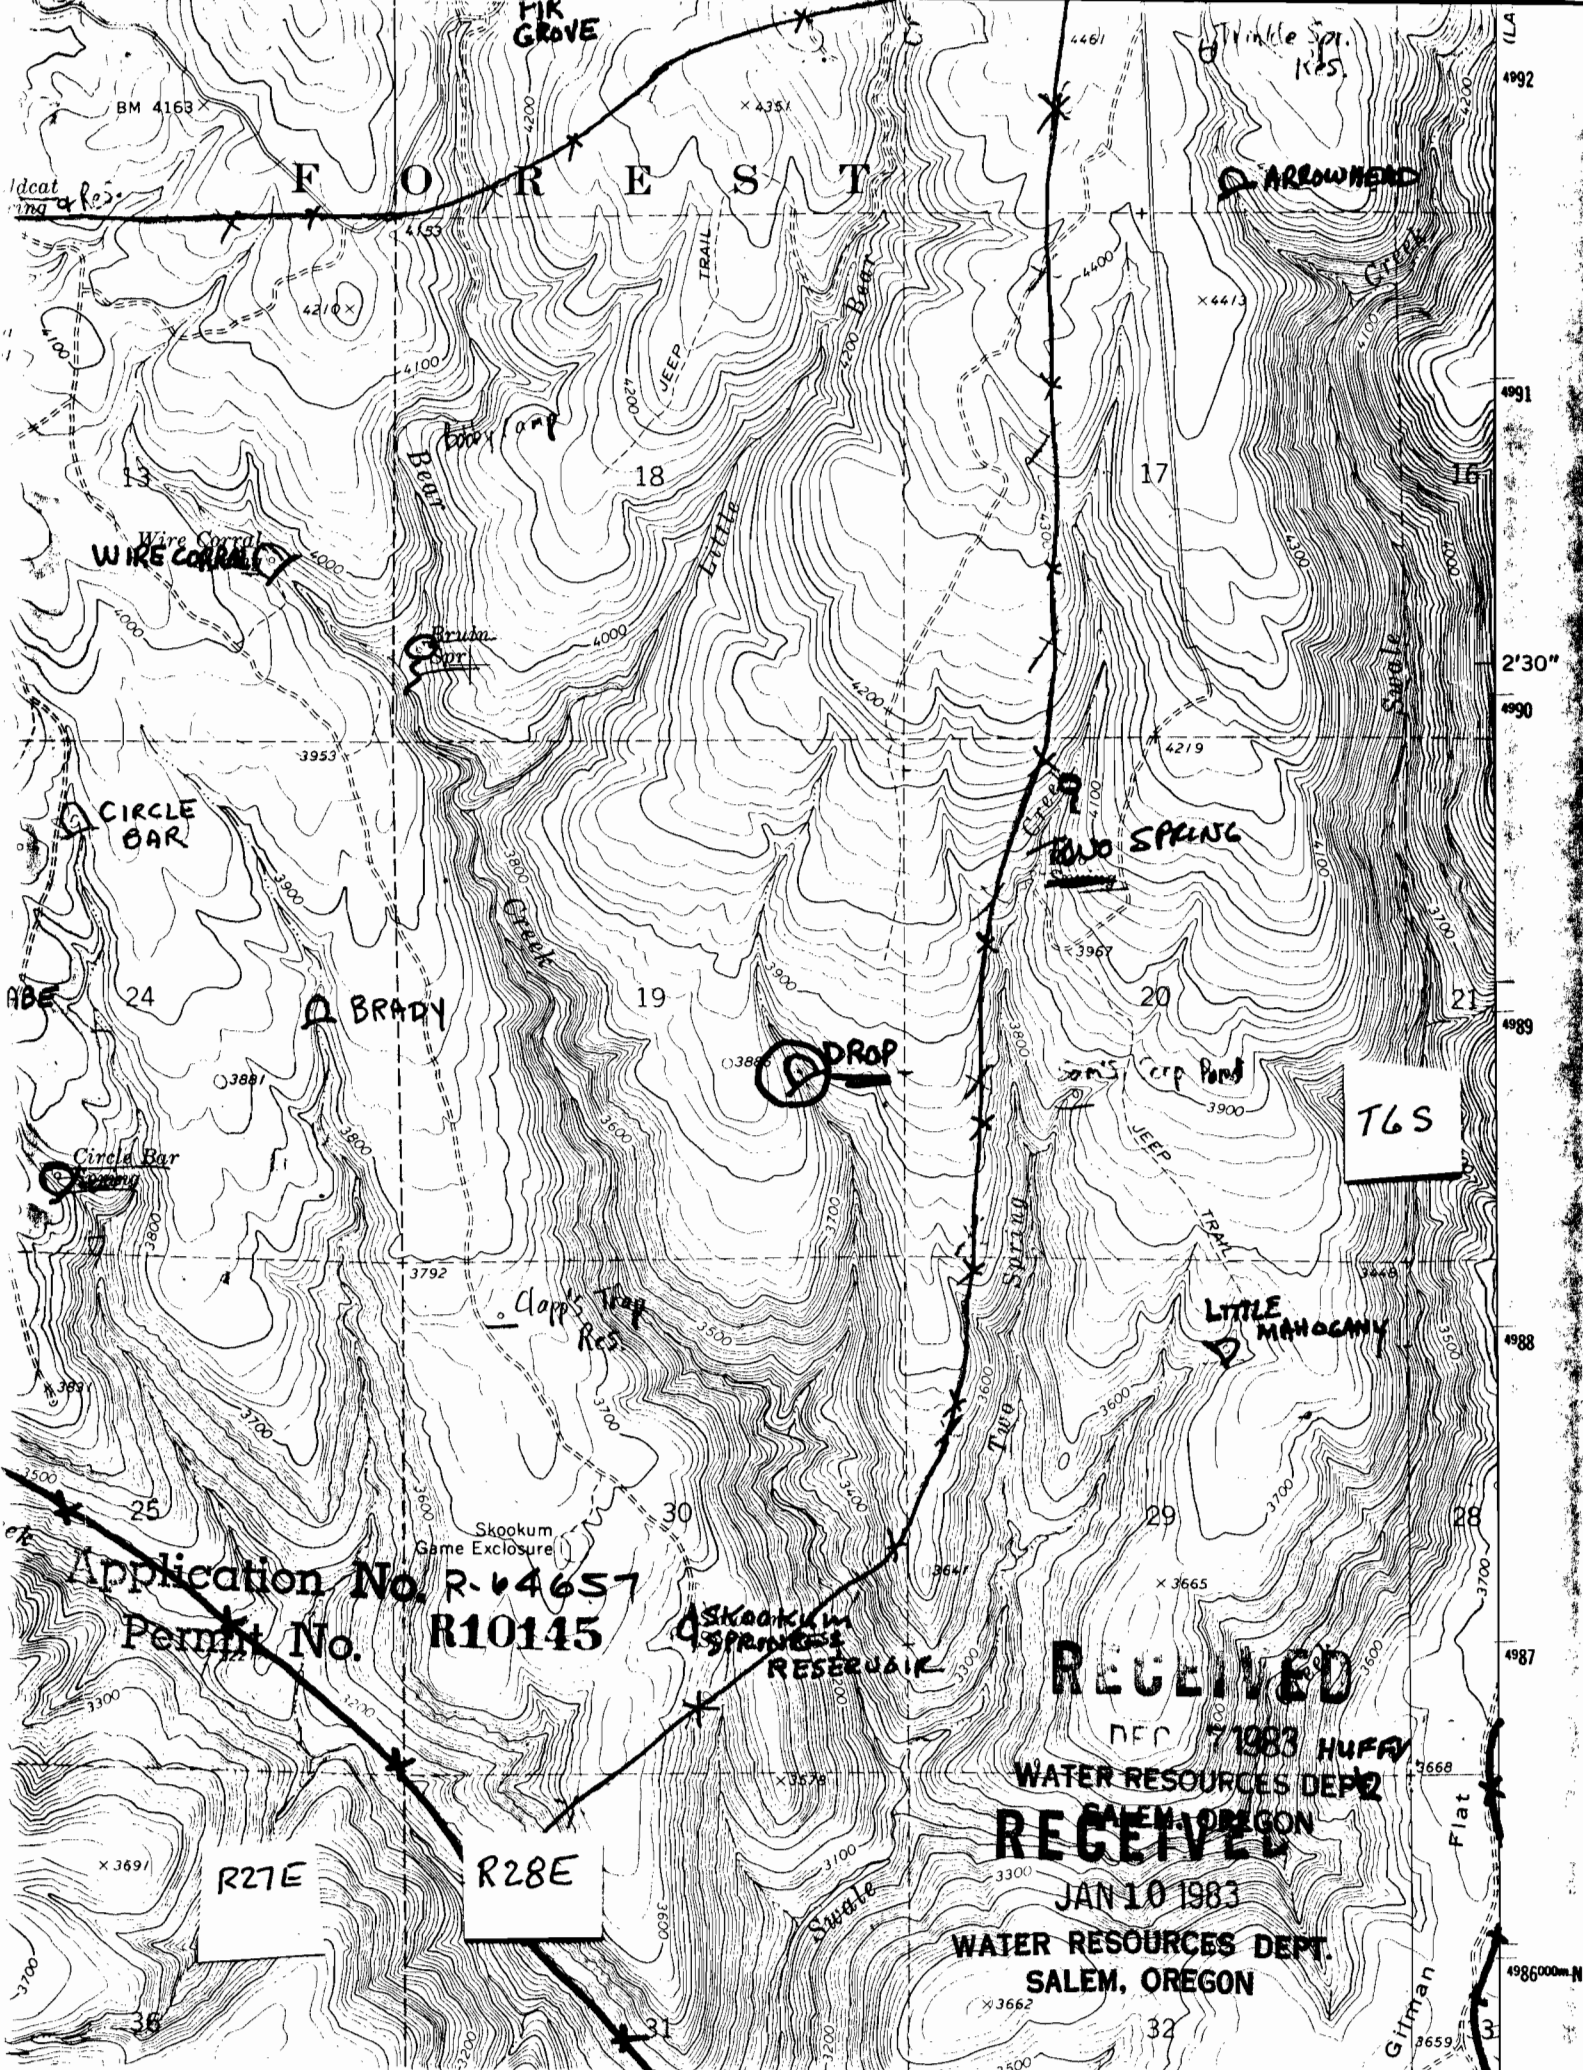

Idcat  
ing

ABE

ek

Application No. R-64657  
Permit No. R10145

R27E

R28E

RECEIVED  
DEC 7 1983 HUFF  
WATER RESOURCES DEPT  
SALEM, OREGON  
RECEIVED  
JAN 10 1983  
WATER RESOURCES DEPT.  
SALEM, OREGON


T6S

Flat  
Gilman

4986000m N

TOWNSHIP 6S, RANGE 28E, SECTION 19, W.M.

19

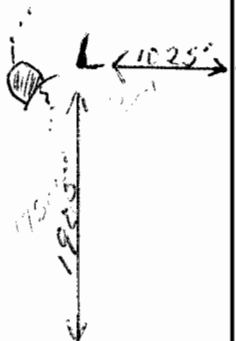

20

30

29

**RECEIVED**

JAN 10 1983  
WATER RESOURCES - DEPT.  
SALEM, OREGON

NAME DROP RES.

COUNTY MORROW

**RECEIVED**

Application No. R-64657  
Permit No. R10145

11

JAN 10 1983  
WATER RESOURCES DEPT.  
SALEM, OREGON