


Arrowhead Res.
T6S R28E
section 8 SWSE

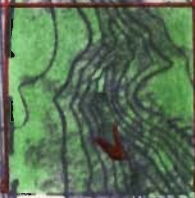

Application No. R-64663
Permit No. 20 R10143

RECEIVED

DEC 7 1983
WATER RESOURCES DEPT.
SALEM, OREGON

1976

Scale 1/2" = 1 Mile

1 1/2 0 1 2 3 4 5 Miles

1 1/4 0 1 2 3 4 5 Kilometers

1:126,720
LEGEND

XX ALLOTMENT
BOUNDARY

SWALE

T.5S.

T.6S.

T.7S.

Application No. R-64663


R. 27 E.


R. 28 E.


R. 29 E.

RECEIVED
7 1983
WATER RESOURCES DEPT.
SALEM, OREGON

RECEIVED
JAN 10 1983
WATER RESOURCES DEPT.
SALEM, OREGON

ARROWHEAD RES.

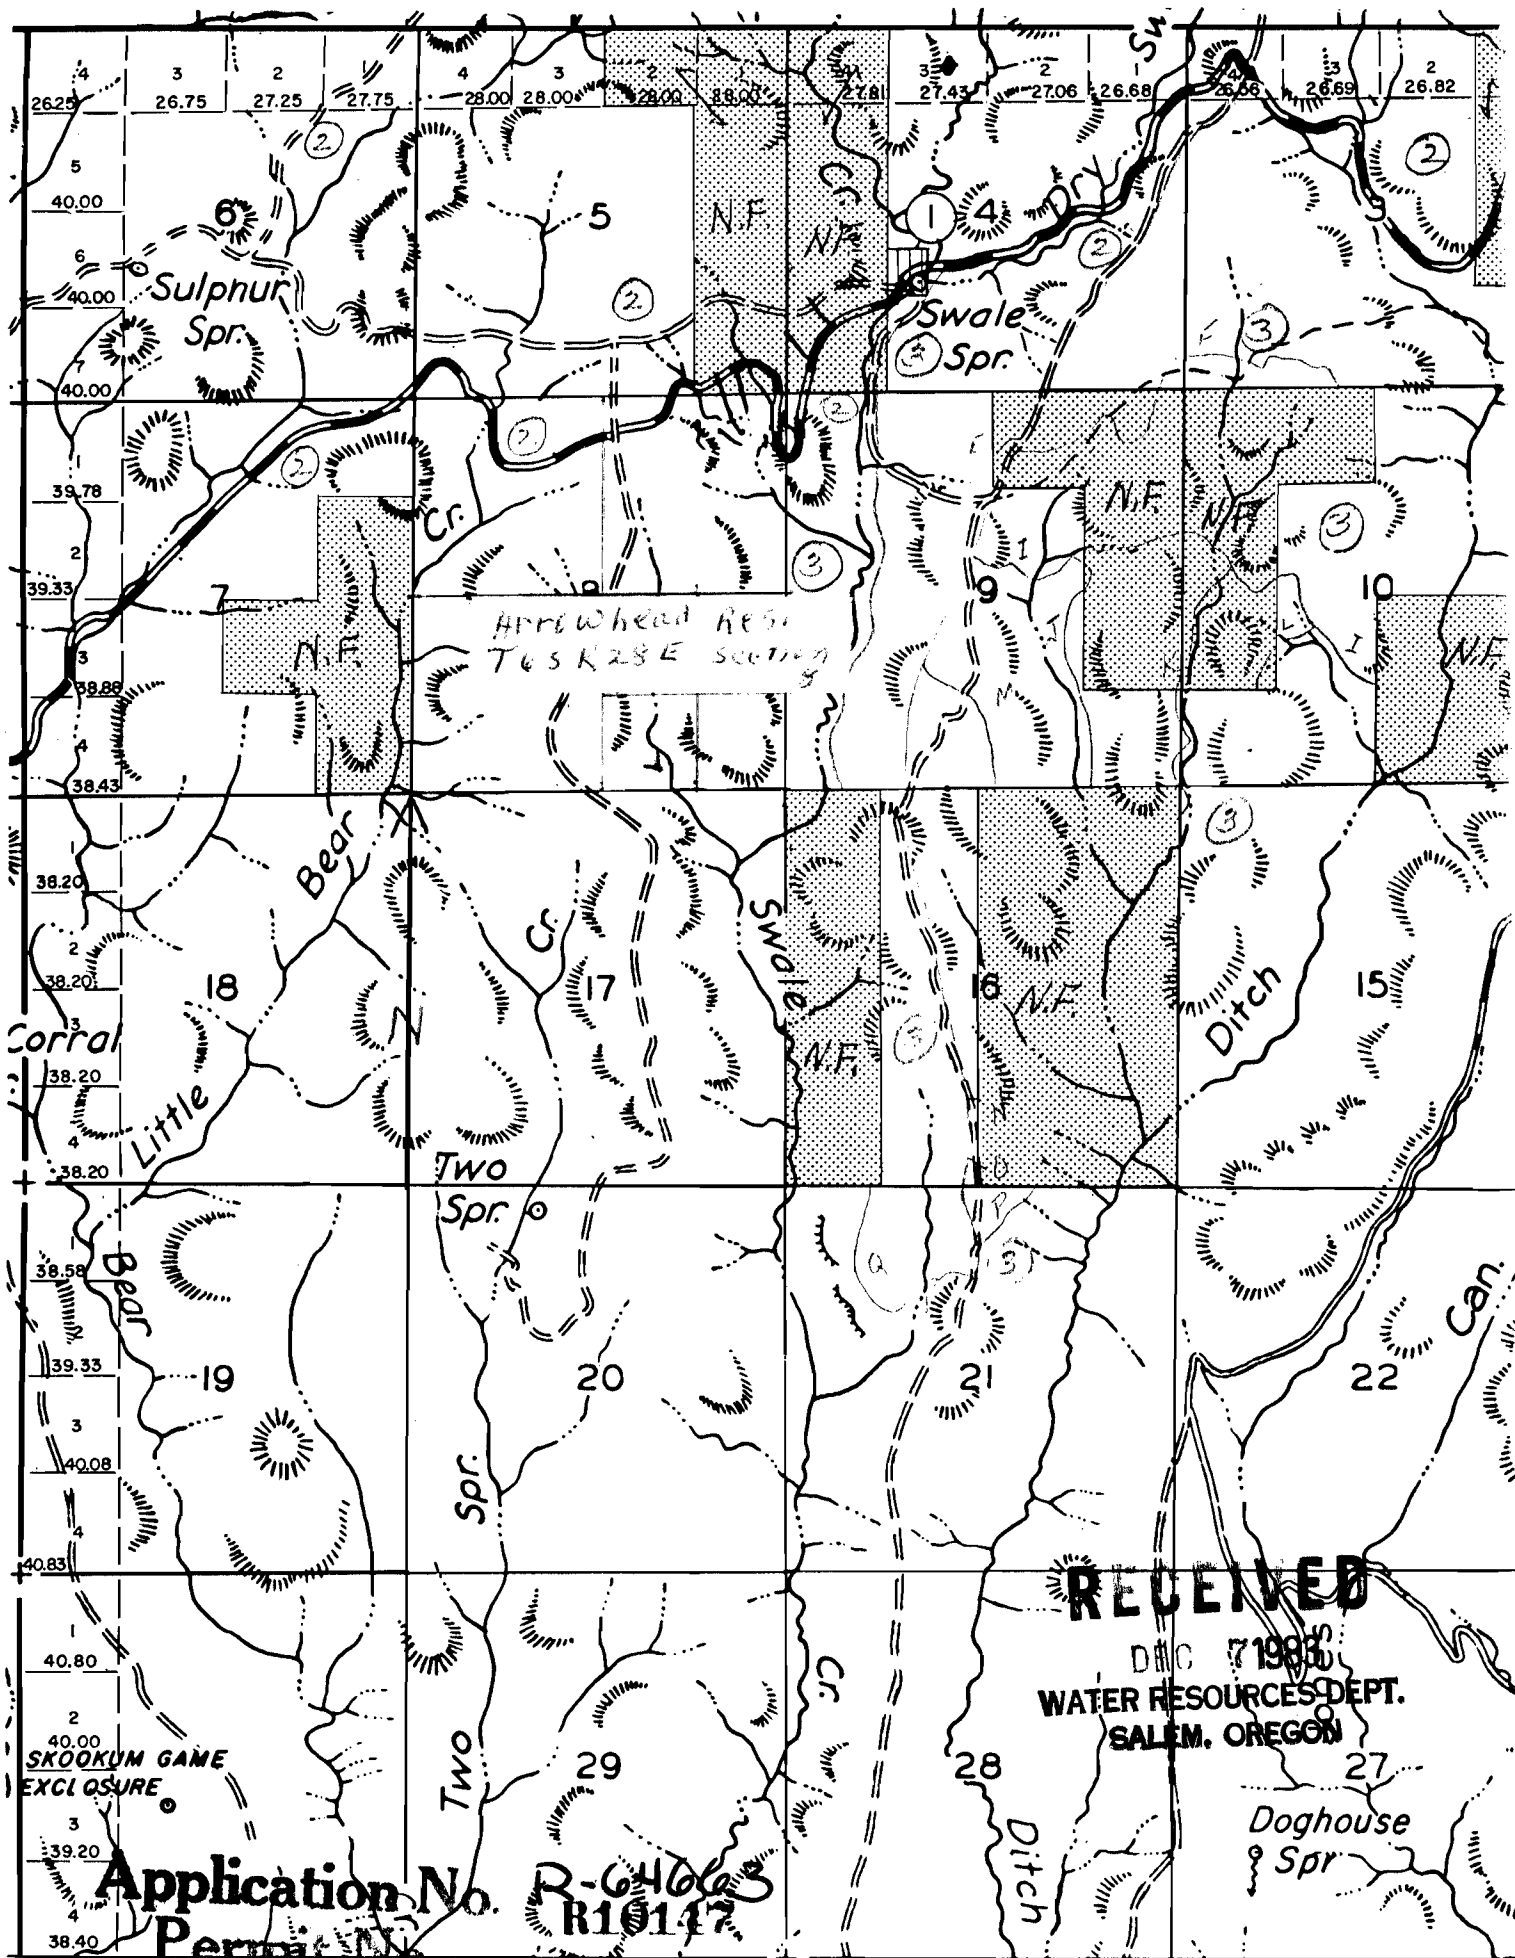

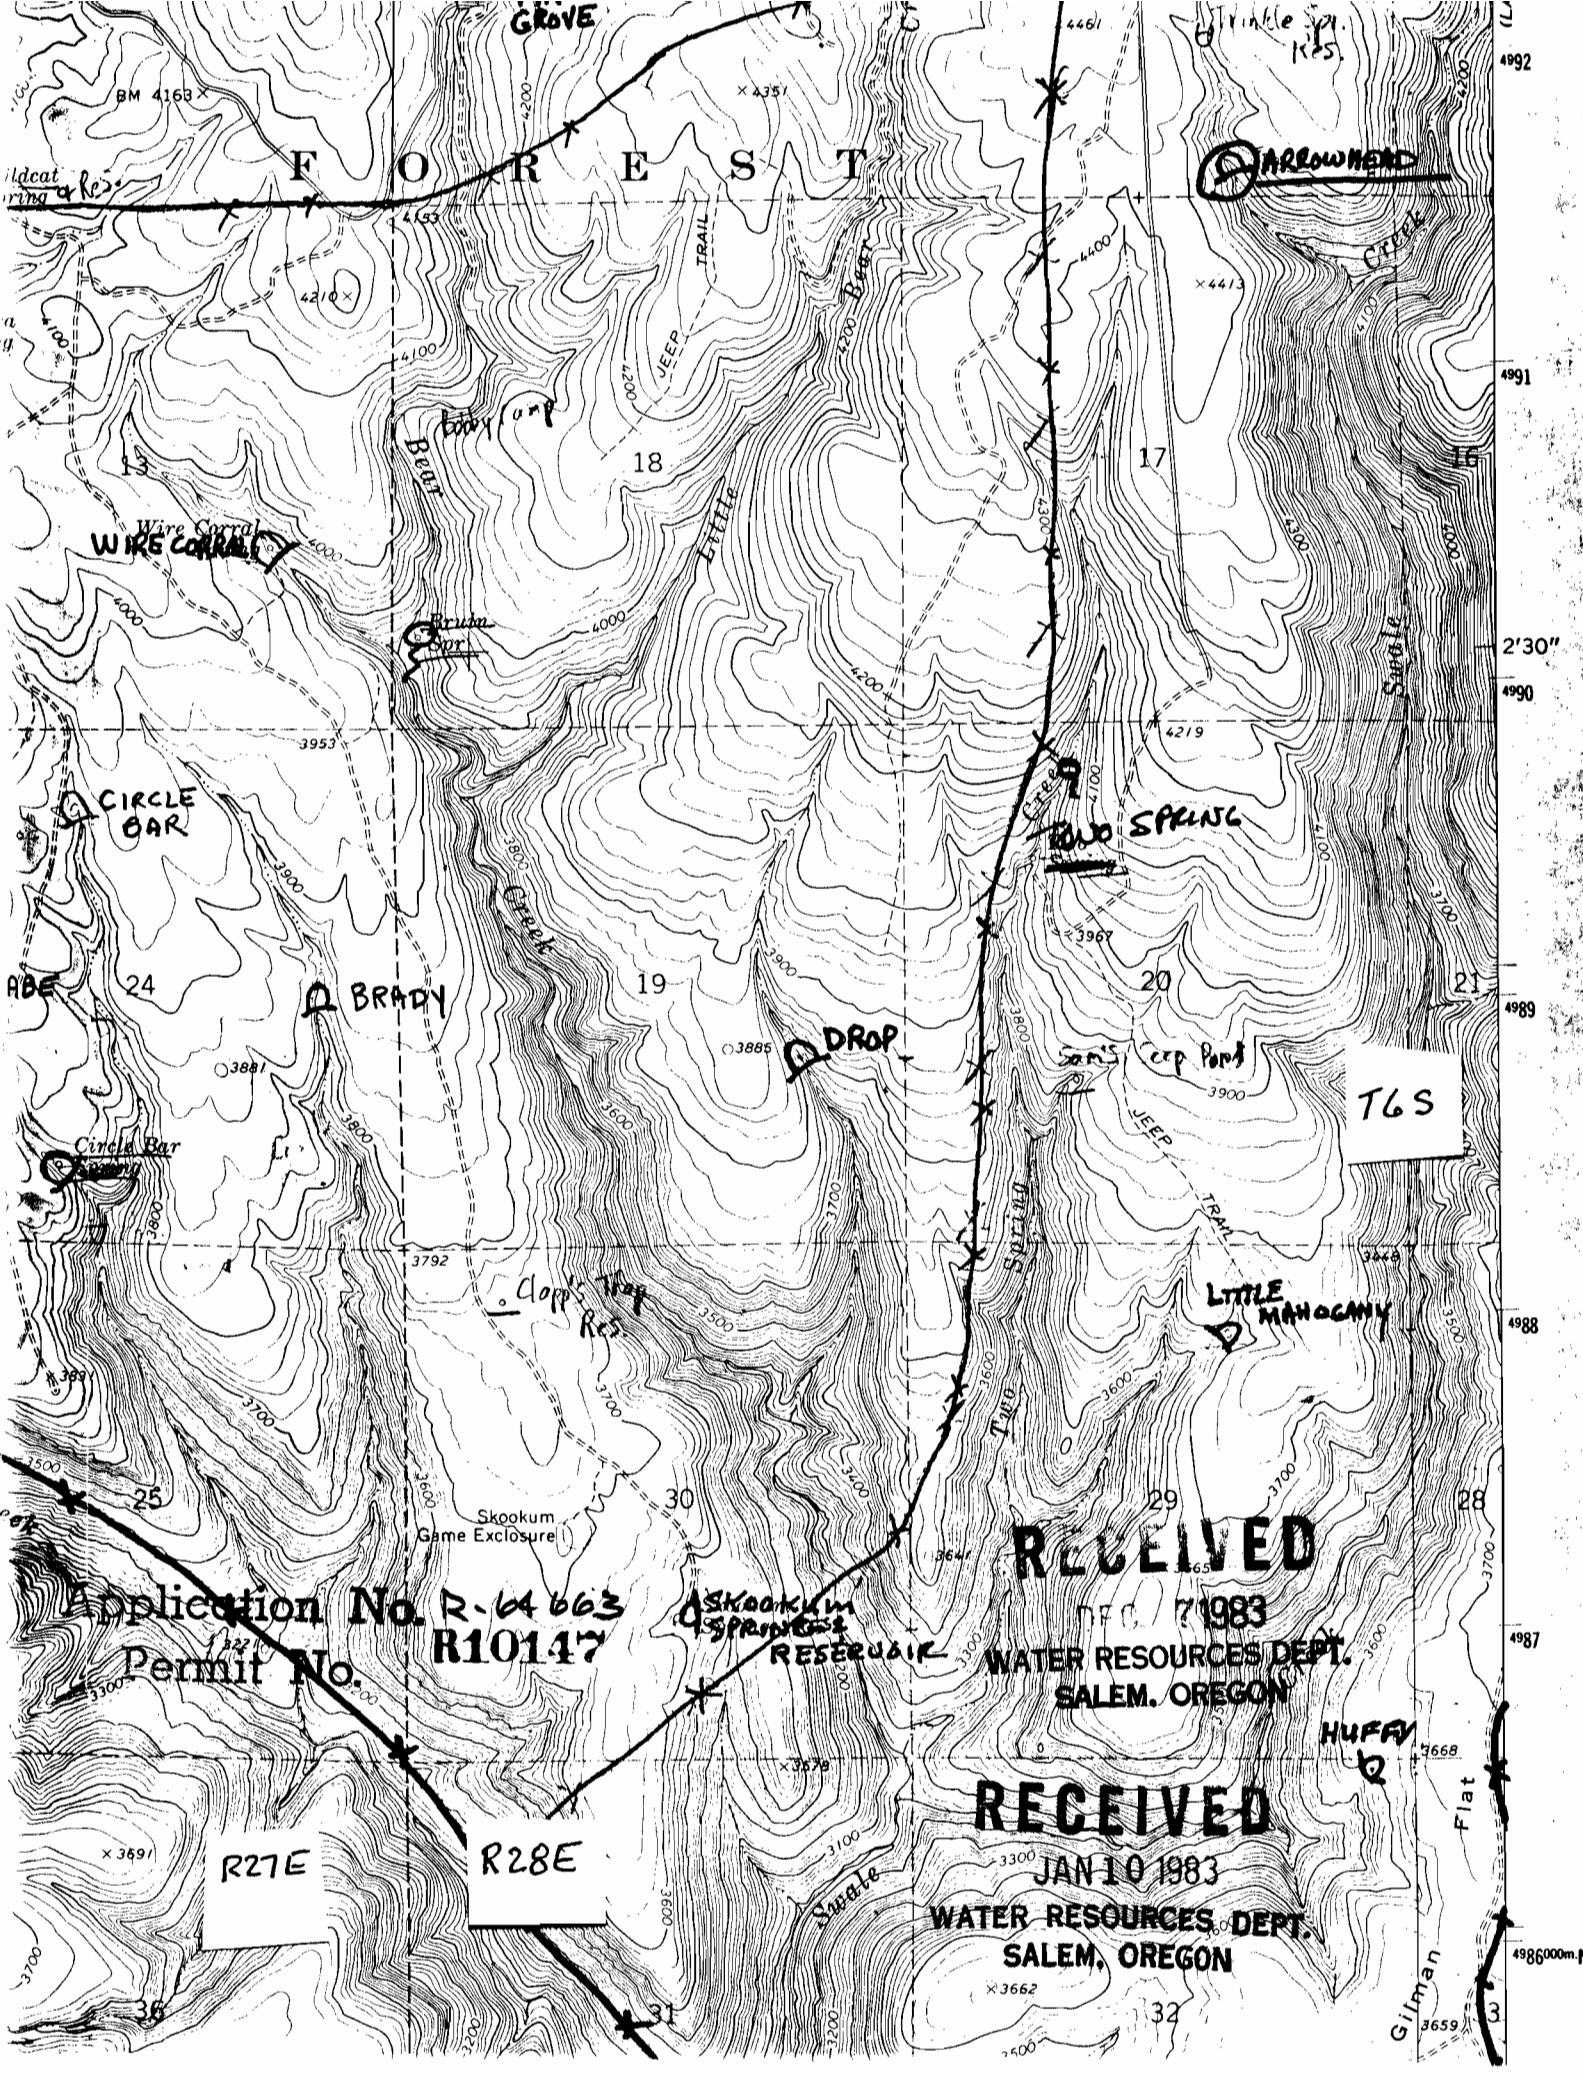

ARROWHEAD

T6S

RECEIVED

DEC 7 1983

WATER RESOURCES DEPT.
SALEM, OREGON

RECEIVED

JAN 10 1983

WATER RESOURCES DEPT.
SALEM, OREGON

Application No. R-64 663

Permit No. R10147

R27E

R28E

HUFFY

Flat

Gilman

4986000m N

TOWNSHIP 6S, RANGE 28E, SECTION 8, W.M.

8	9
17	16 RECEIVED DEC 7 1983 WATER RESOURCES DEPT. SALEM, OREGON

NAME ARROWHEAD RES.

COUNTY NORROW

Application No. R-64663
Permit No. R10147

17

RECEIVED
JAN 10 1983
WATER RESOURCES DEPT.
SALEM, OREGON