

TUPPER

WEST TUPPER RES.
T6S R27E
SECTION 4 SE SW

NEW DEAL POND
T6S R27E
SECTION 3 NW SW

RECEIVED

DEC 7 1983

WATER RESOURCES DEPT.

SALEM, OREGON


MORPHINE POND
T6S R27E
SECTION 9

Application No. R-64669
Permit No. R10148

T.7S.

**SALEM, OREGÓN**

R. 28 E (BM 3640
STUB)

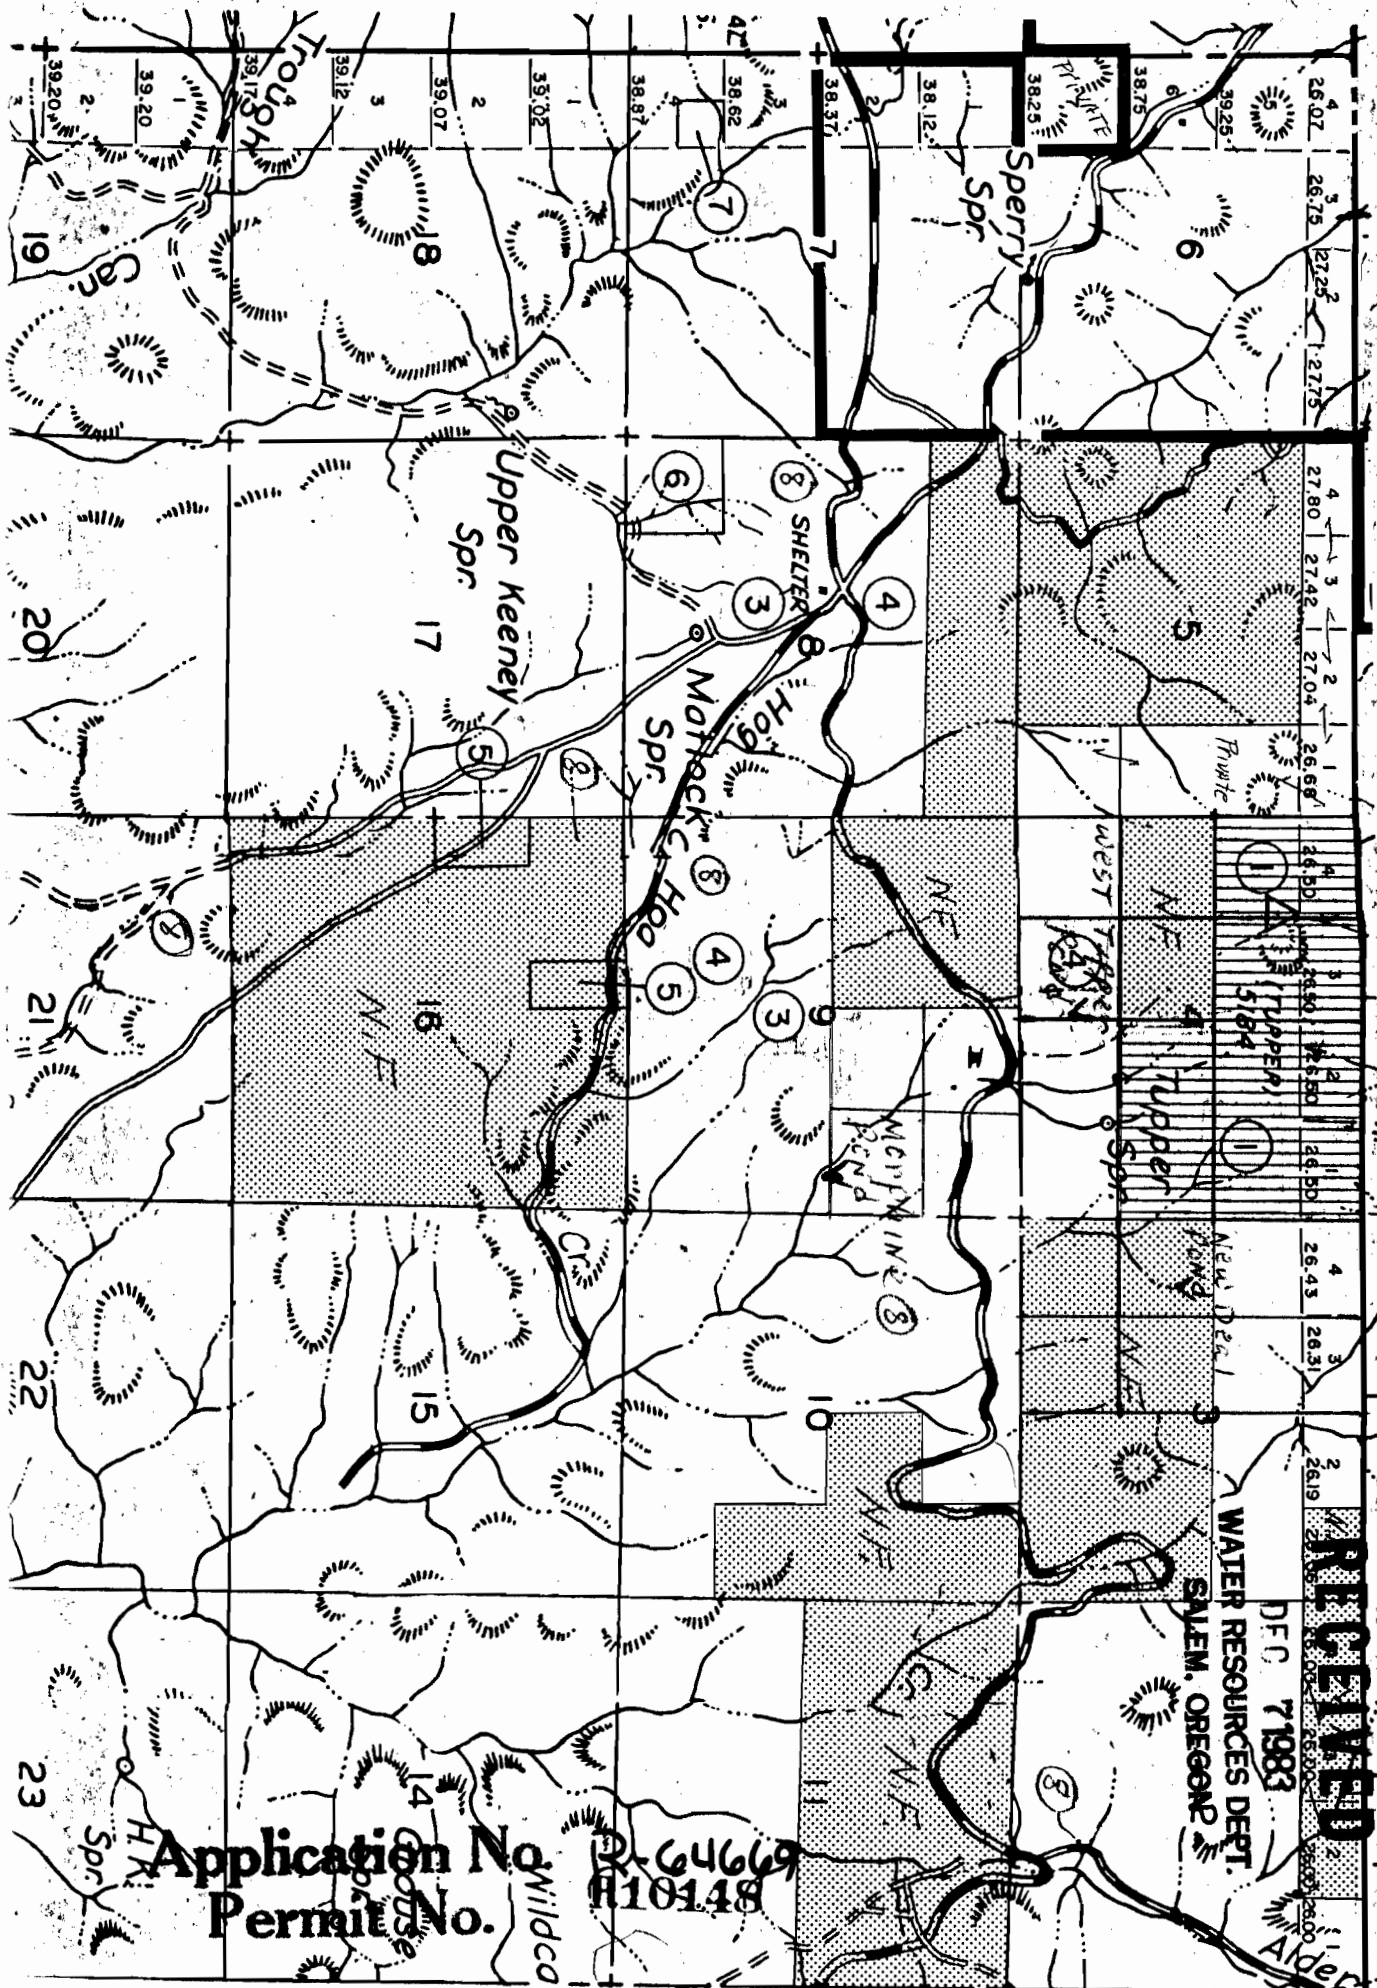

NEW DEAL
POND

W. TUPPER
RES.

MORPHINE POND

SNEEZE
PLANK
RES.

RECEIVED

DEC 7 1983

WATER RESOURCES DEPT
SALEM, OREGON

LONG
CANYON
RES.

UPPER BACON SPR
RES.

MORPHINE SPR
RES.

DE
JUNCTION
RES.

RECEIVED

JAN 10 1983

WATER RESOURCES DEPT
SALEM, OREGON


MORPHINE
RIDGE #1 RES

Application No. R-64669
Permit No.

SIDERIM
RES.

F O R E S T

TOWNSHIP 6S, RANGE 2, SECTION 3, W.M.

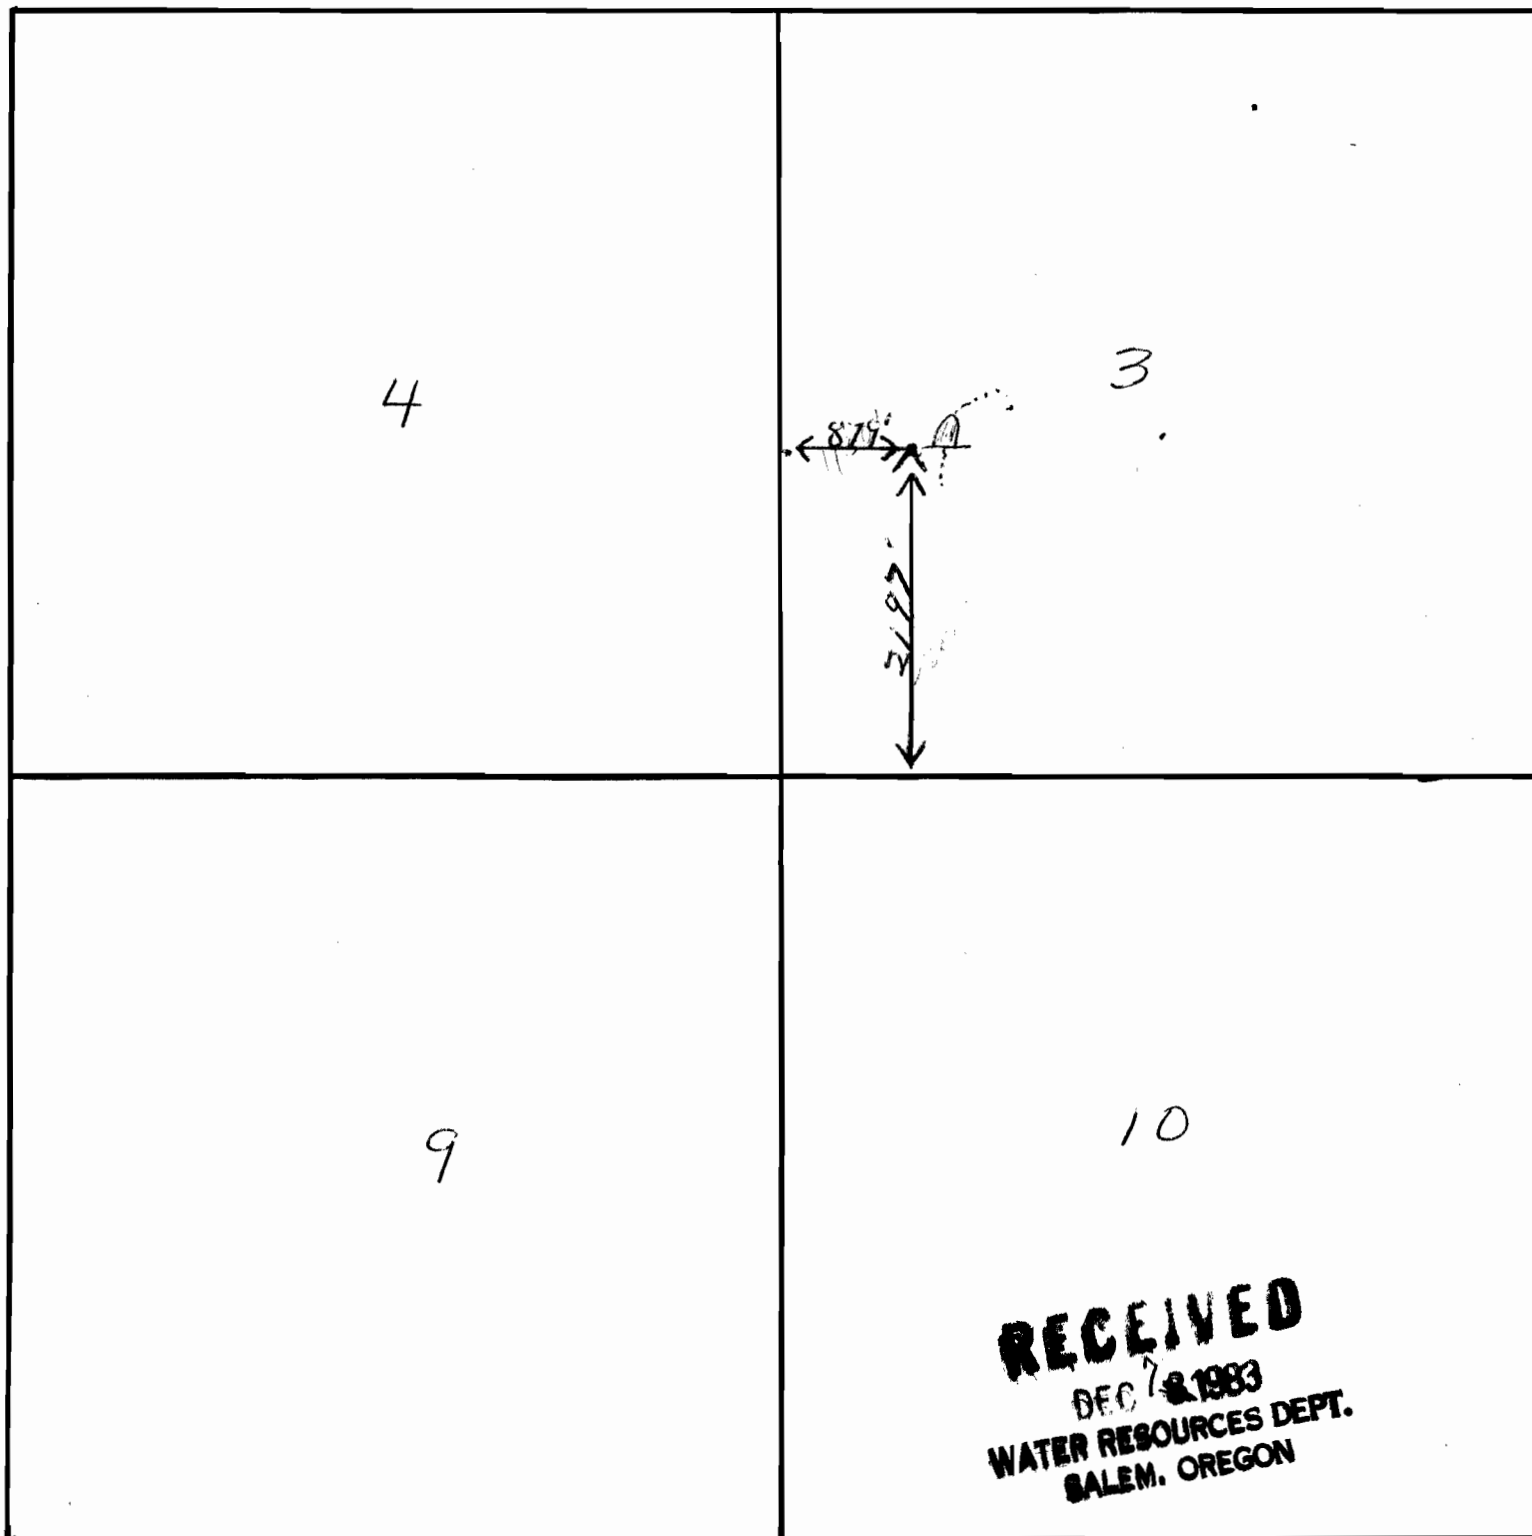

NAME NEW DEAL POND

COUNTY MORROW

Application No. R-64669


Permit No. R10148 1A

RECEIVED

JAN 10 1983

WATER RESOURCES DEPT.
SALEM, OREGON

TOWNSHIP 6S, RANGE 27E, SECTION 4, W.M.

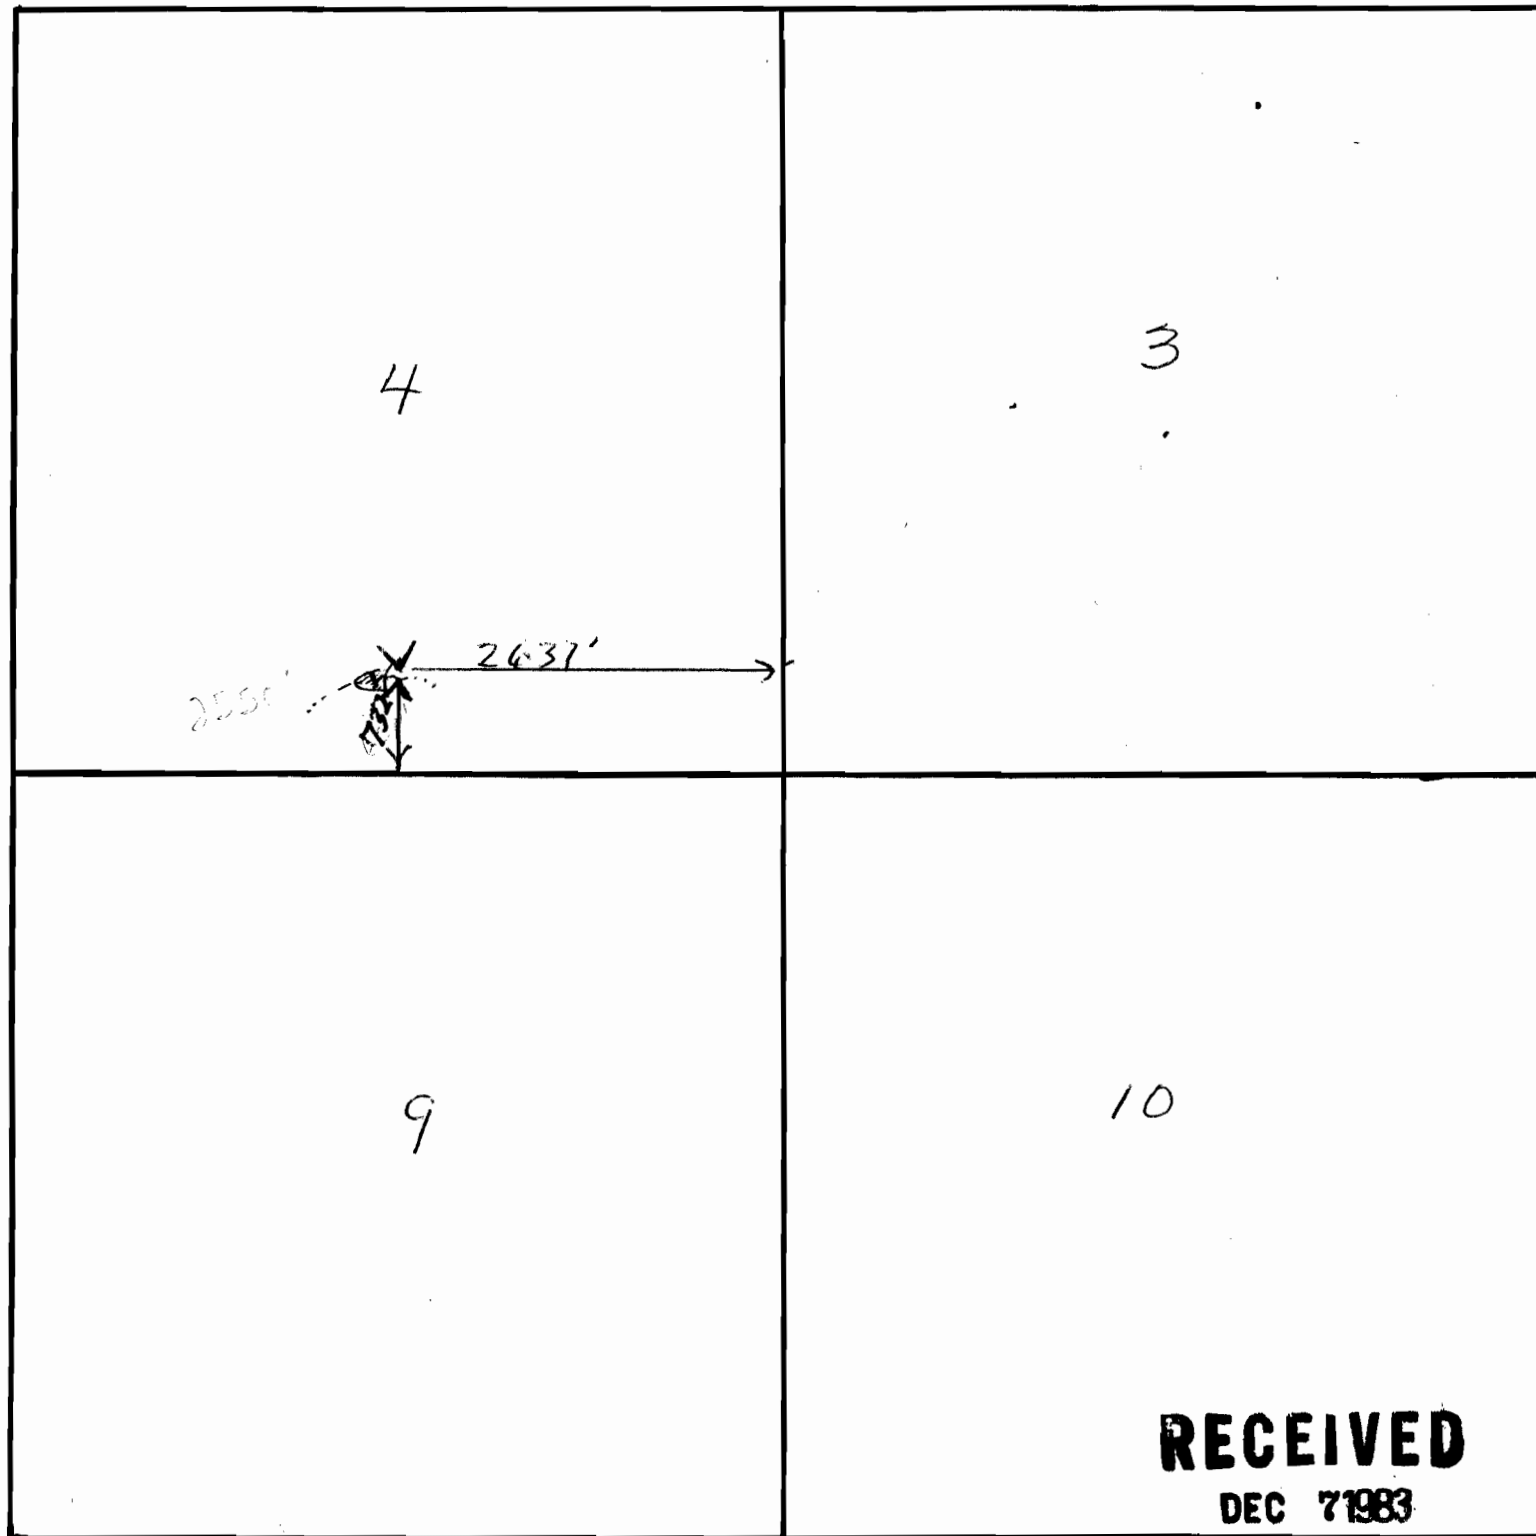

RECEIVED

DEC 7 1983

WATER RESOURCES DEPT.

SALEM, OREGON

RECEIVED

JAN 10 1983

WATER RESOURCES DEPT.

SALEM, OREGON


NAME W. TUPPER RES.

COUNTY MORROW

Application No. R-64669

Permit No. R10148 /B

TOWNSHIP 6S, RANGE 27E, SECTION 9, W.M.

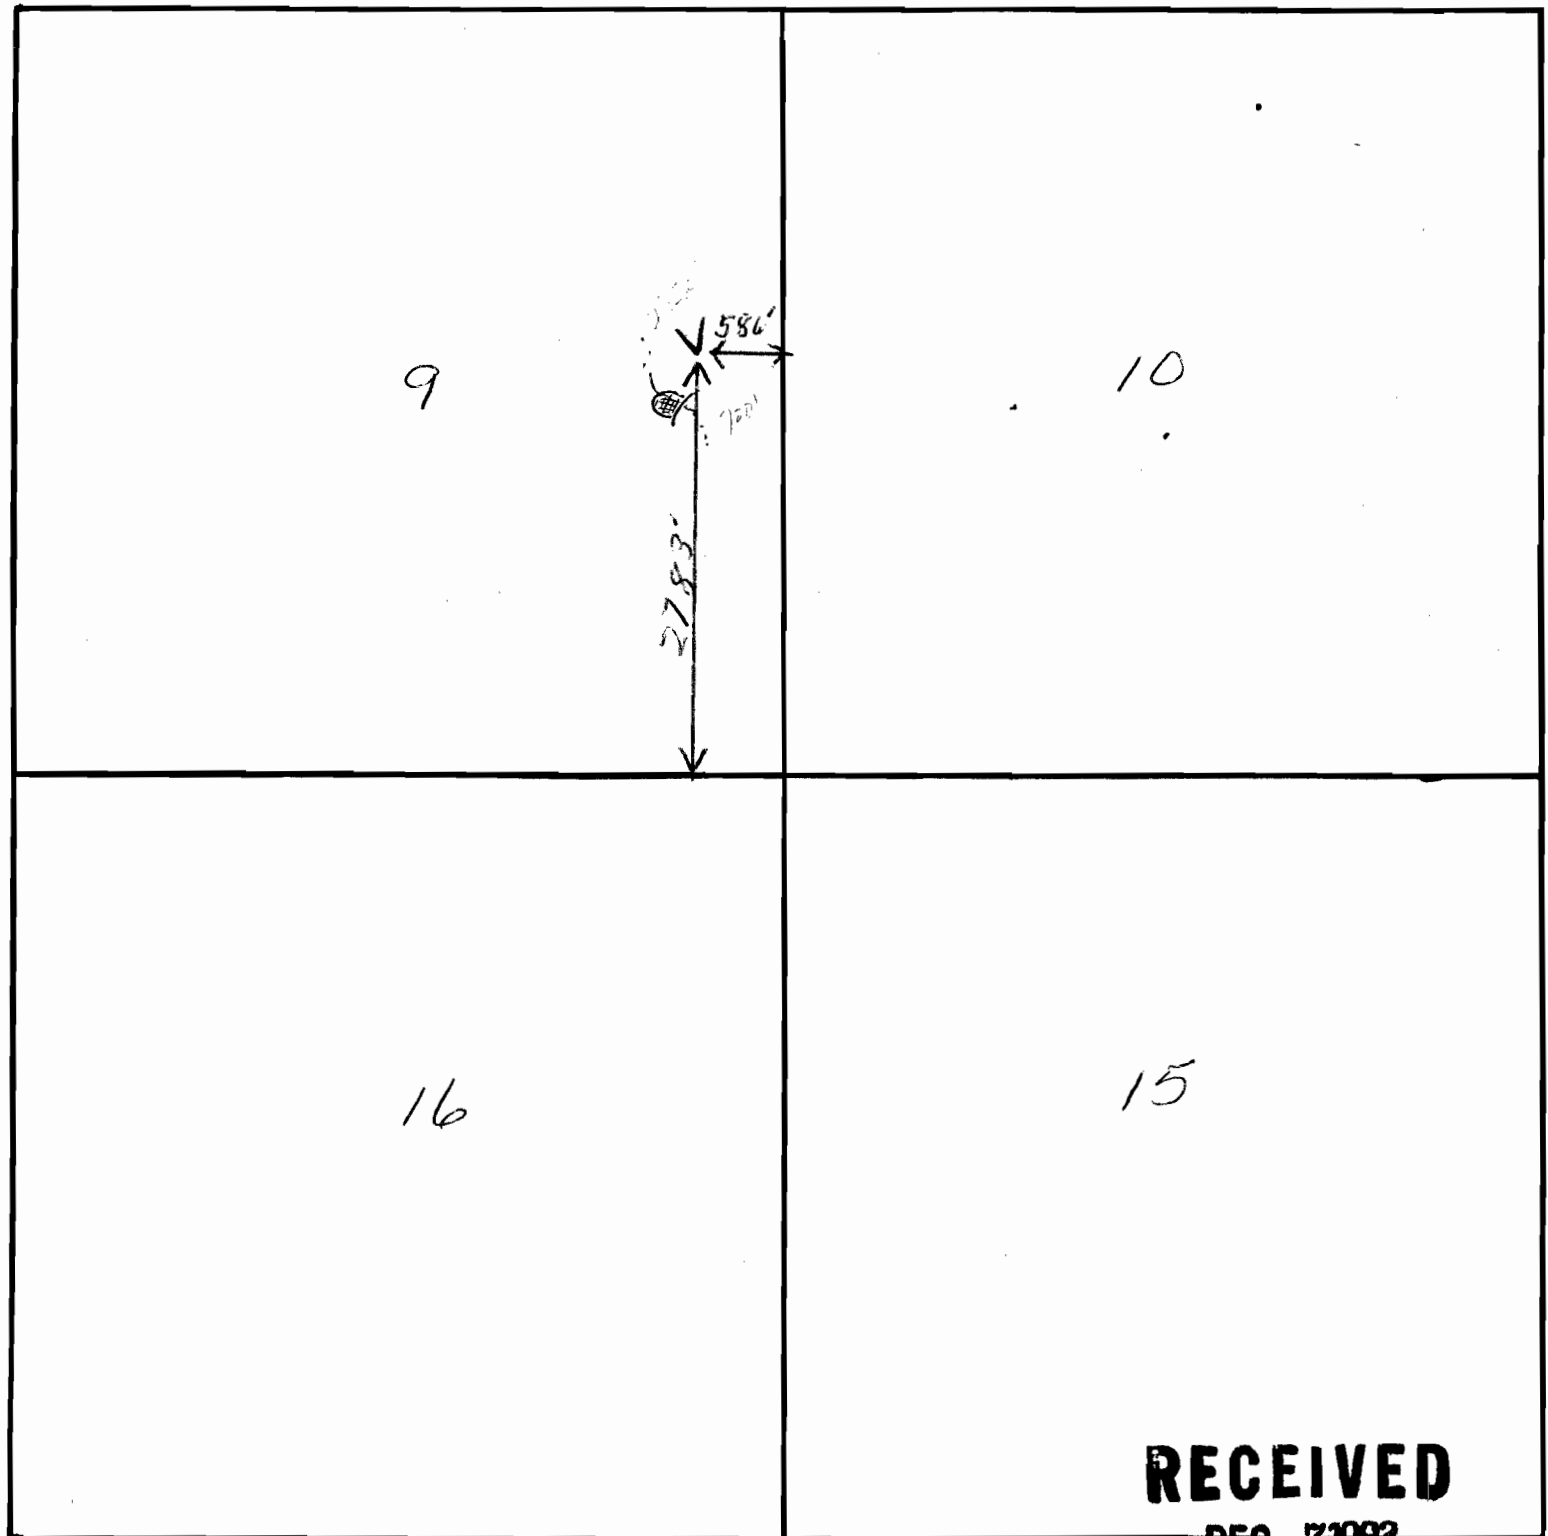

RECEIVED

DEC 7 1983

**WATER RESOURCES DEPT.
SALEM, OREGON**

RECEIVED

JAN 10 1983

**WATER RESOURCES DEPT.
SALEM, OREGON**

NAME MORPHINE POND

COUNTY MORROW

Application No. R-64669

Permit No. R10148

1C