


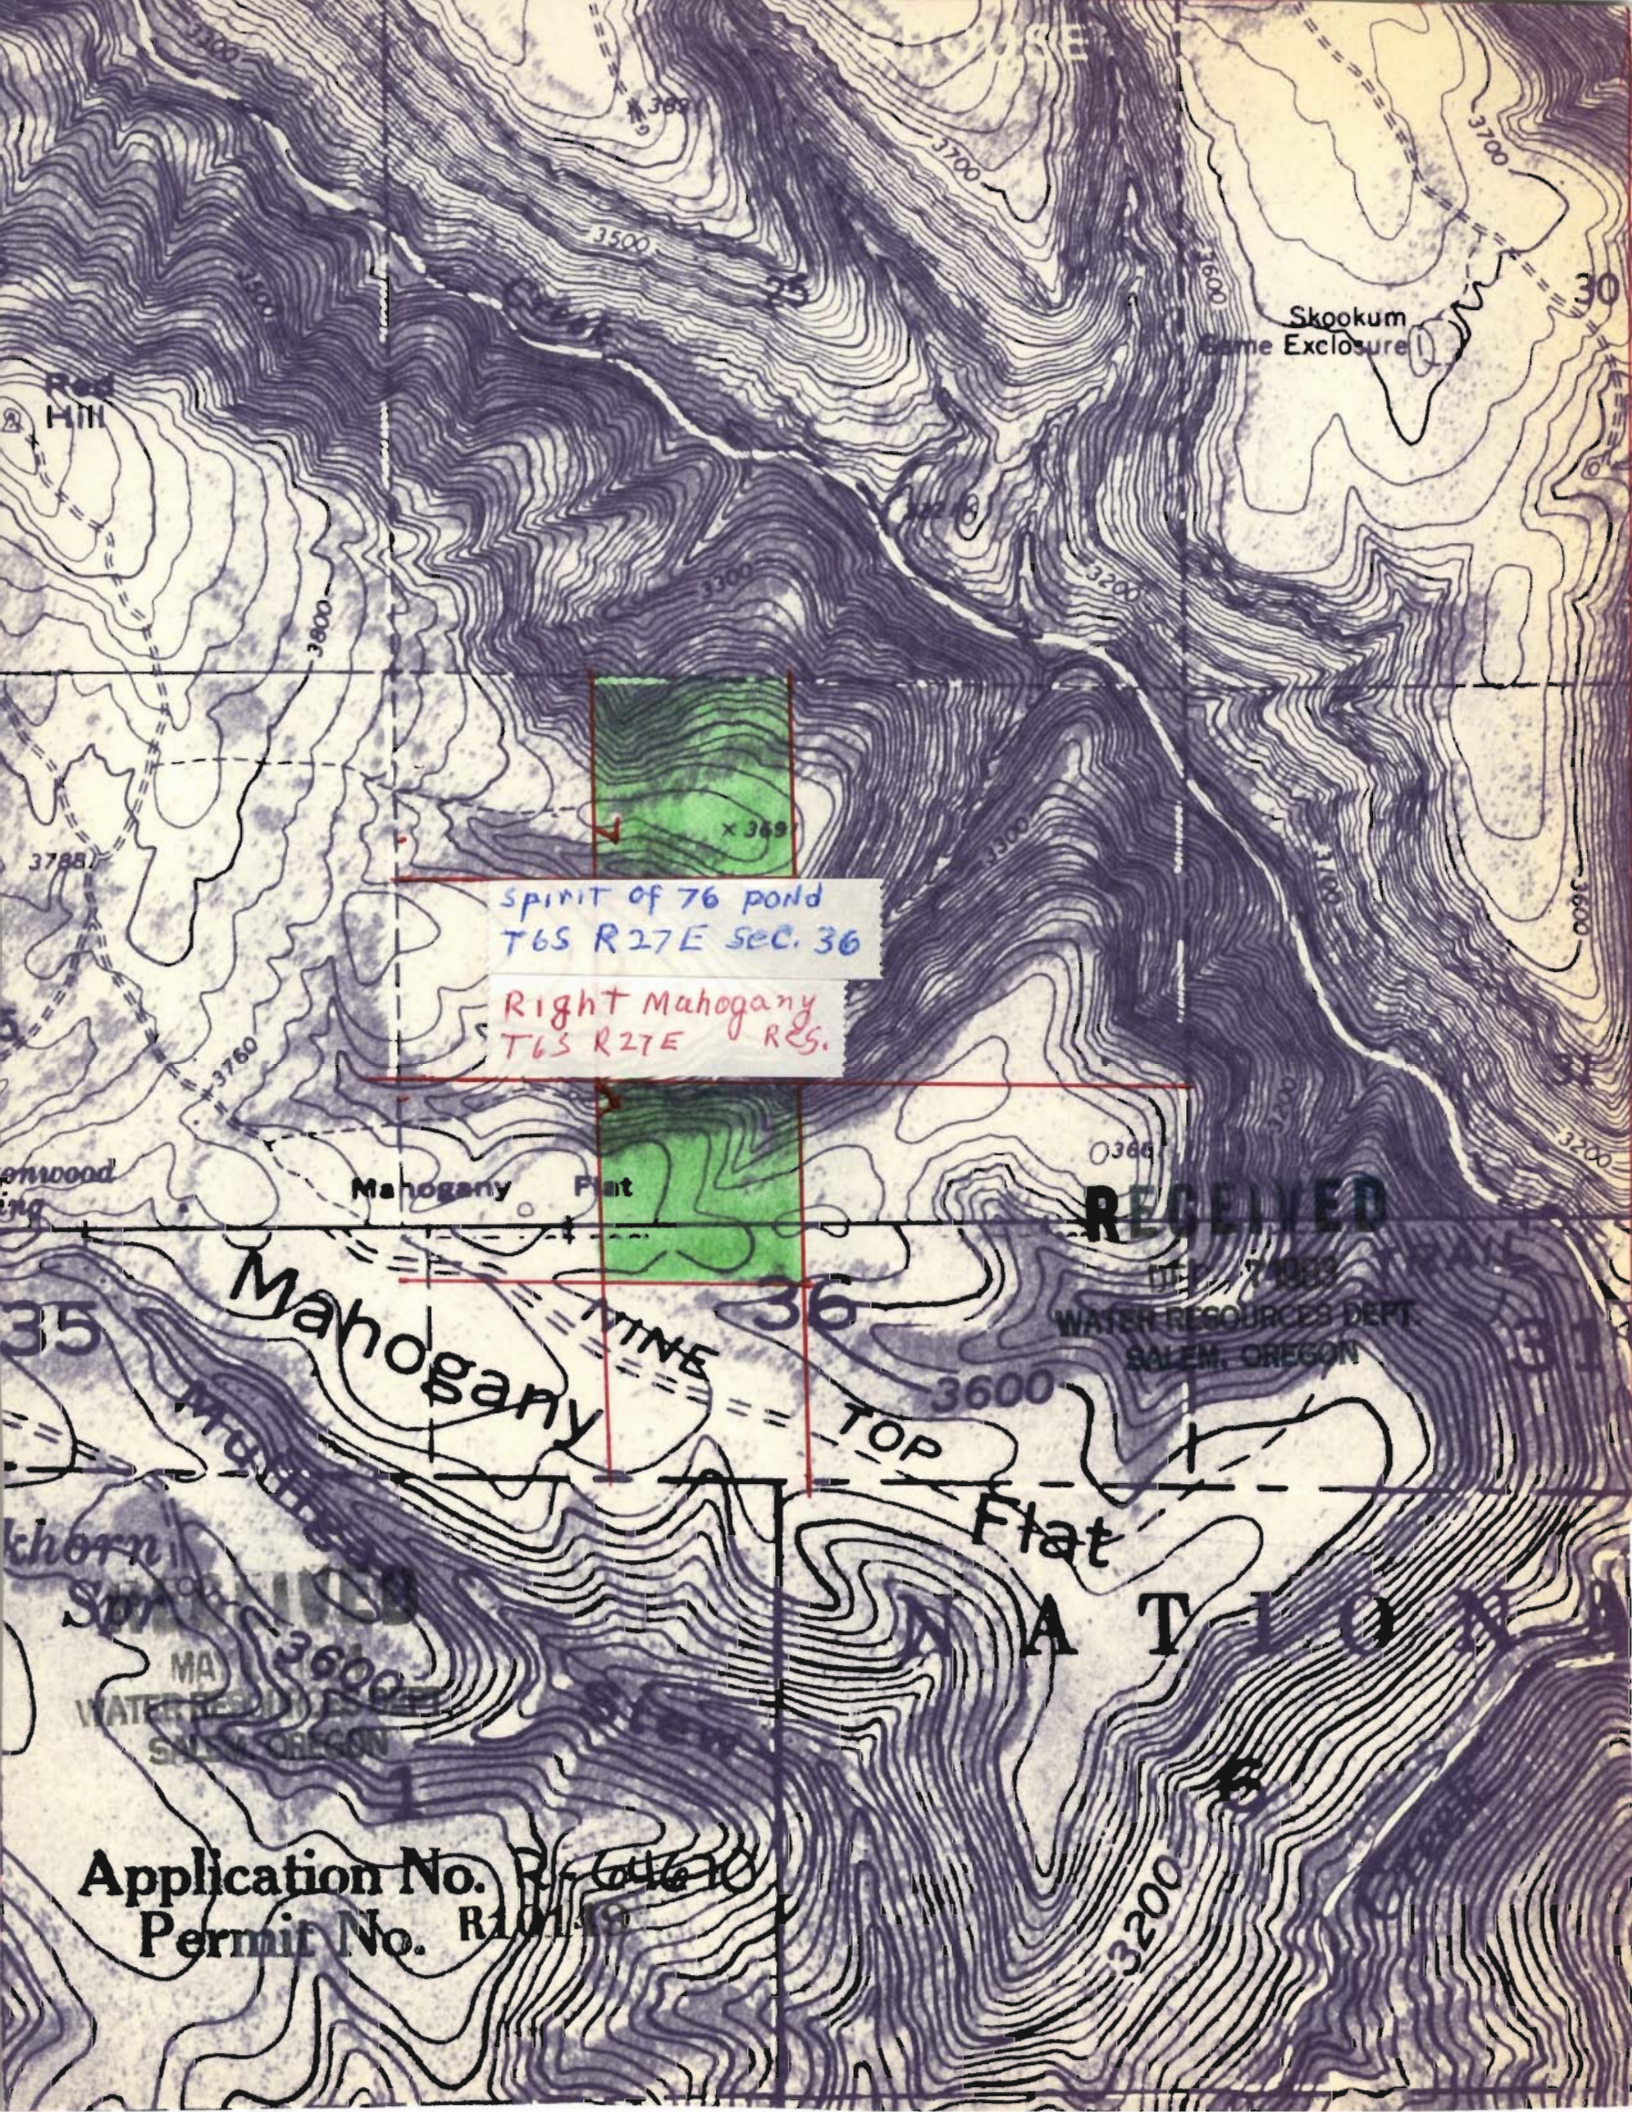

Red Hill

Skookum Game Exclosure

spirit of 76 pond
T6S R27E SEC. 36

Right Mahogany
T6S R27E RES.

RECEIVED

DEC 7 1983
WATER RESOURCES DEPT.
SALEM, OREGON

Mahogany Flat

Mahogany

Flat

N A T I O N


Application No. R-64610
Permit No. R10150


T. 5 S.

Application No. R-4670
Permit No. R10119

T. 6 S.

T. 7 S.

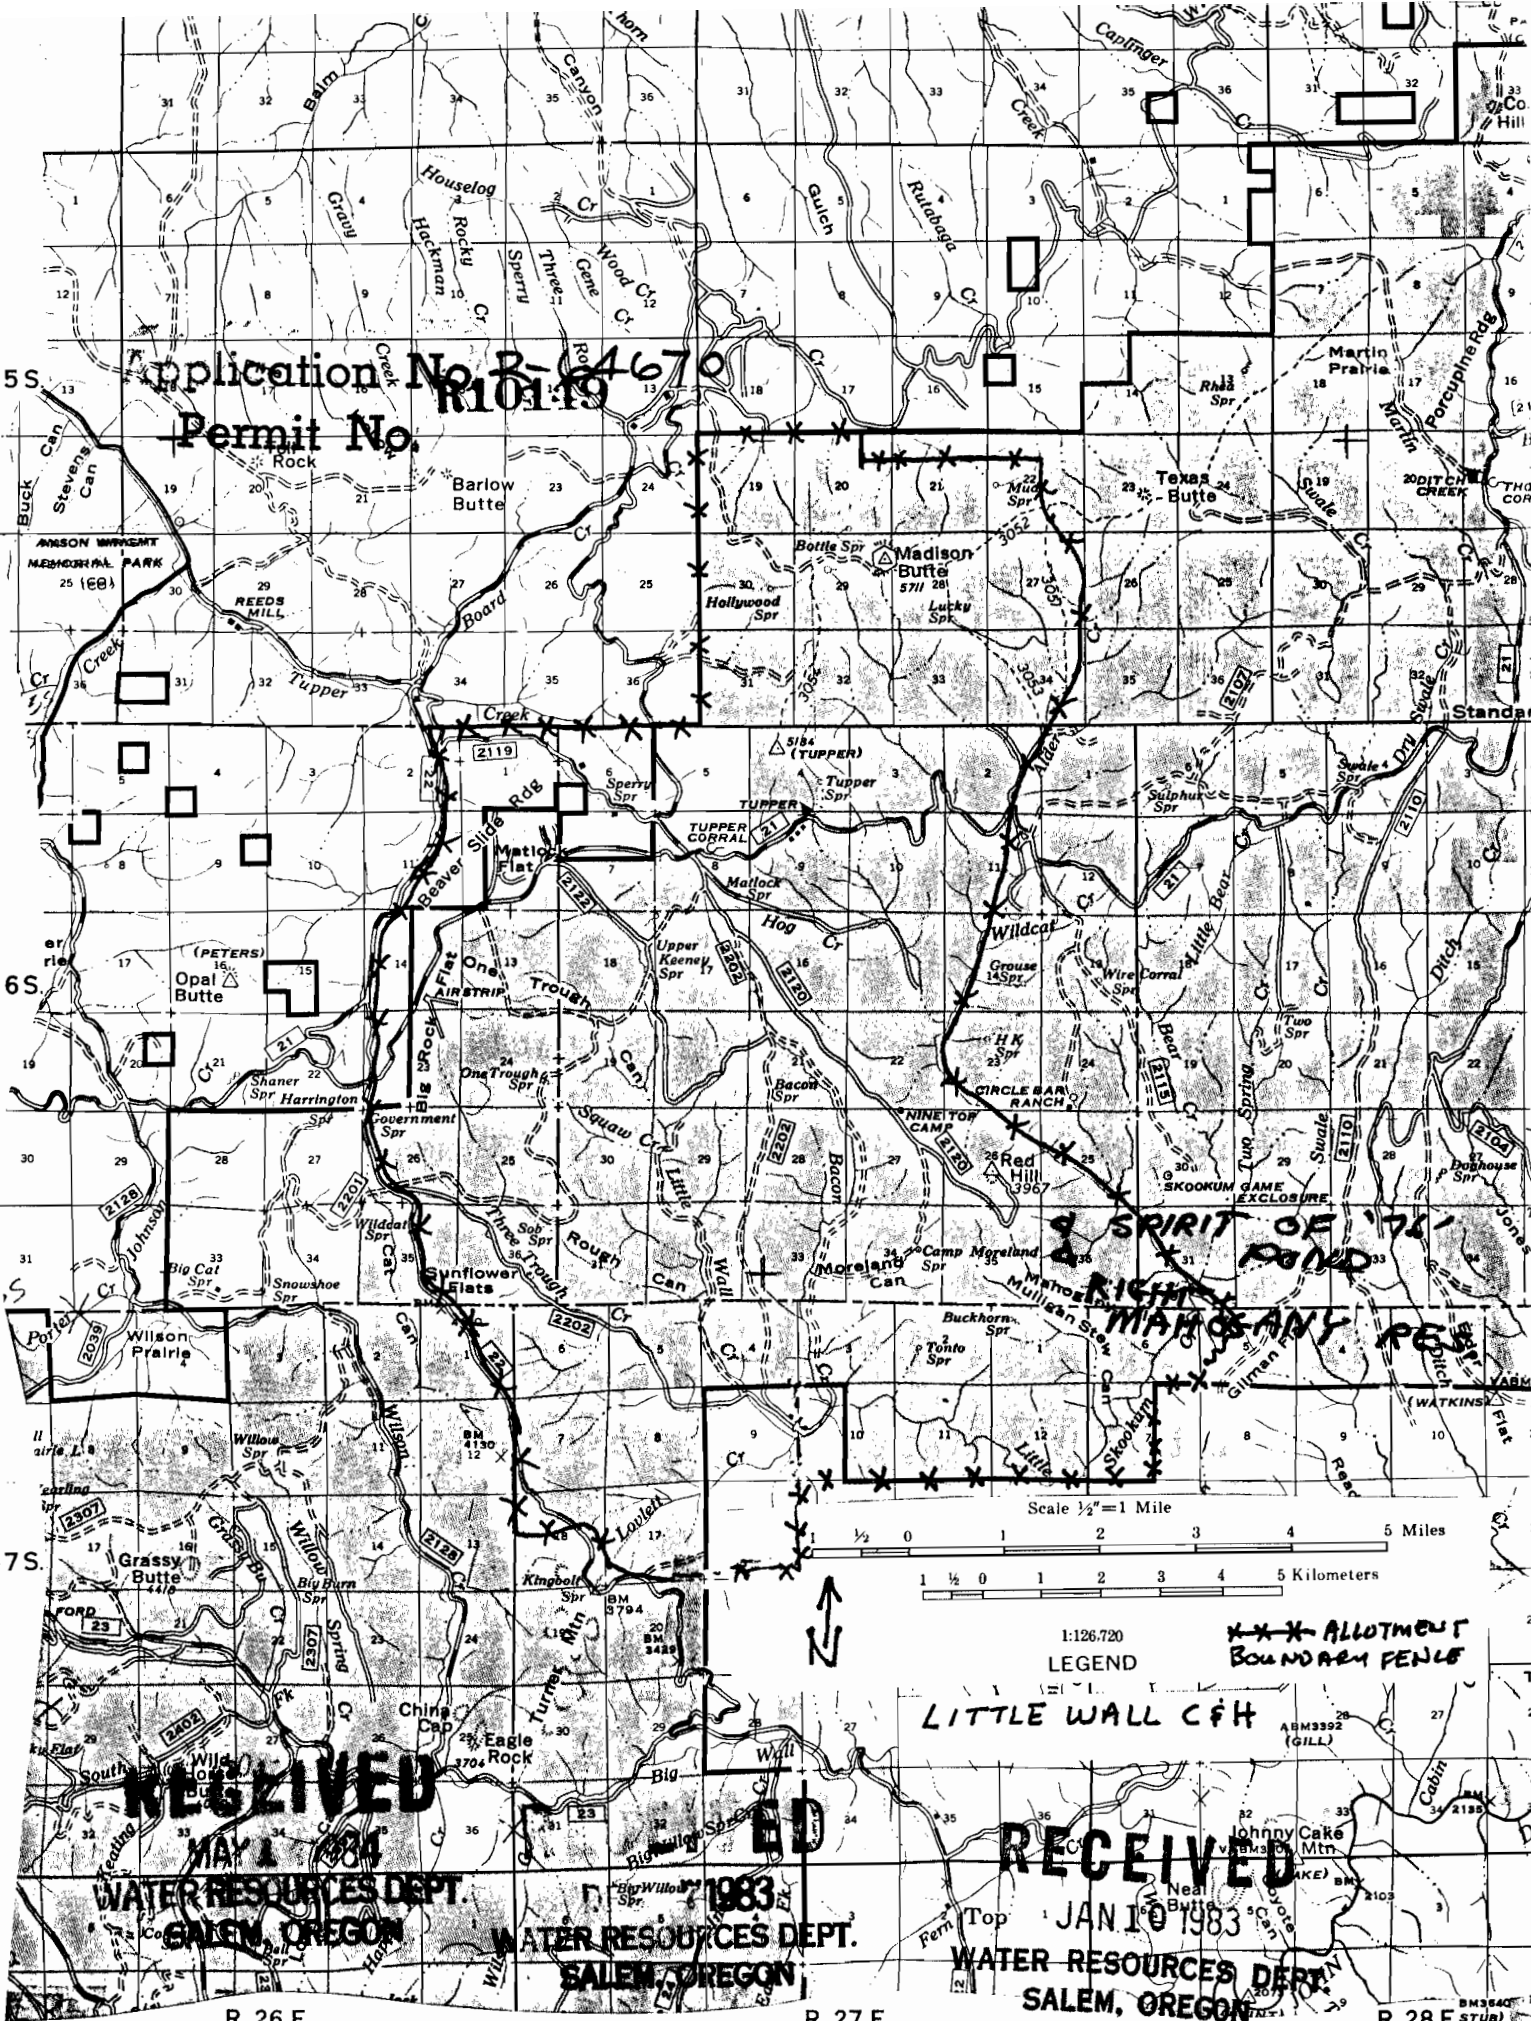

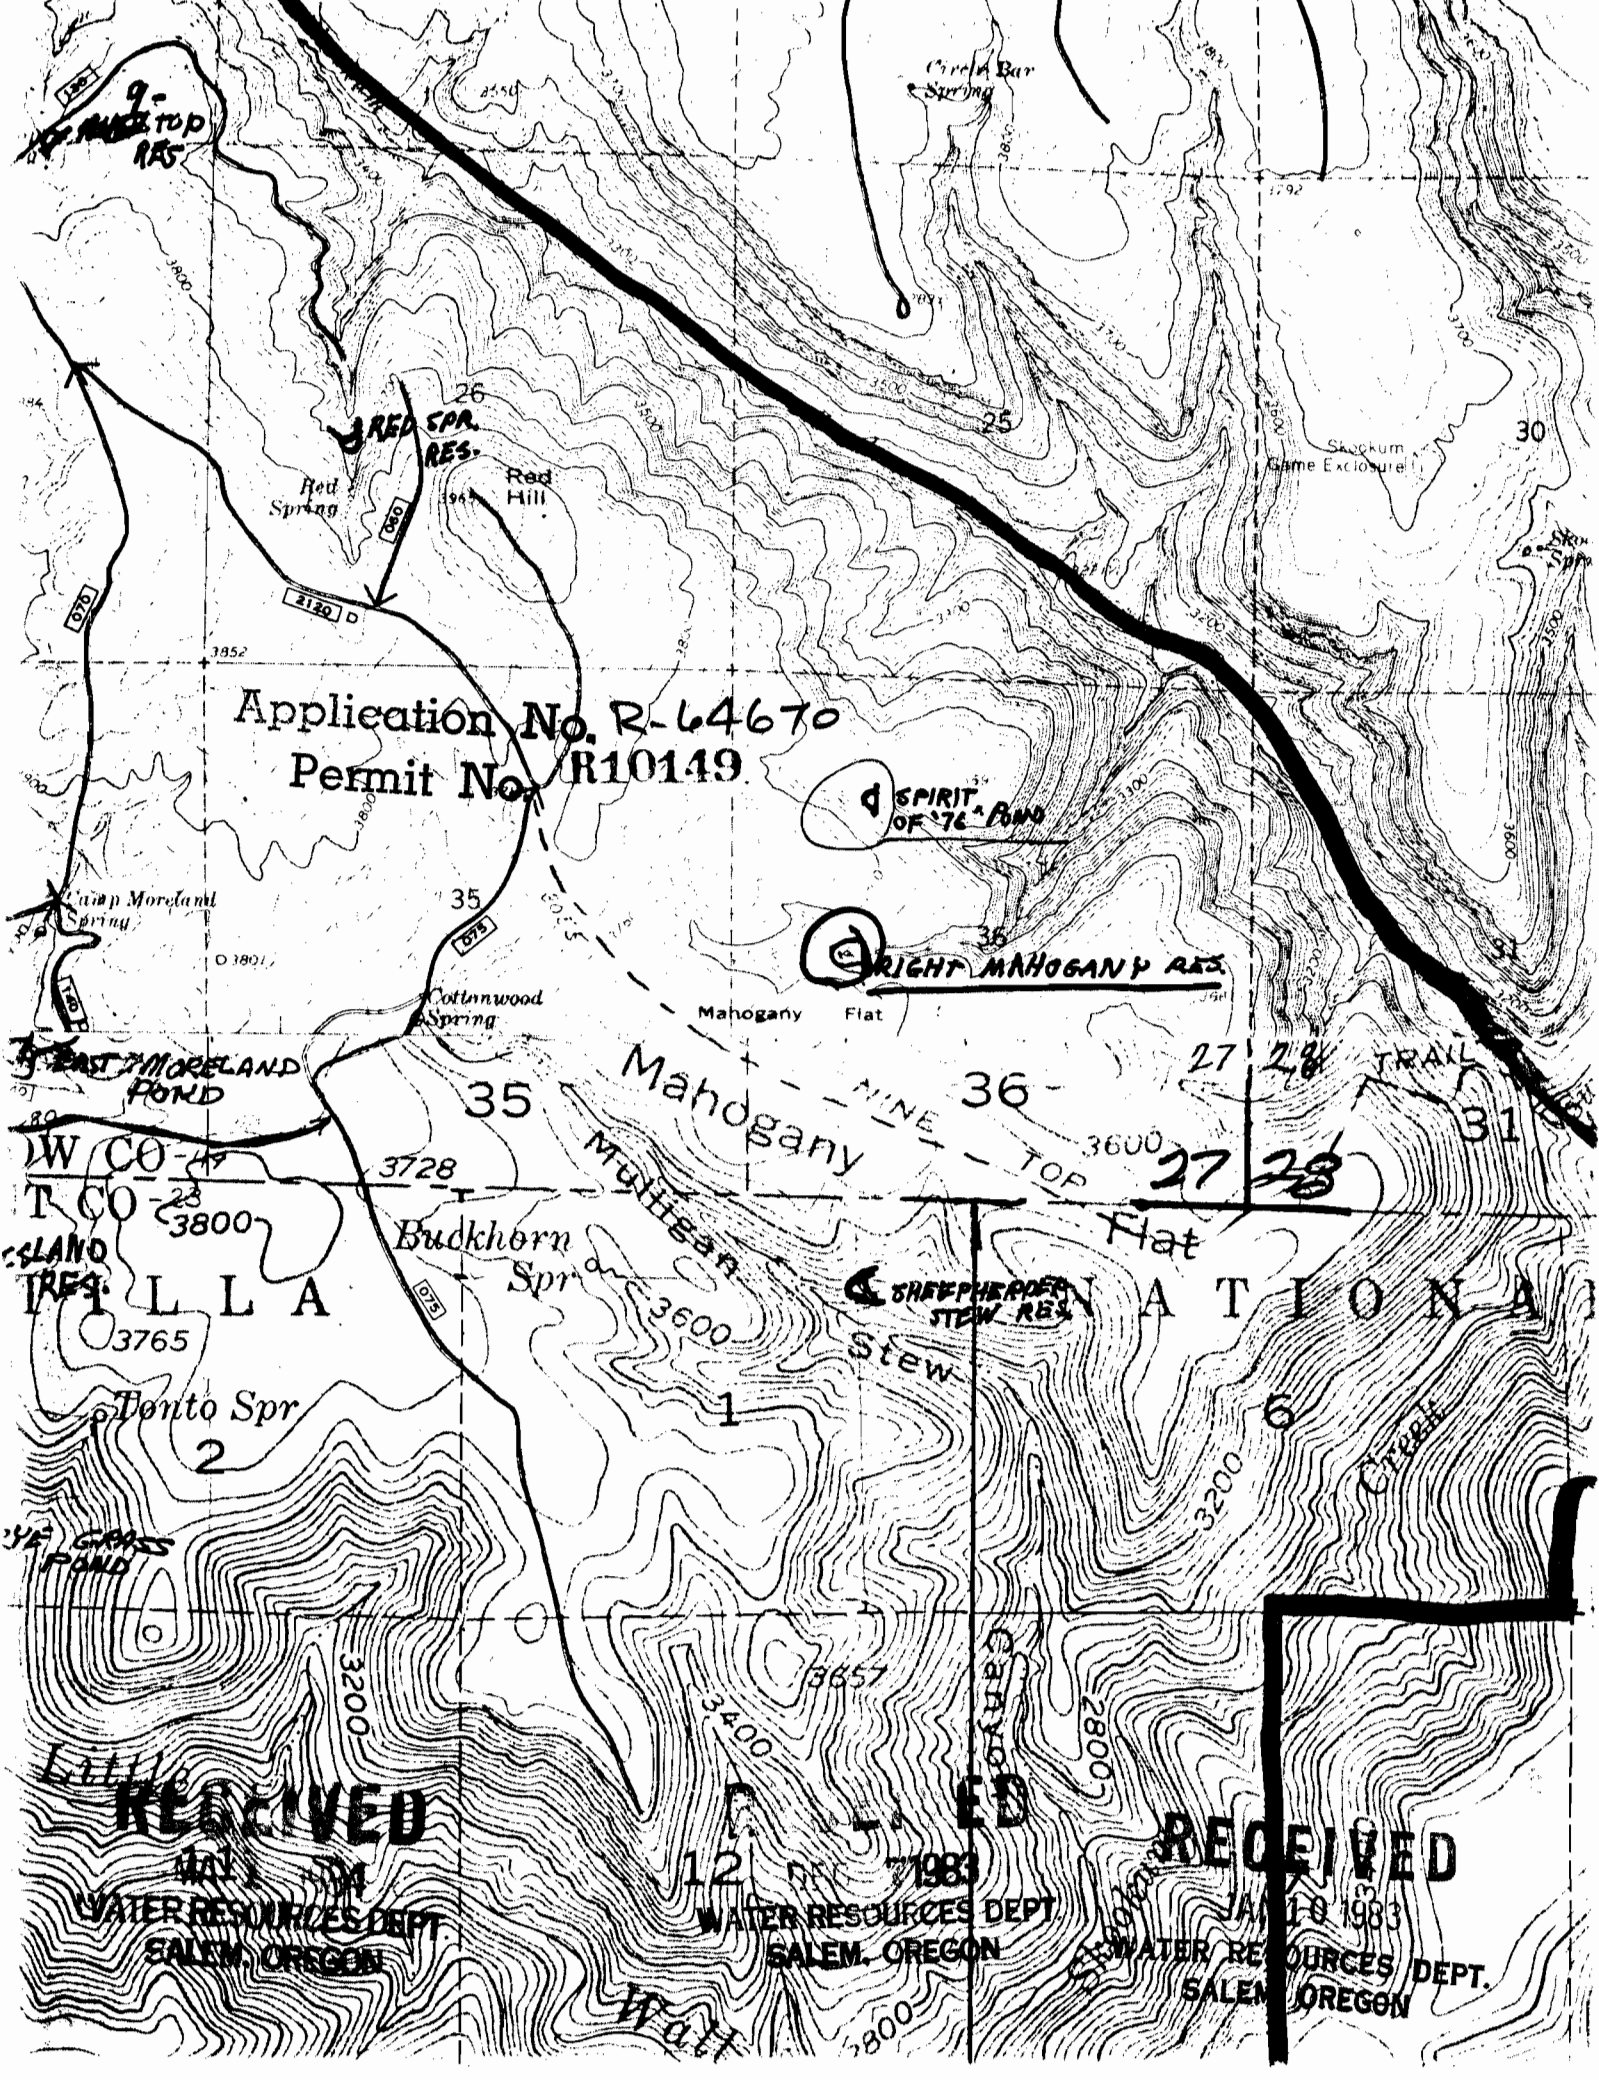

Application No. R-64670
Permit No. R10149


BRIGHT MAHOGANY RES.

MAHOGANY FLAT

SHEPHERD STEW. RES.

NATIONAL


RECEIVED

WATER RESOURCES DEPT.
SALEM, OREGON

WATER RESOURCES DEPT.
SALEM, OREGON

RECEIVED

WATER RESOURCES DEPT.
SALEM, OREGON

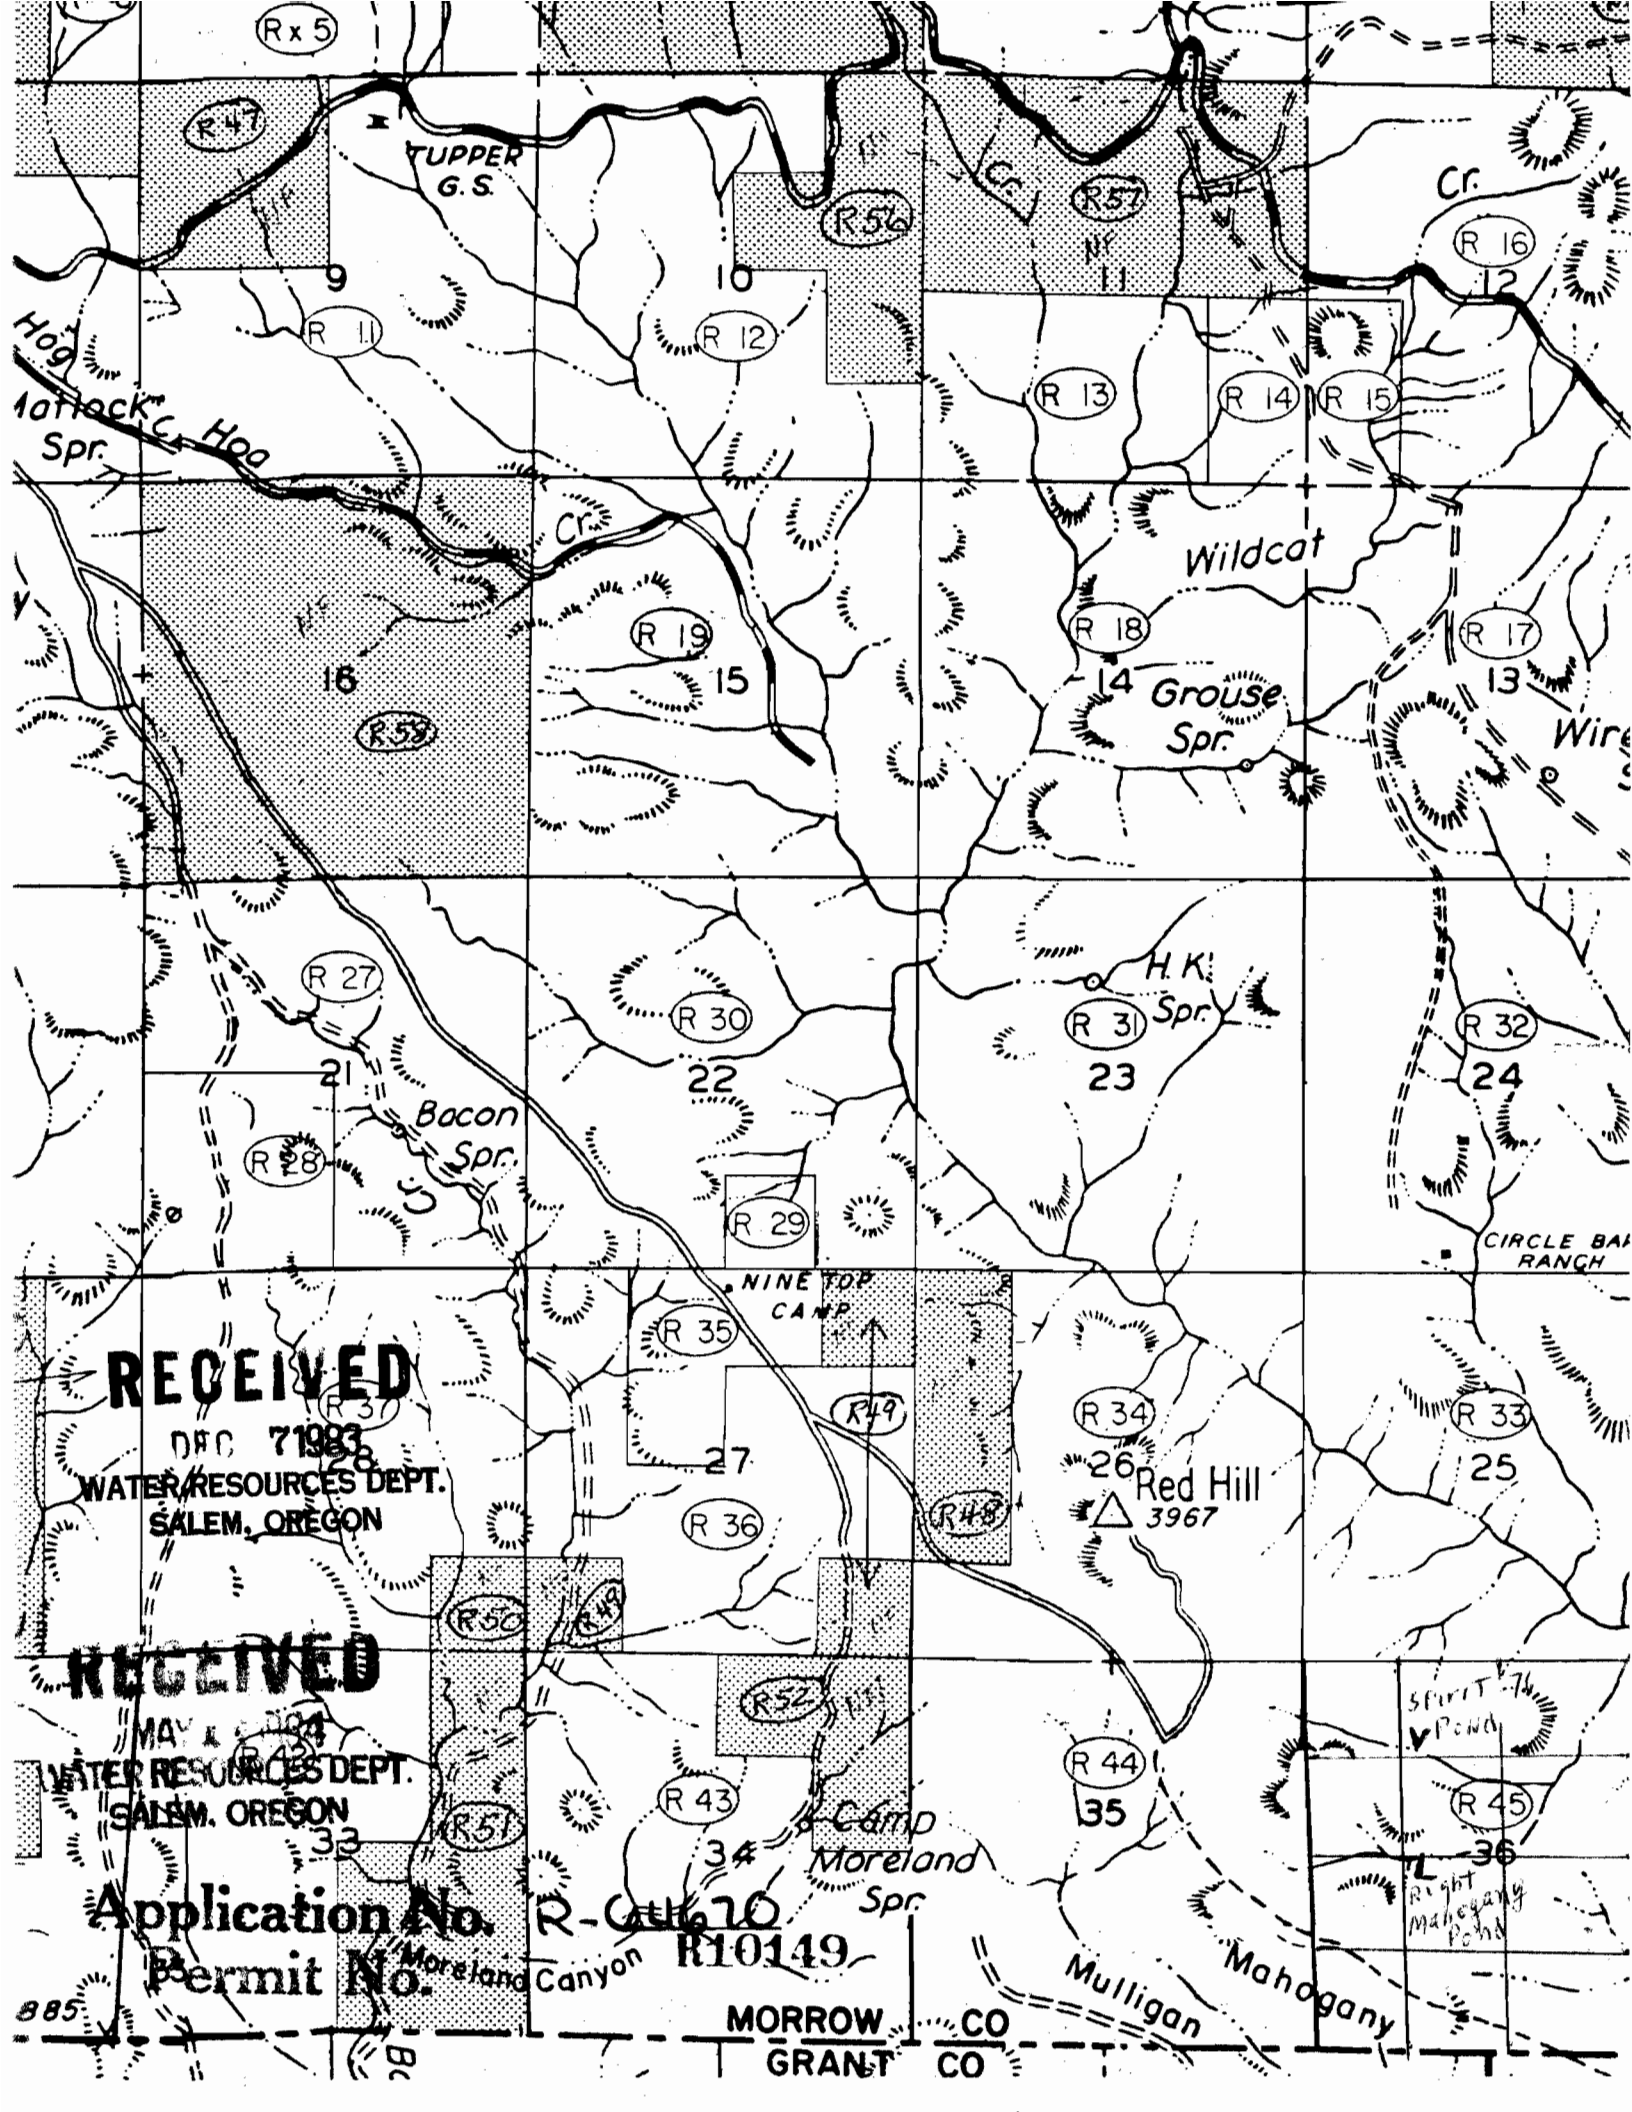

RECEIVED

DEC 7 1983
WATER RESOURCES DEPT.
SALEM, OREGON

RECEIVED

MAY 1 1984
WATER RESOURCES DEPT.
SALEM, OREGON

Permit No. R10149

MORROW GRANT CO CO


TOWNSHIP 6S, RANGE 27E, SECTION 36, W.M.

26

25

35

36

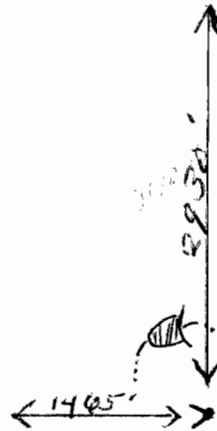

RECEIVED

MAY 1 1984
WATER RESOURCES DEPT.
SALEM, OREGON

RECEIVED

DEC 7 1983
WATER RESOURCES DEPT.
SALEM, OREGON

RECEIVED

JAN 10 1983

WATER RESOURCES DEPT.
SALEM, OREGON

NAME RIGHT MAHOGANY RES.

COUNTY MORROW

Application No. R-64670

Permit No. R10149

2A


TOWNSHIP 6S, RANGE 27E, SECTION 36, W.M.

26

25

35

36

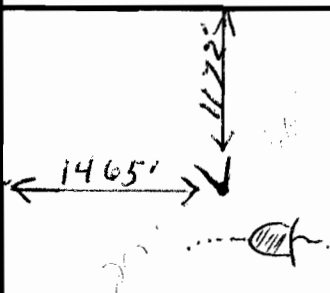

RECEIVED

MAY 1 1984
WATER RESOURCES DEPT.
SALEM, OREGON

RECEIVED

DEC 7 1983
WATER RESOURCES DEPT.
SALEM, OREGON

NAME SPIRIT OF '6 POND

COUNTY MORROW

RECEIVED

Application No. R-64670

Permit No. R10149 2B

JAN 10 1983
WATER RESOURCES DEPT.
SALEM, OREGON