

RECEIVED

DEC 7 1983

WATER RESOURCES DEPT
SALEM, OREGON

N

EAST MORELAND POND
T6S R27E SECTION 34

MORROW CO
GRANT CO

UMATILLA



Tonto Spr
2

T. 5 S.

T. 6 S.

T. 7 S.



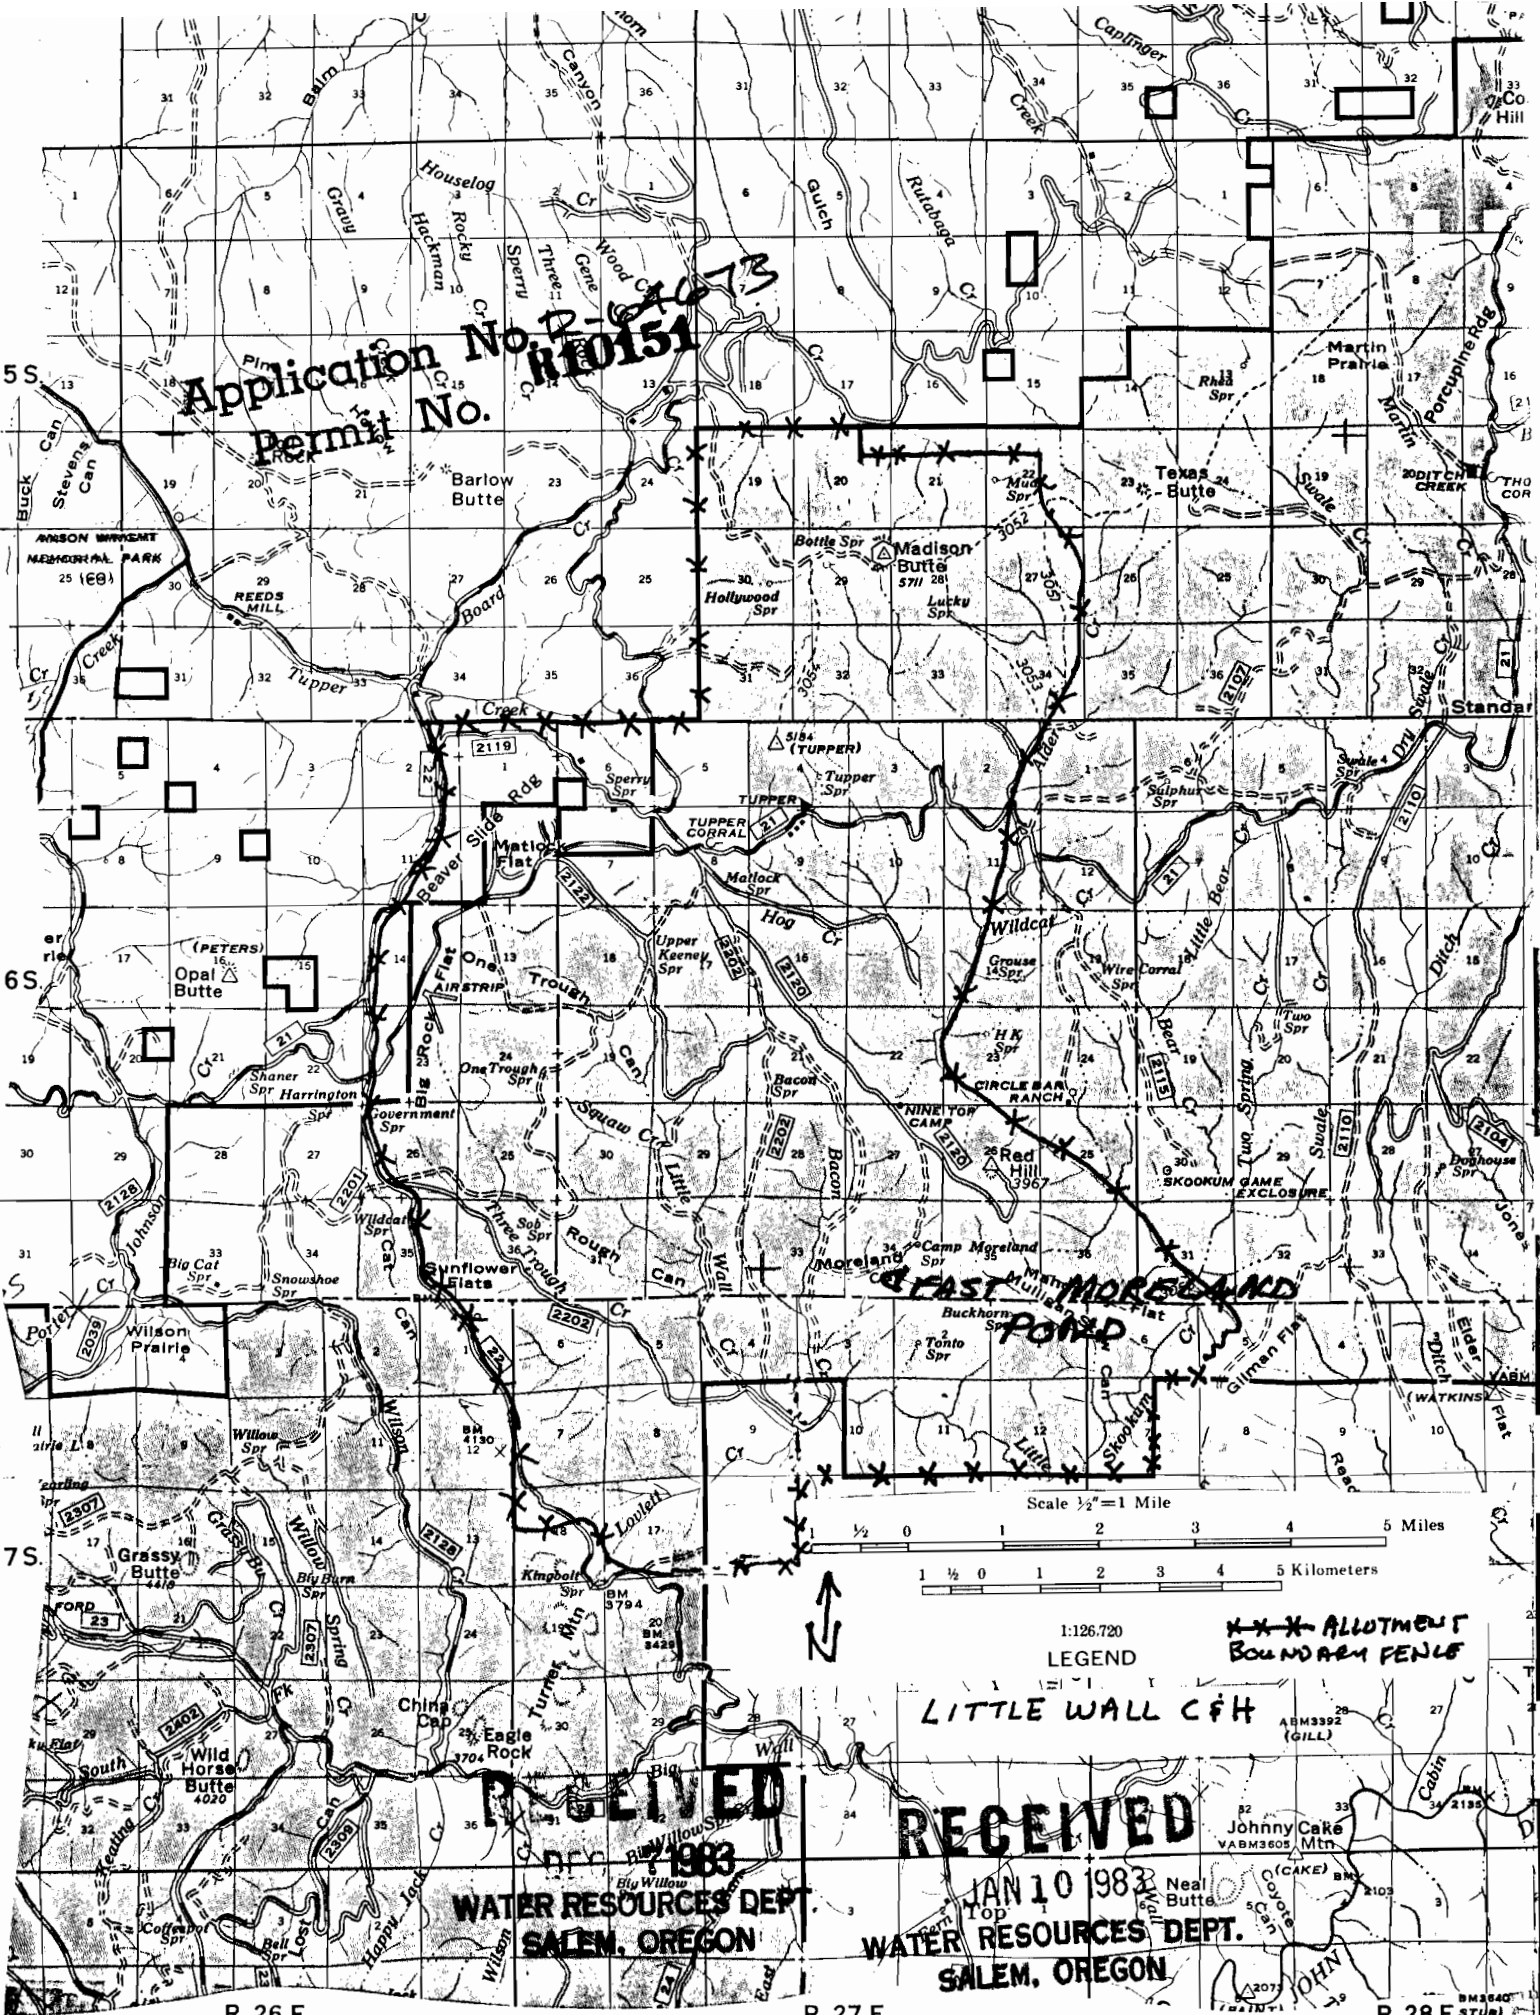

RECEIVED
JAN 10 1983
WATER RESOURCES DEPT.
SALEM, OREGON

RECEIVED
JAN 10 1983
WATER RESOURCES DEPT.
SALEM, OREGON

LEGEND
*** ALLOTMENT
BOUNDARY FENCE
LITTLE WALL C&H
ARM3392 (GILL)
JOHNNY CAKE
VABM3605 Mtn.
(CAKE) BM
NEAL BUTTE
SC CO
JOHN
R. 26 E. R. 27 E. R. 28 E.

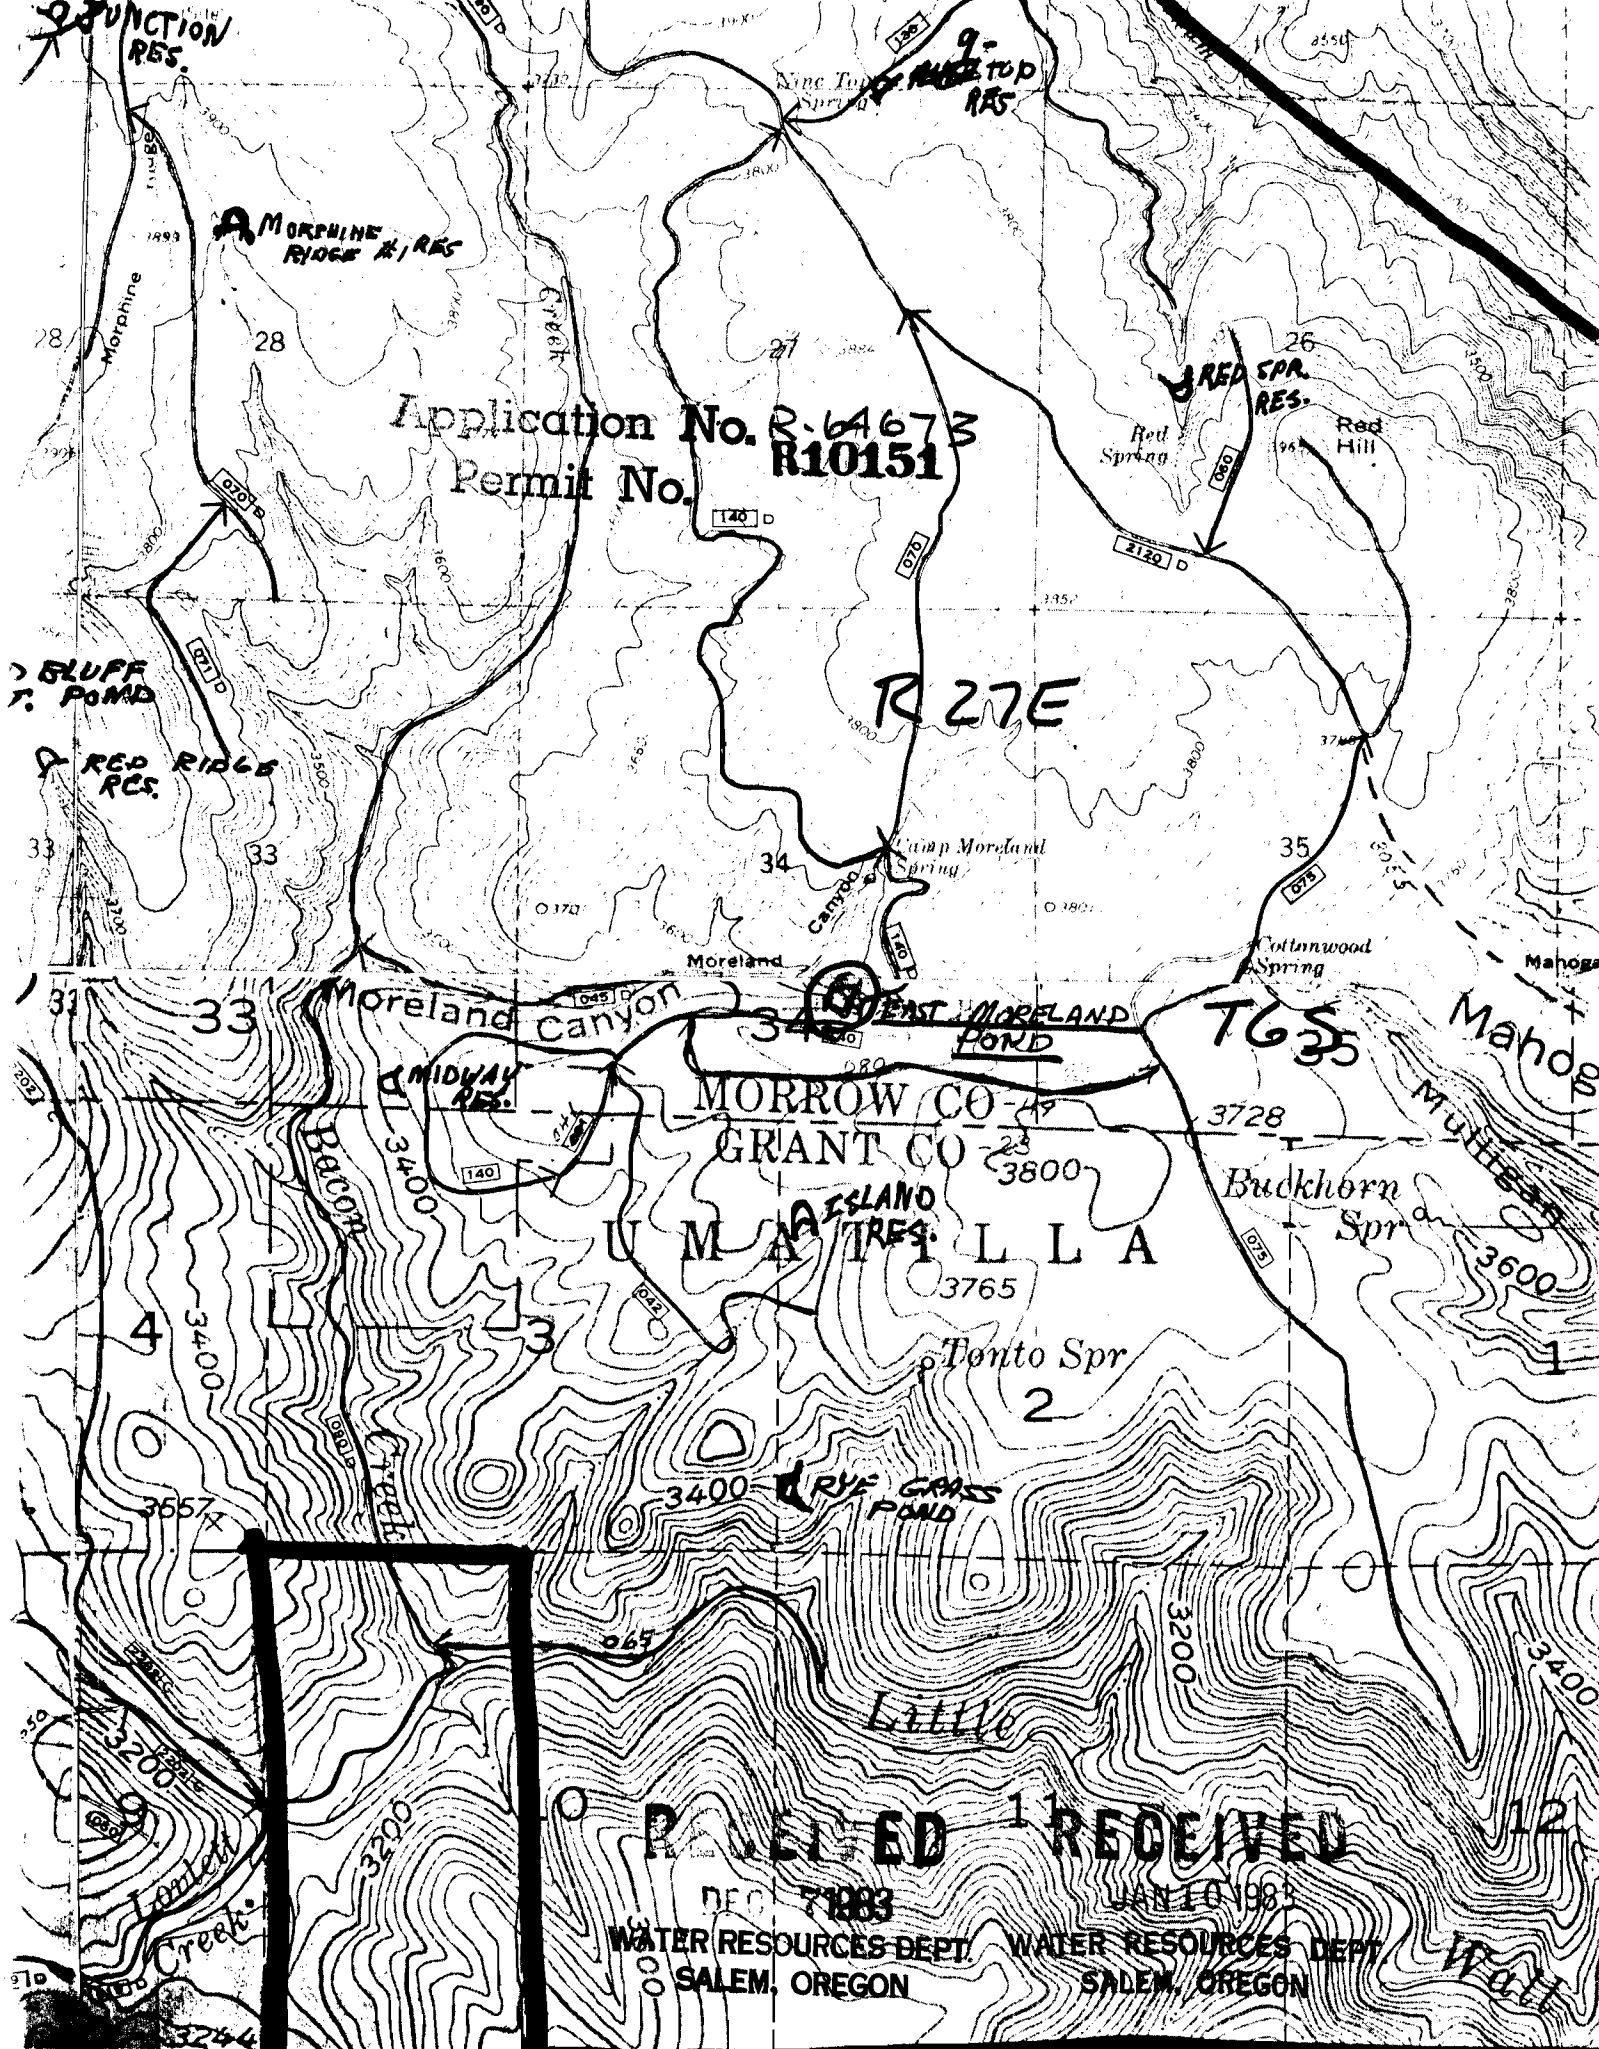

Application No. R-64673
Permit No. R10151

R 27E

EAST MORELAND POND

MORROW CO
GRANT CO

U M A T L L A

ASLAND TRES.

3765

Tonto Spr

2

3400

RYE GRASS POND

3200

Little

3200






RECEIVED

DEC 7 1983


WATER RESOURCES DEPT
SALEM, OREGON

RECEIVED

JAN 10 1983

WATER RESOURCES DEPT
SALEM, OREGON

Walt

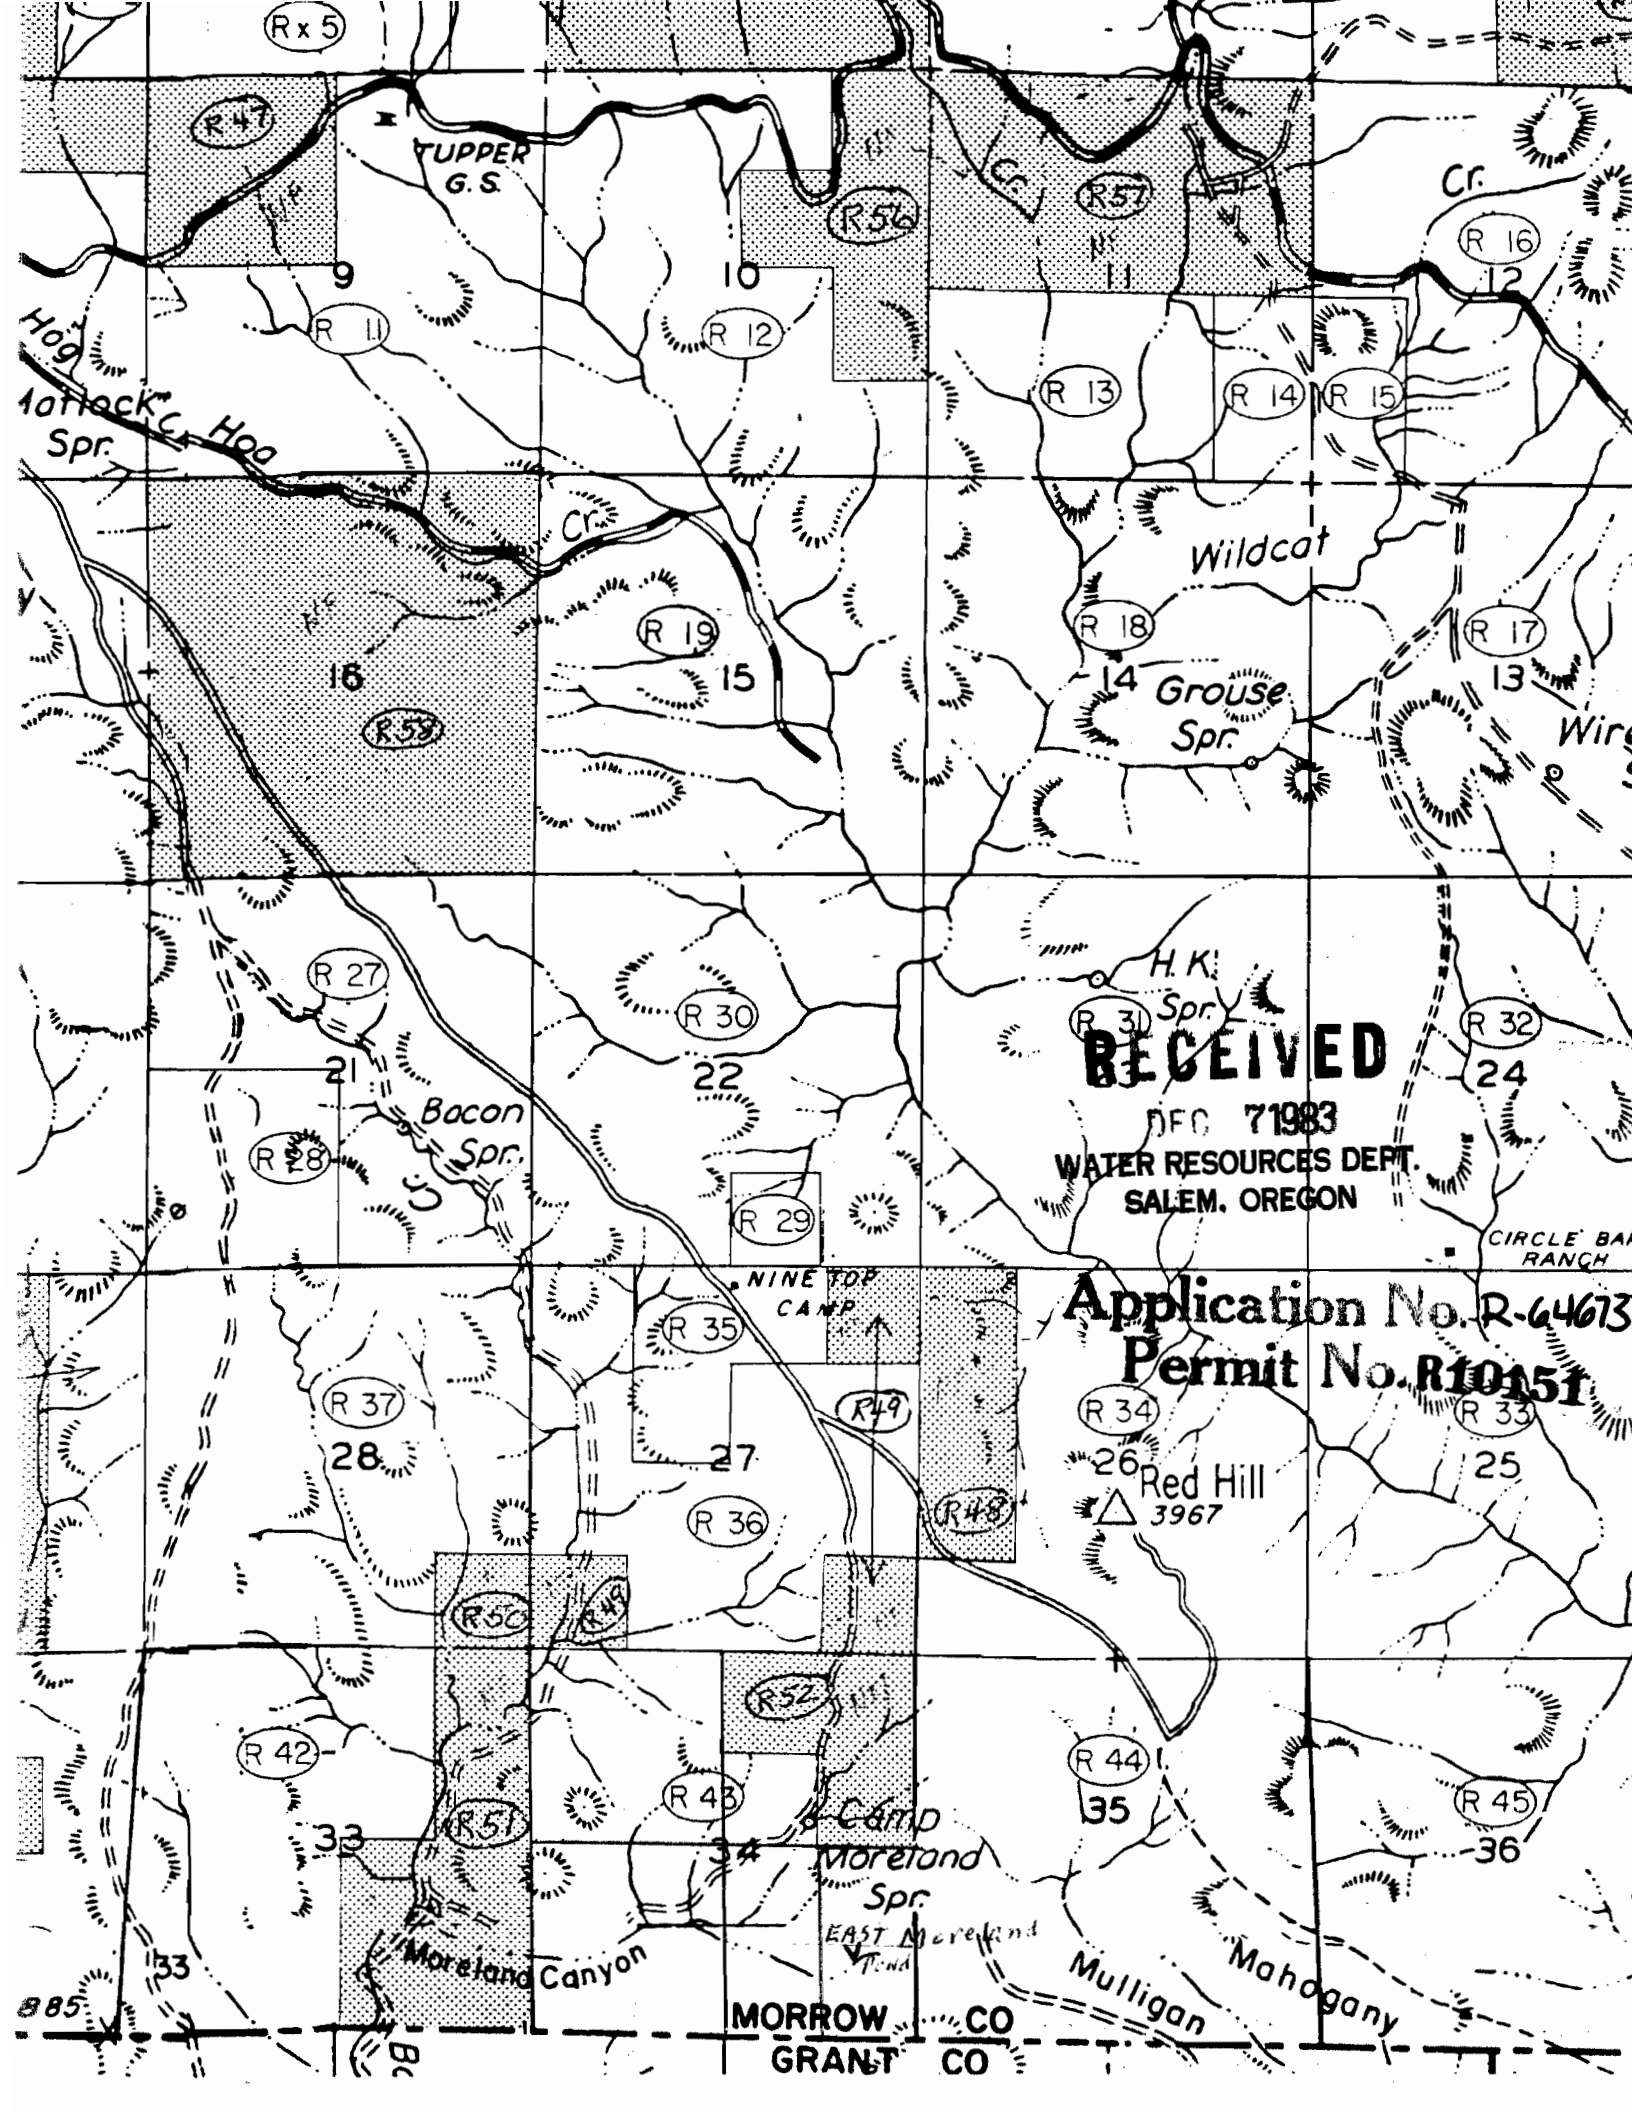

RECEIVED

DEC 7 1983
WATER RESOURCES DEPT.
SALEM, OREGON

Application No. R-64673
Permit No. R10151


TOWNSHIP 65, RANGE 27E, SECTION 34, W.M.

27

26

34

35

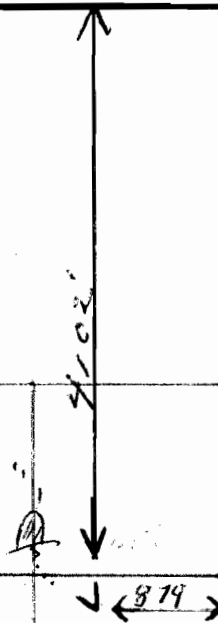

RECEIVED

DEC 7 1983

WATER RESOURCES DEPT.

SALEM, OREGON **RECEIVED**

JAN 10 1983

WATER RESOURCES DEPT.
SALEM, OREGON

NAME EAST MORELAND POND

COUNTY MORROW

Application No. R-64673

Permit No.

5