

Morphine Ridge Res.
#1 T6S R27E
section 28

RECEIVED

DEC 17 1983
WATER RESOURCES DEPT
SALEM, OREGON

Application No. R-6-1015
Permit No. R10152

MORROW CO
GRANT CO

Application No. R 164615
Permit No. R10152

T. 5 S.

T. 6 S.

T. 7 S.

R. 26 E.


R. 27 E.


R. 28 E.

WATER RESOURCES DEPT.
SALEM, OREGON

RECEIVED
JAN 10 1983

WATER RESOURCES DEPT.
SALEM, OREGON

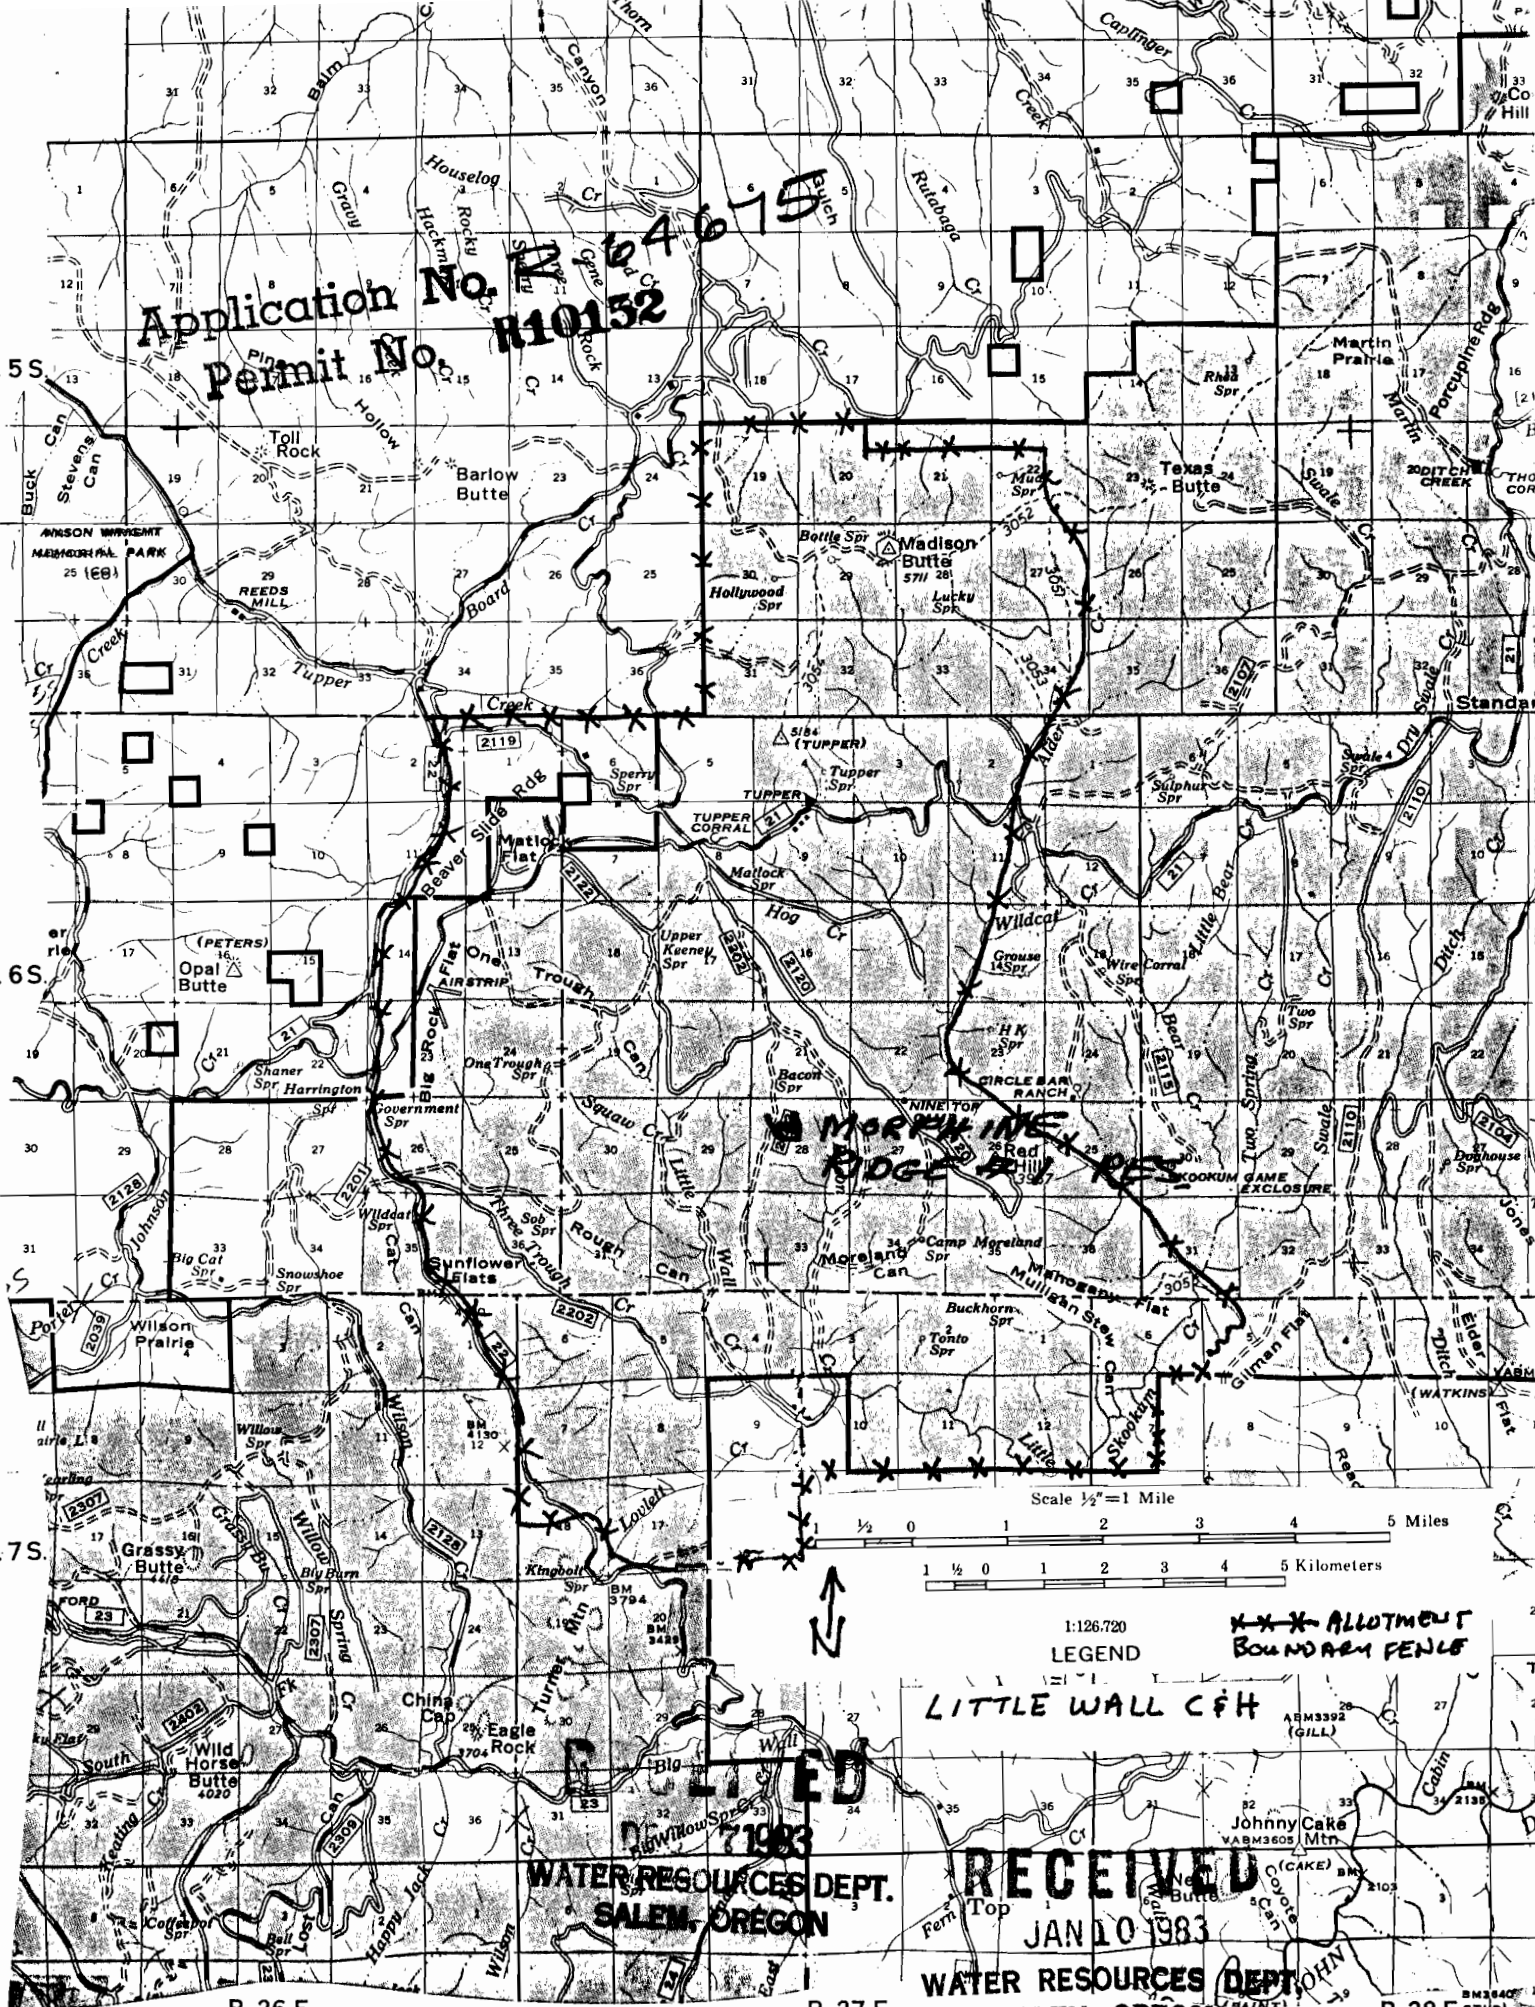

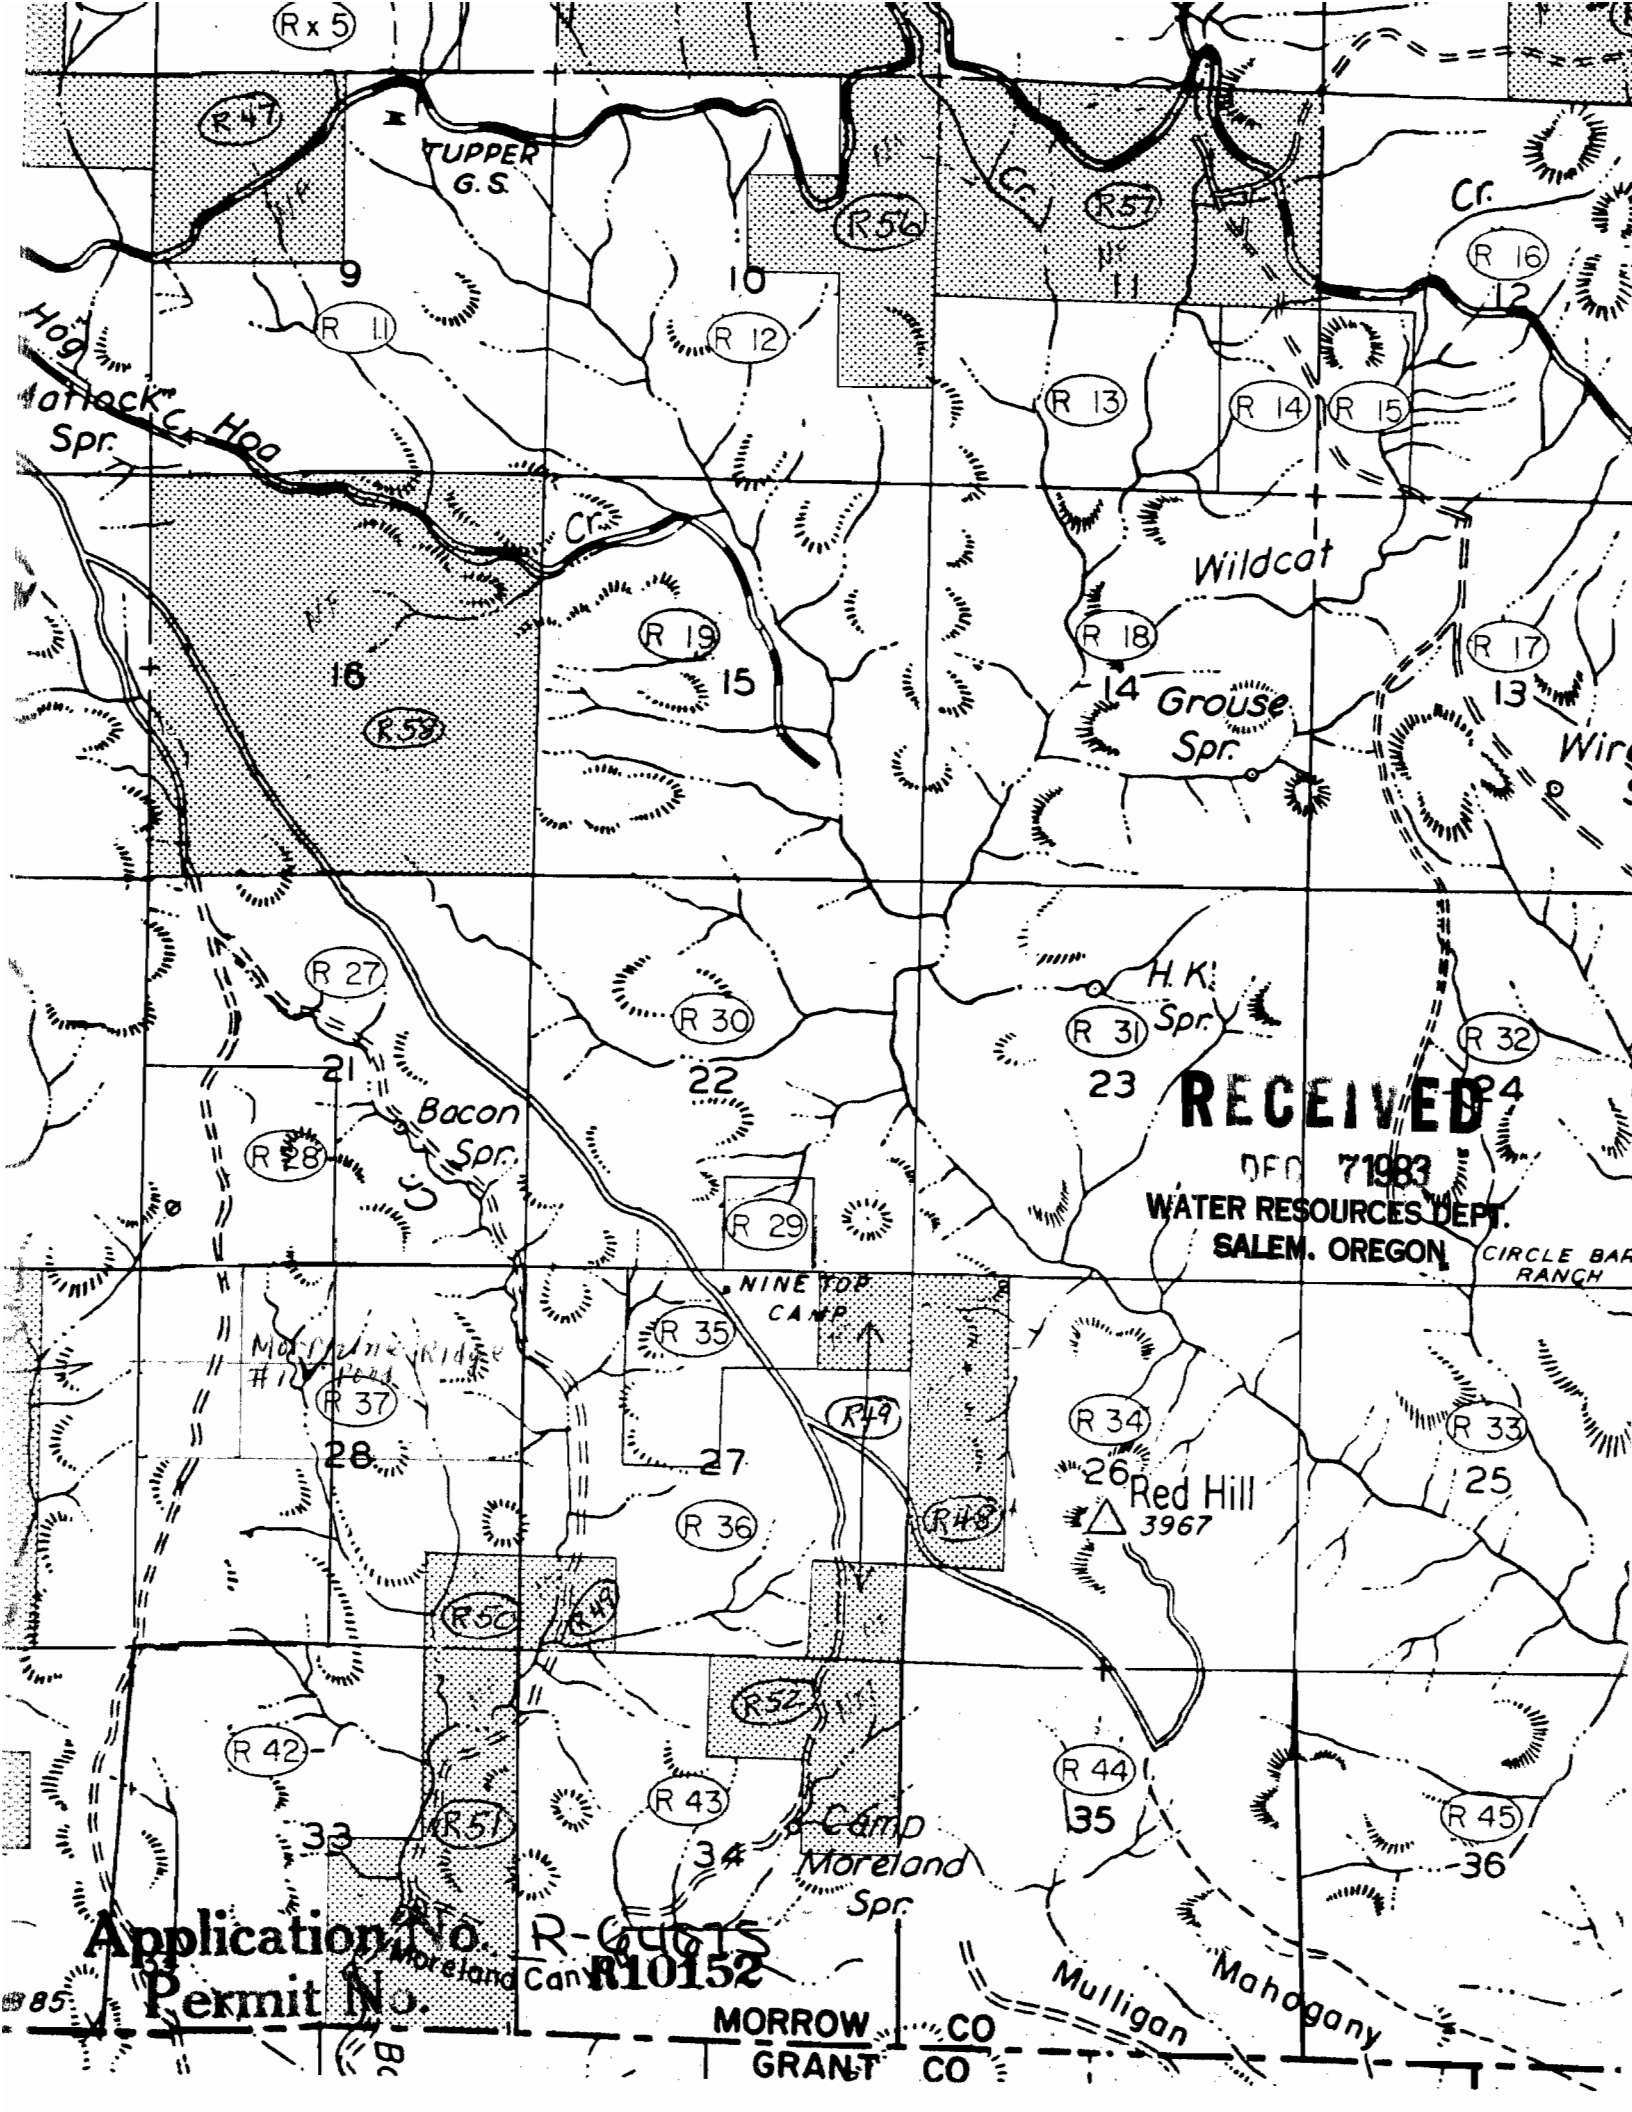

RECEIVED

DEC 7 1983

WATER RESOURCES DEPT.
SALEM, OREGON

CIRCLE BAR RANCH

Application No. R-64615
Permit No. R10152

MORROW CO
GRANT CO

Application No. R-64675
Permit No. R10152

RECEIVED
JAN 10 1983
WATER RESOURCES DEPT.
SALEM, OREGON


TOWNSHIP 6S, RANGE 27E, SECTION 28, W.M.

20

21

29

28

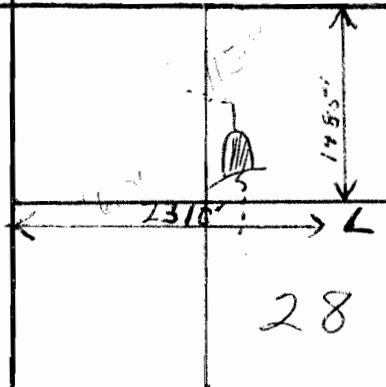

RECEIVED

DEC 7 1983

WATER RESOURCES DEPT.
SALEM, OREGON

NAME MORPHINE RIDGE RES. #1 COUNTY MORROW

RECEIVED

JAN 10 1983

WATER RESOURCES DEPT.
SALEM, OREGON

Application No. R-646757
Permit No. R10152