

RECEIVED

AUG 25 1983

WATER RESOURCES DEPT.
SALEM, OREGON

KEENE

T65

Morphine Ranch

Application No. R-64678


Permit No. R10154

Bacon Spring

MORELAND

R27E

WIDE
TOP
POND

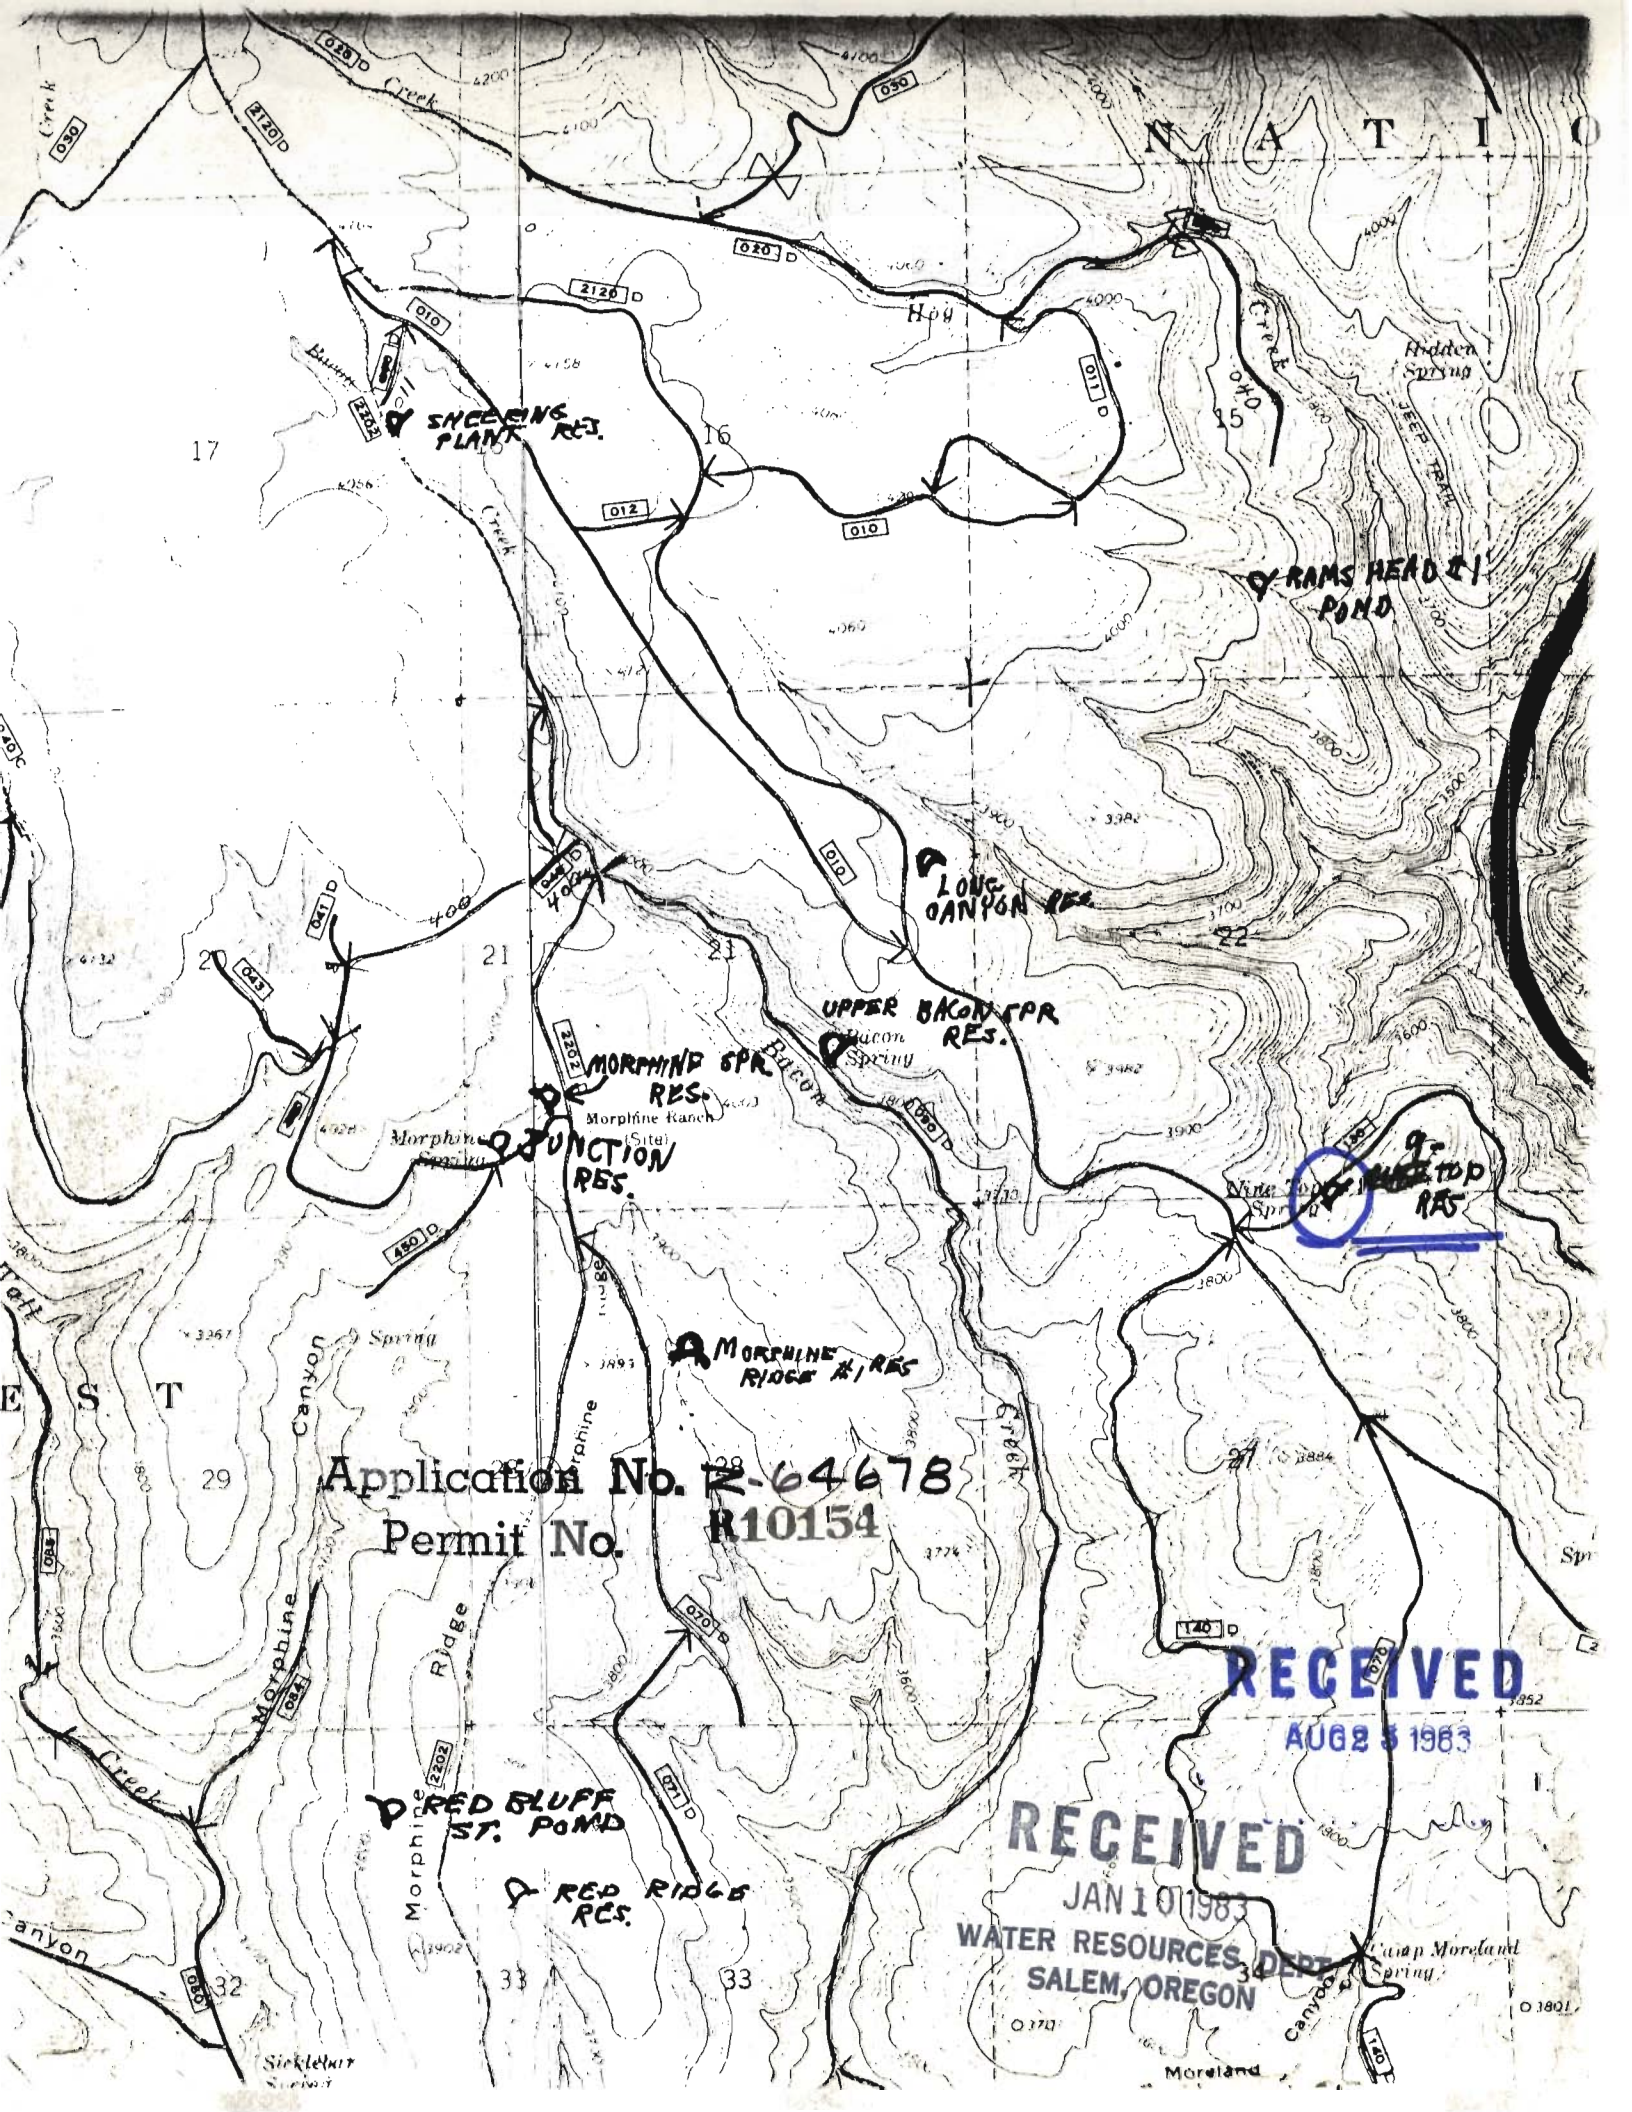

Application No. **R-64678**
Permit No. **R10154**

RECEIVED
AUG 3 1983

RECEIVED
JAN 10 1983
WATER RESOURCES DEPT
SALEM, OREGON

RECEIVED


AUG 25 1983

WATER RESOURCES DEPT.
SALEM, OREGON

T. 5 S.

T. 6 S.

T. 7 S.

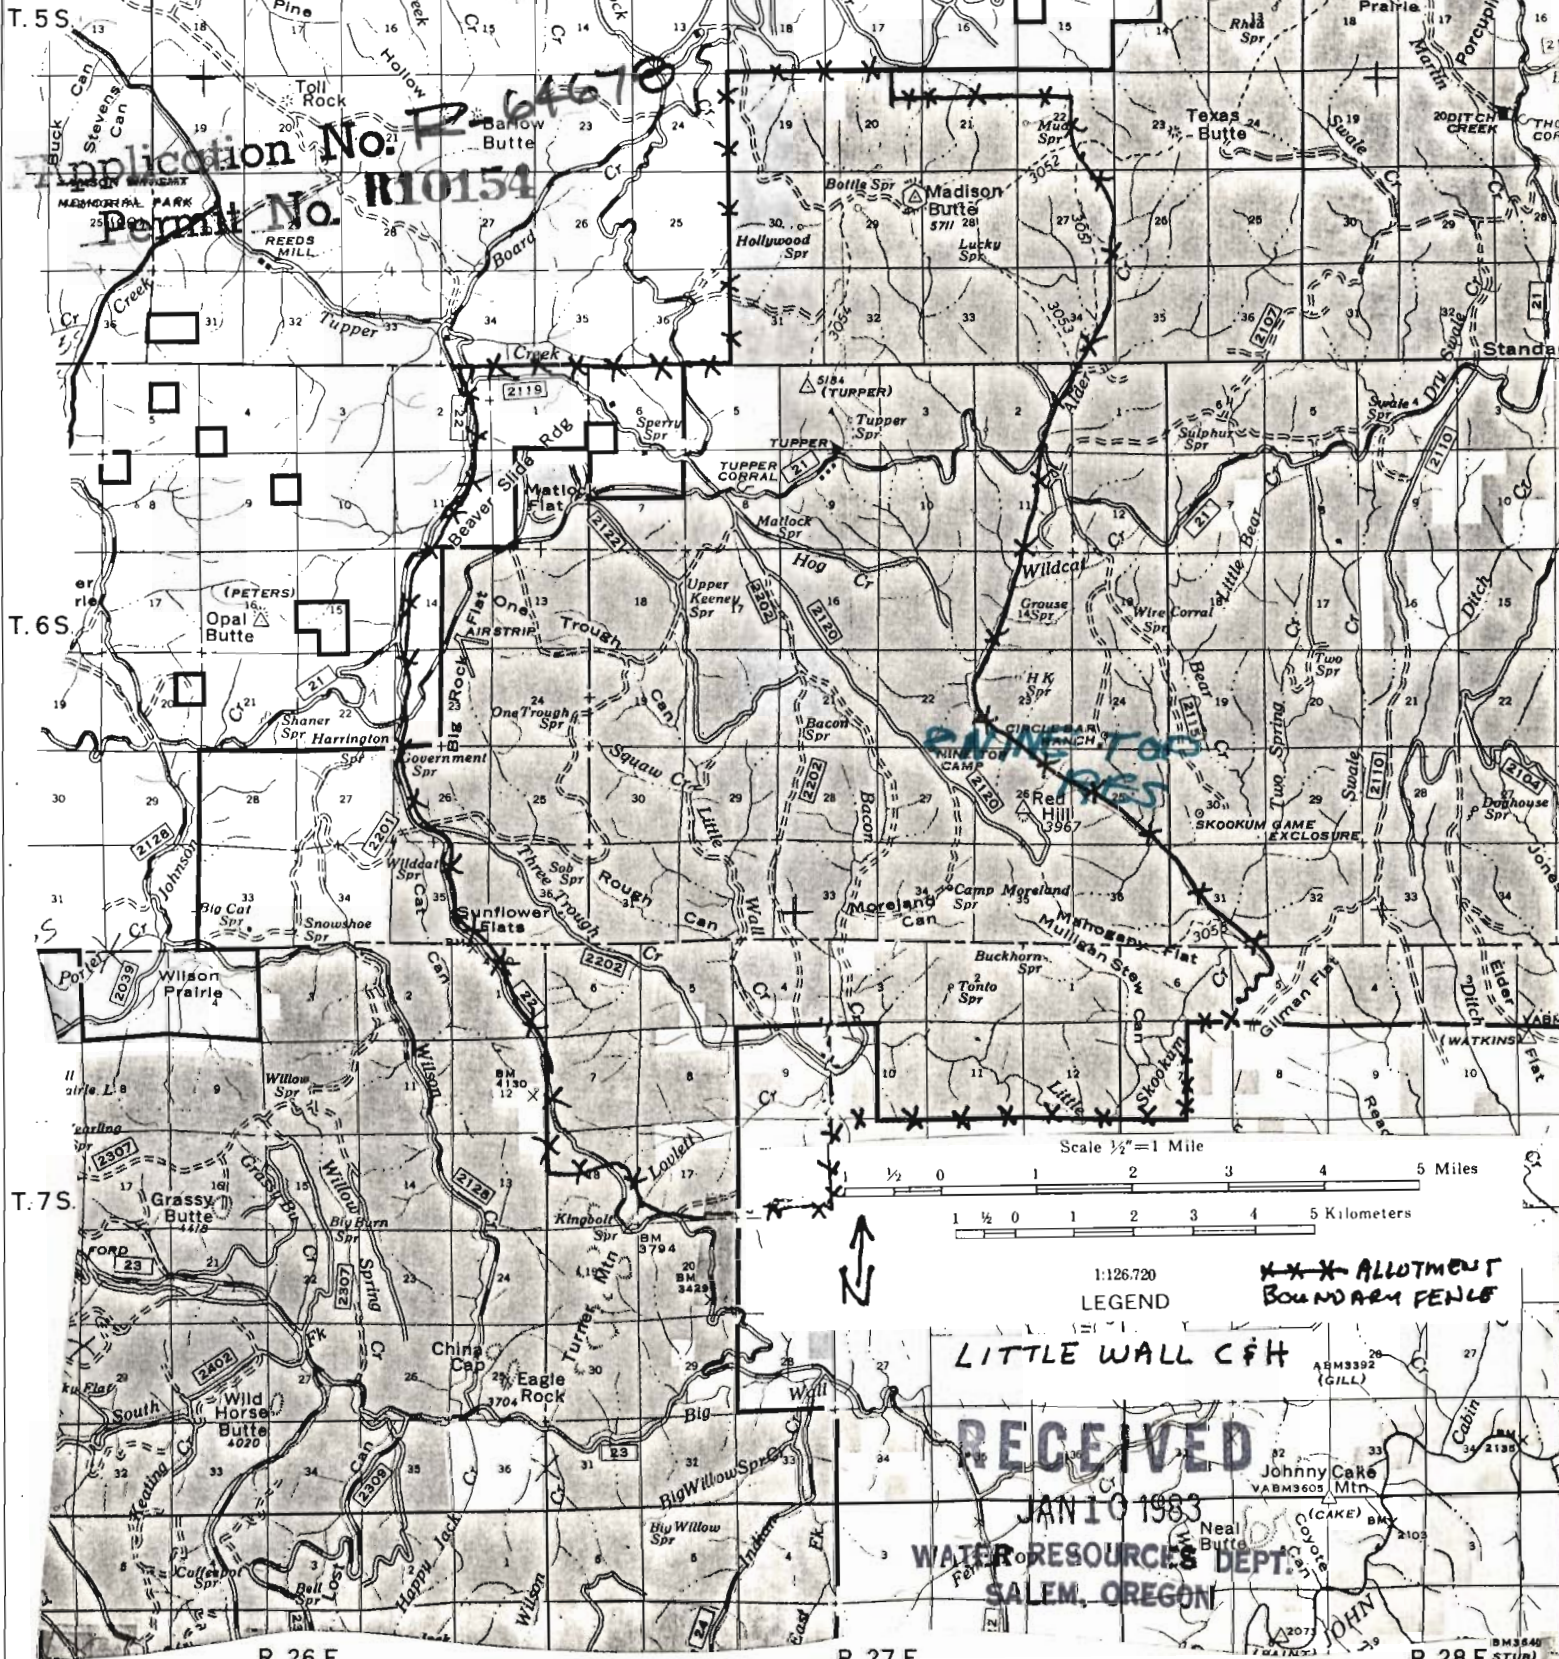


R. 26 E.

R. 27 E.

R. 28 E.

TOWNSHIP 65, RANGE 27E, SECTION 22, H.M.

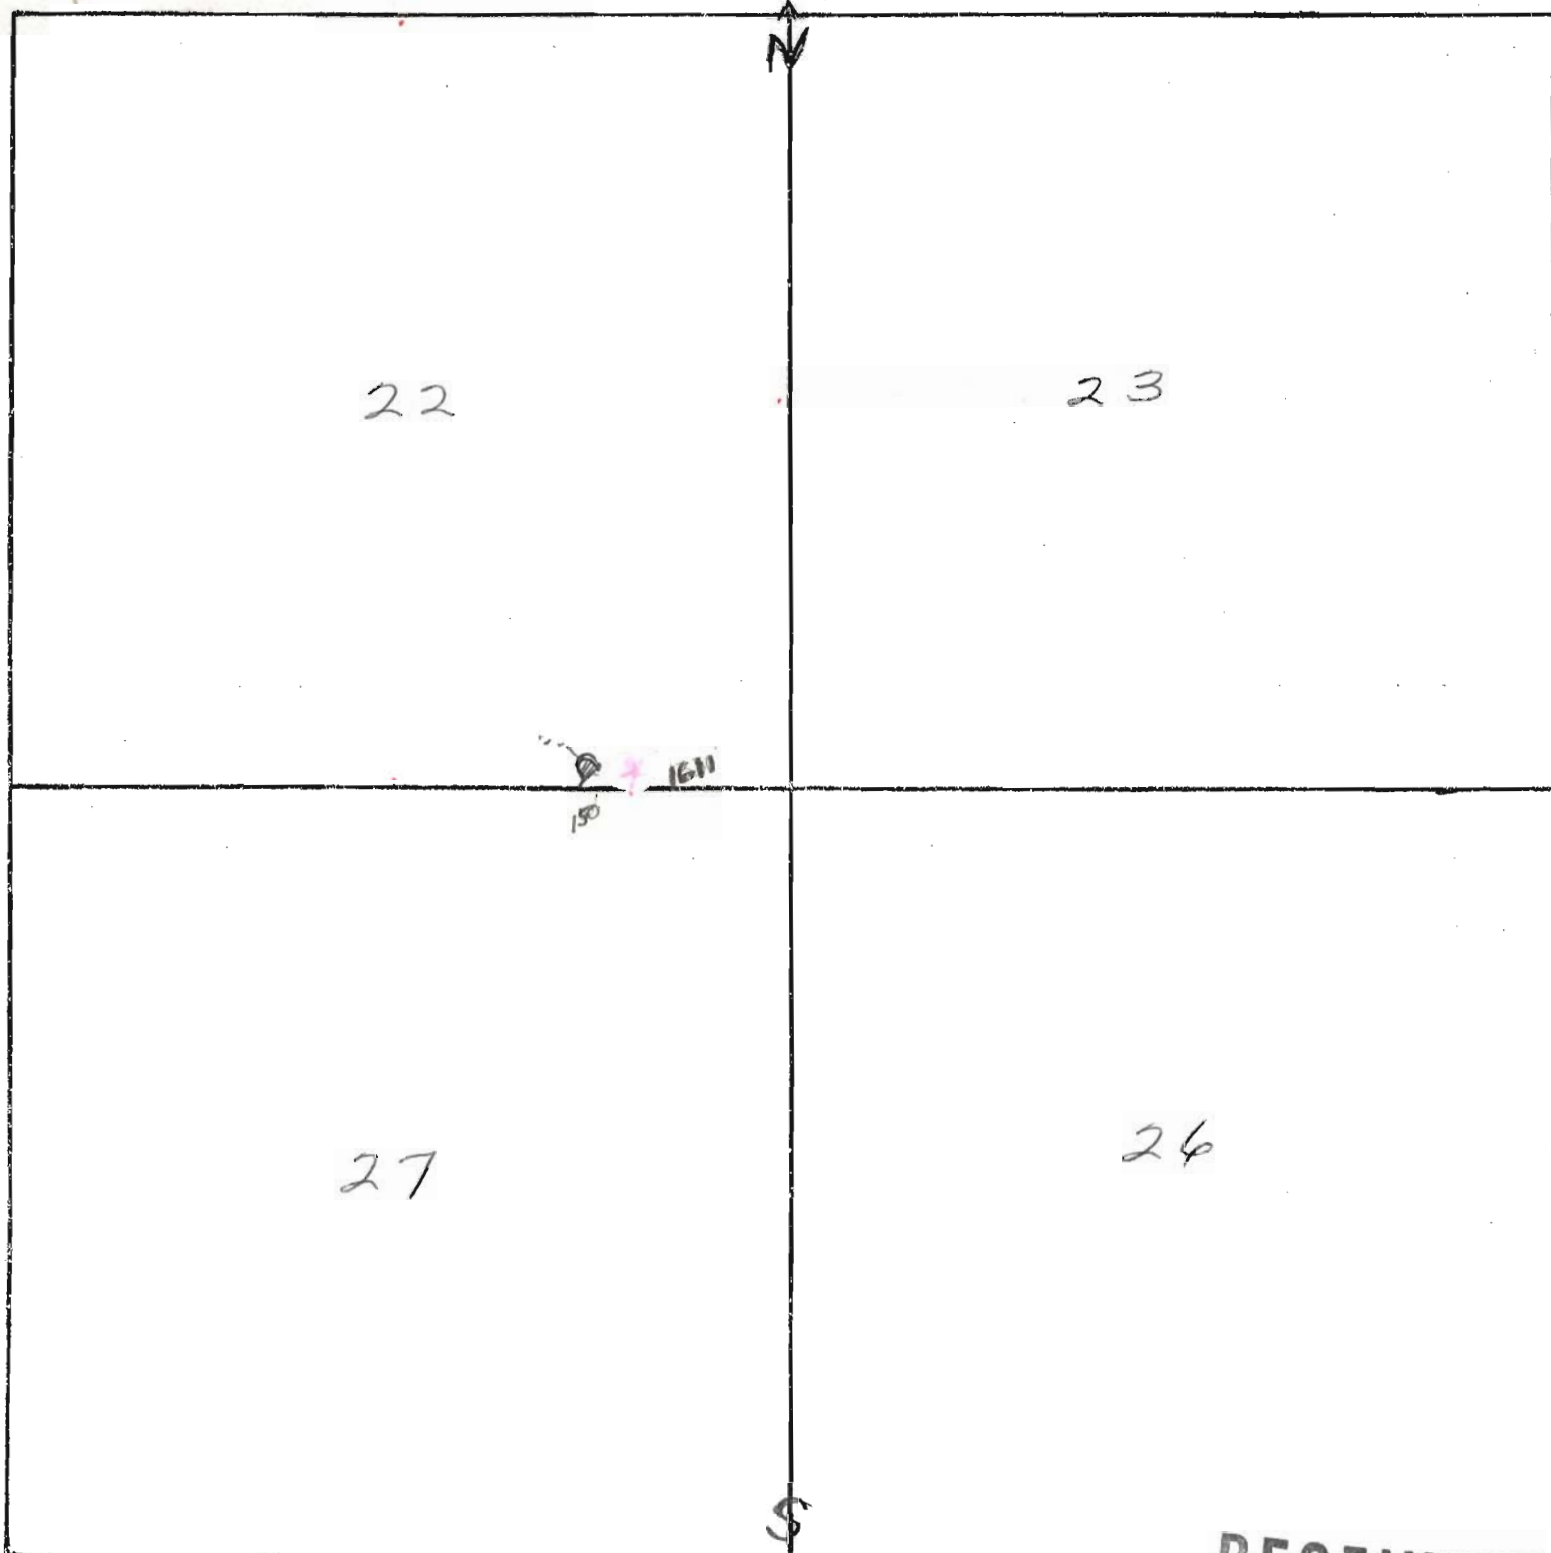

NAME 9-TOP

COUNTY MORROW

Application No. R-64678
Permit No. R10154

10

RECEIVED

AUG 25 1983

WATER RESOURCES DEPT.
SALEM, OREGON

RECEIVED

JAN 10 1983

WATER RESOURCES DEPT.
SALEM, OREGON