


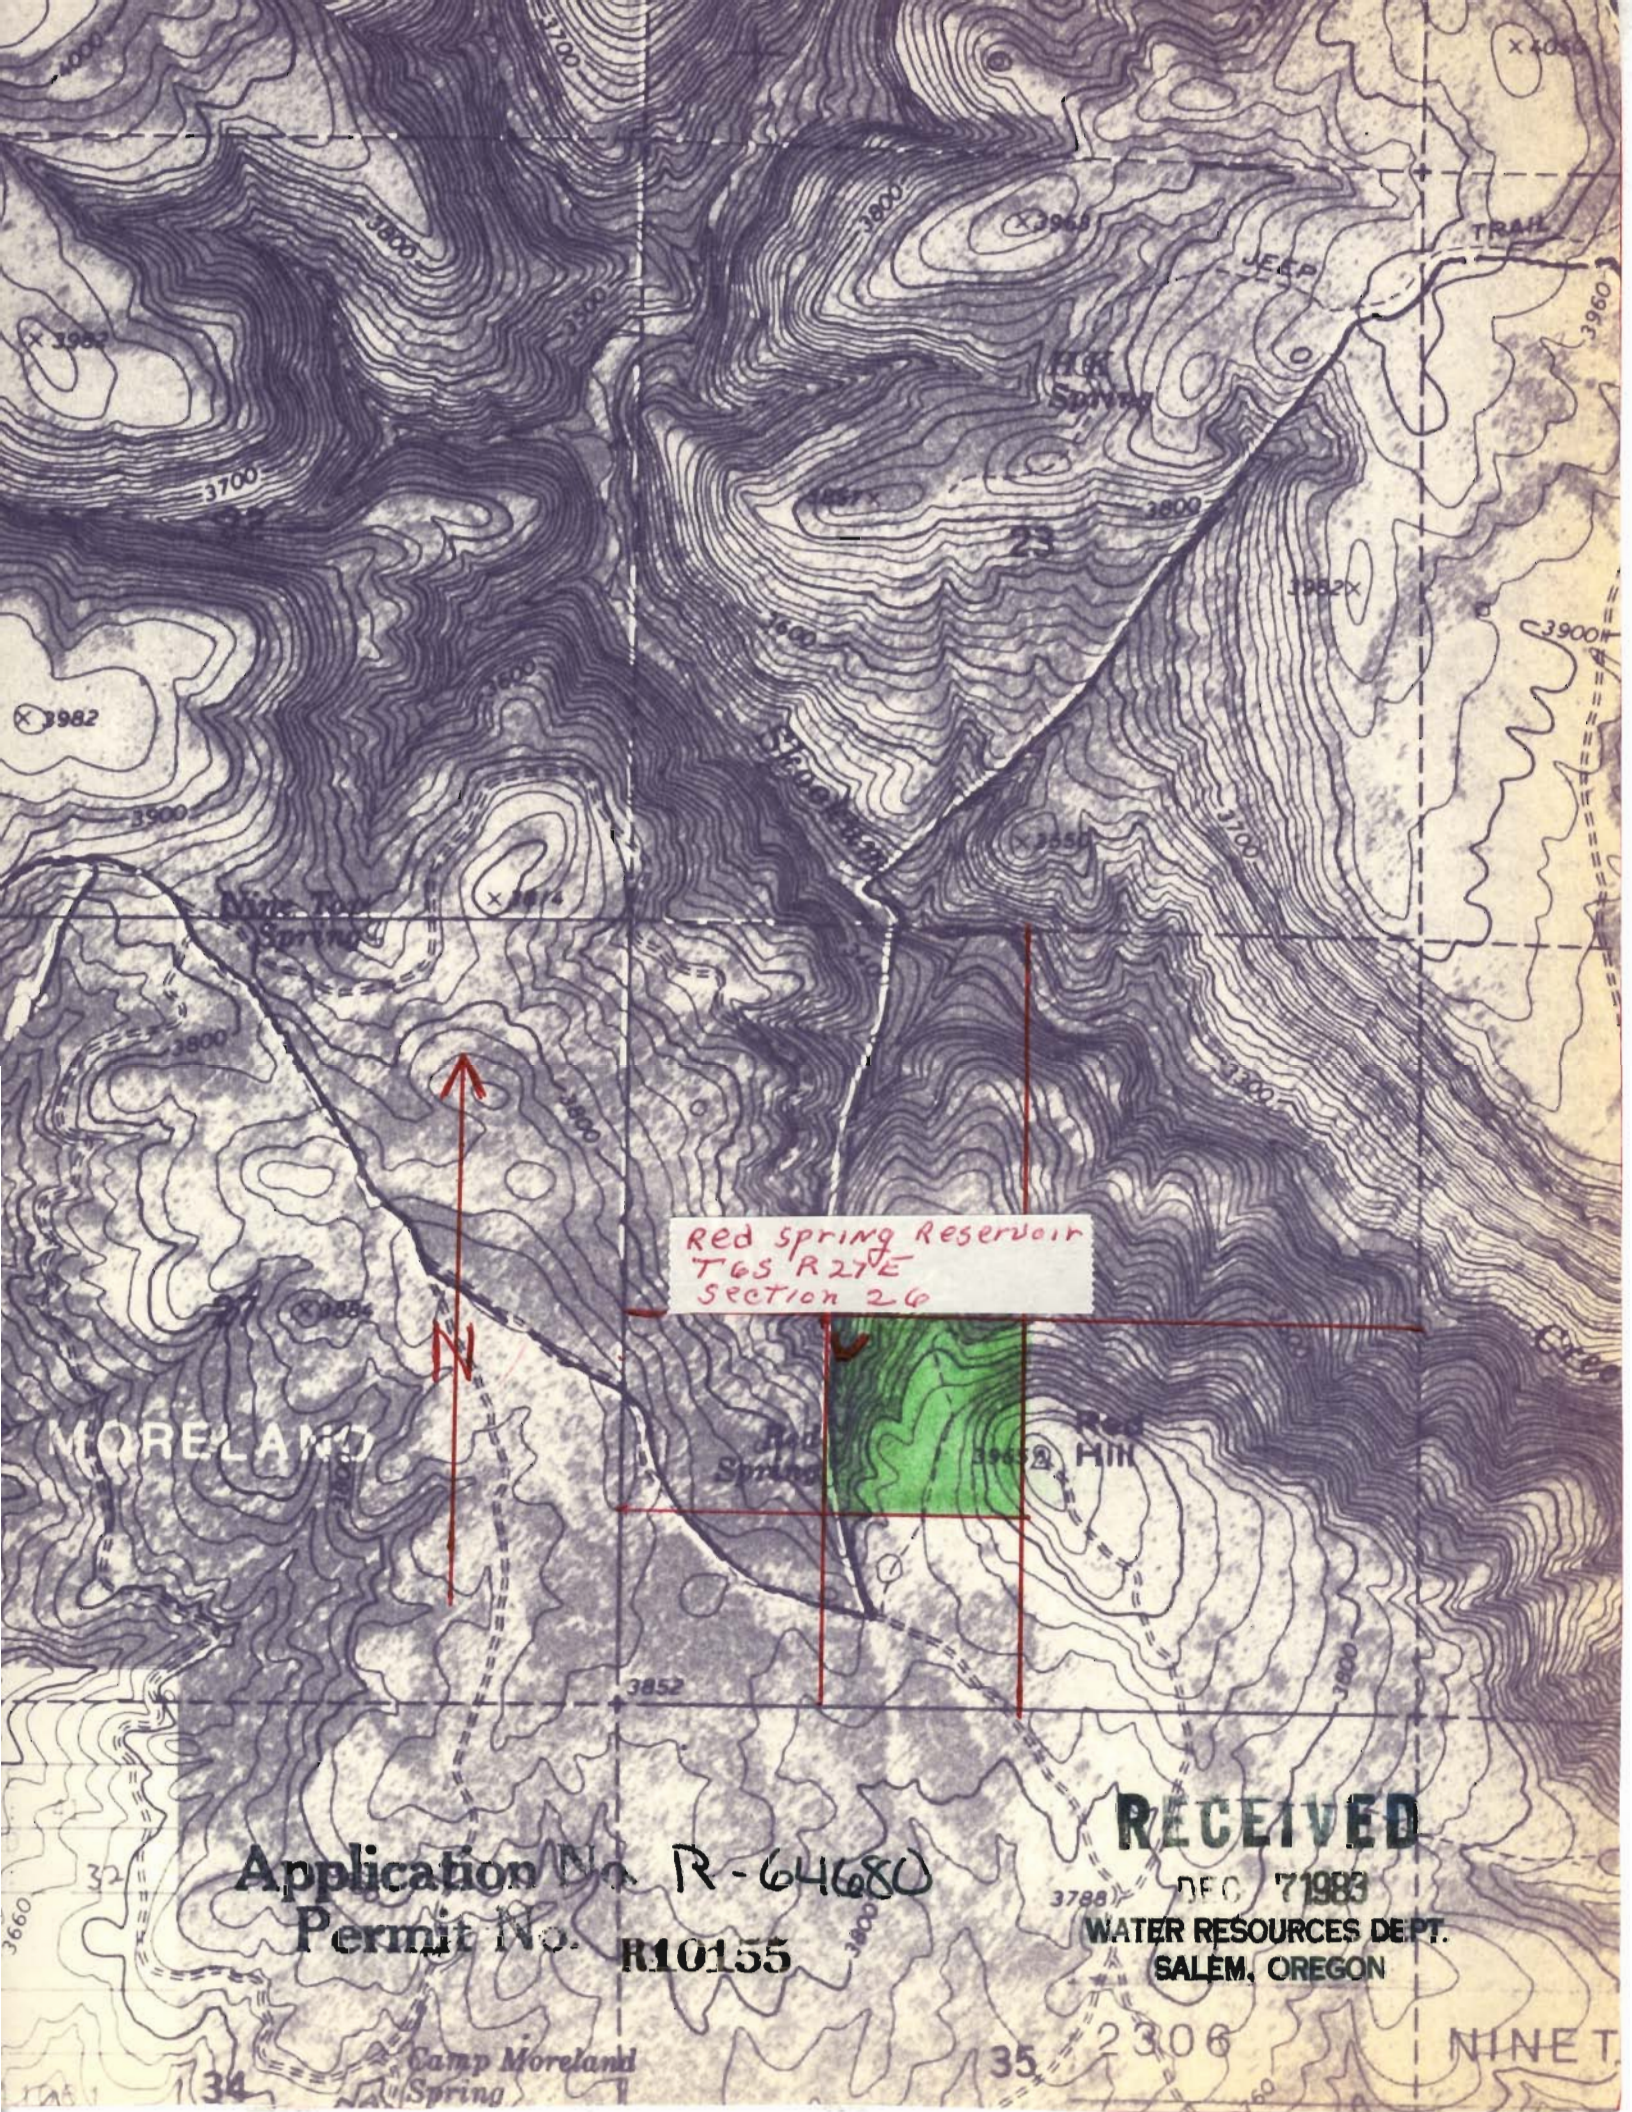

Red Spring Reservoir
TGS R27E
SECTION 26

MORELAND

RECEIVED

Application No. R-64680
Permit No. R10155

DEC 7 1983
WATER RESOURCES DEPT.
SALEM, OREGON

Camp Moreland
Spring

2306


NINE T

Application No. R-64600
Permit No. R10155

T. 5 S.

T. 6 S.

T. 7 S.

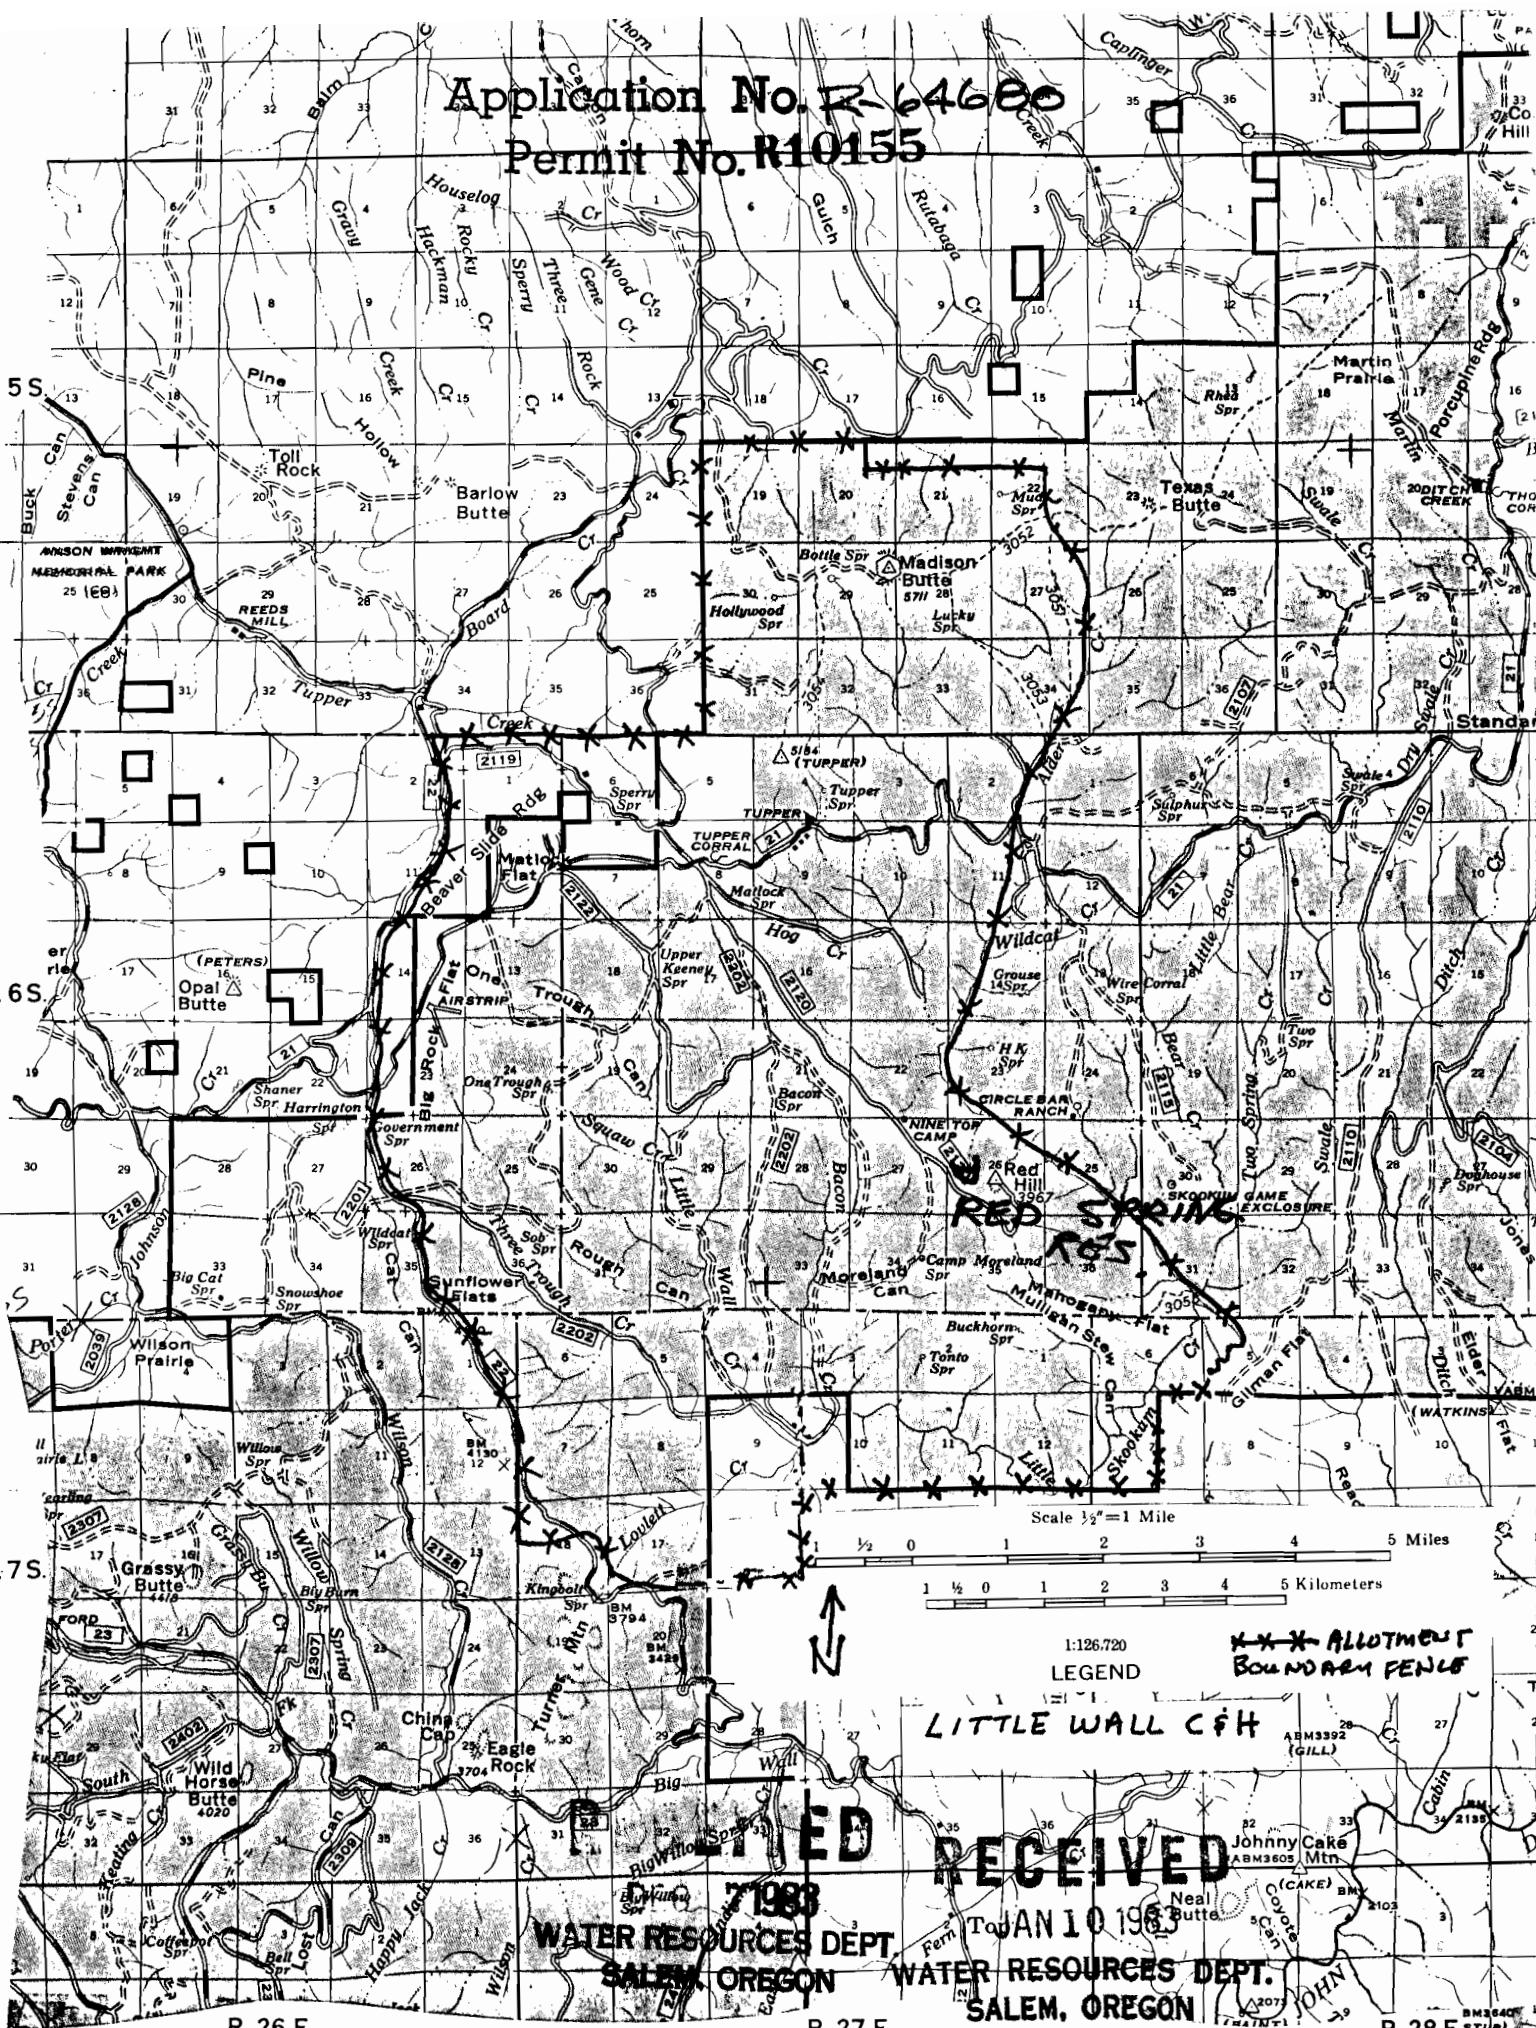

Scale 1/2" = 1 Mile

1 1/2 0 1 2 3 4 5 Miles

1:126,720

LEGEND

*** ALLOTMENT
BOUNDARY FENCE

LITTLE WALL C&H

RECEIVED



WATER RESOURCES DEPT.
SALEM, OREGON

WATER RESOURCES DEPT.
SALEM, OREGON

R. 26 E.

R. 27 E.

R. 28 E.

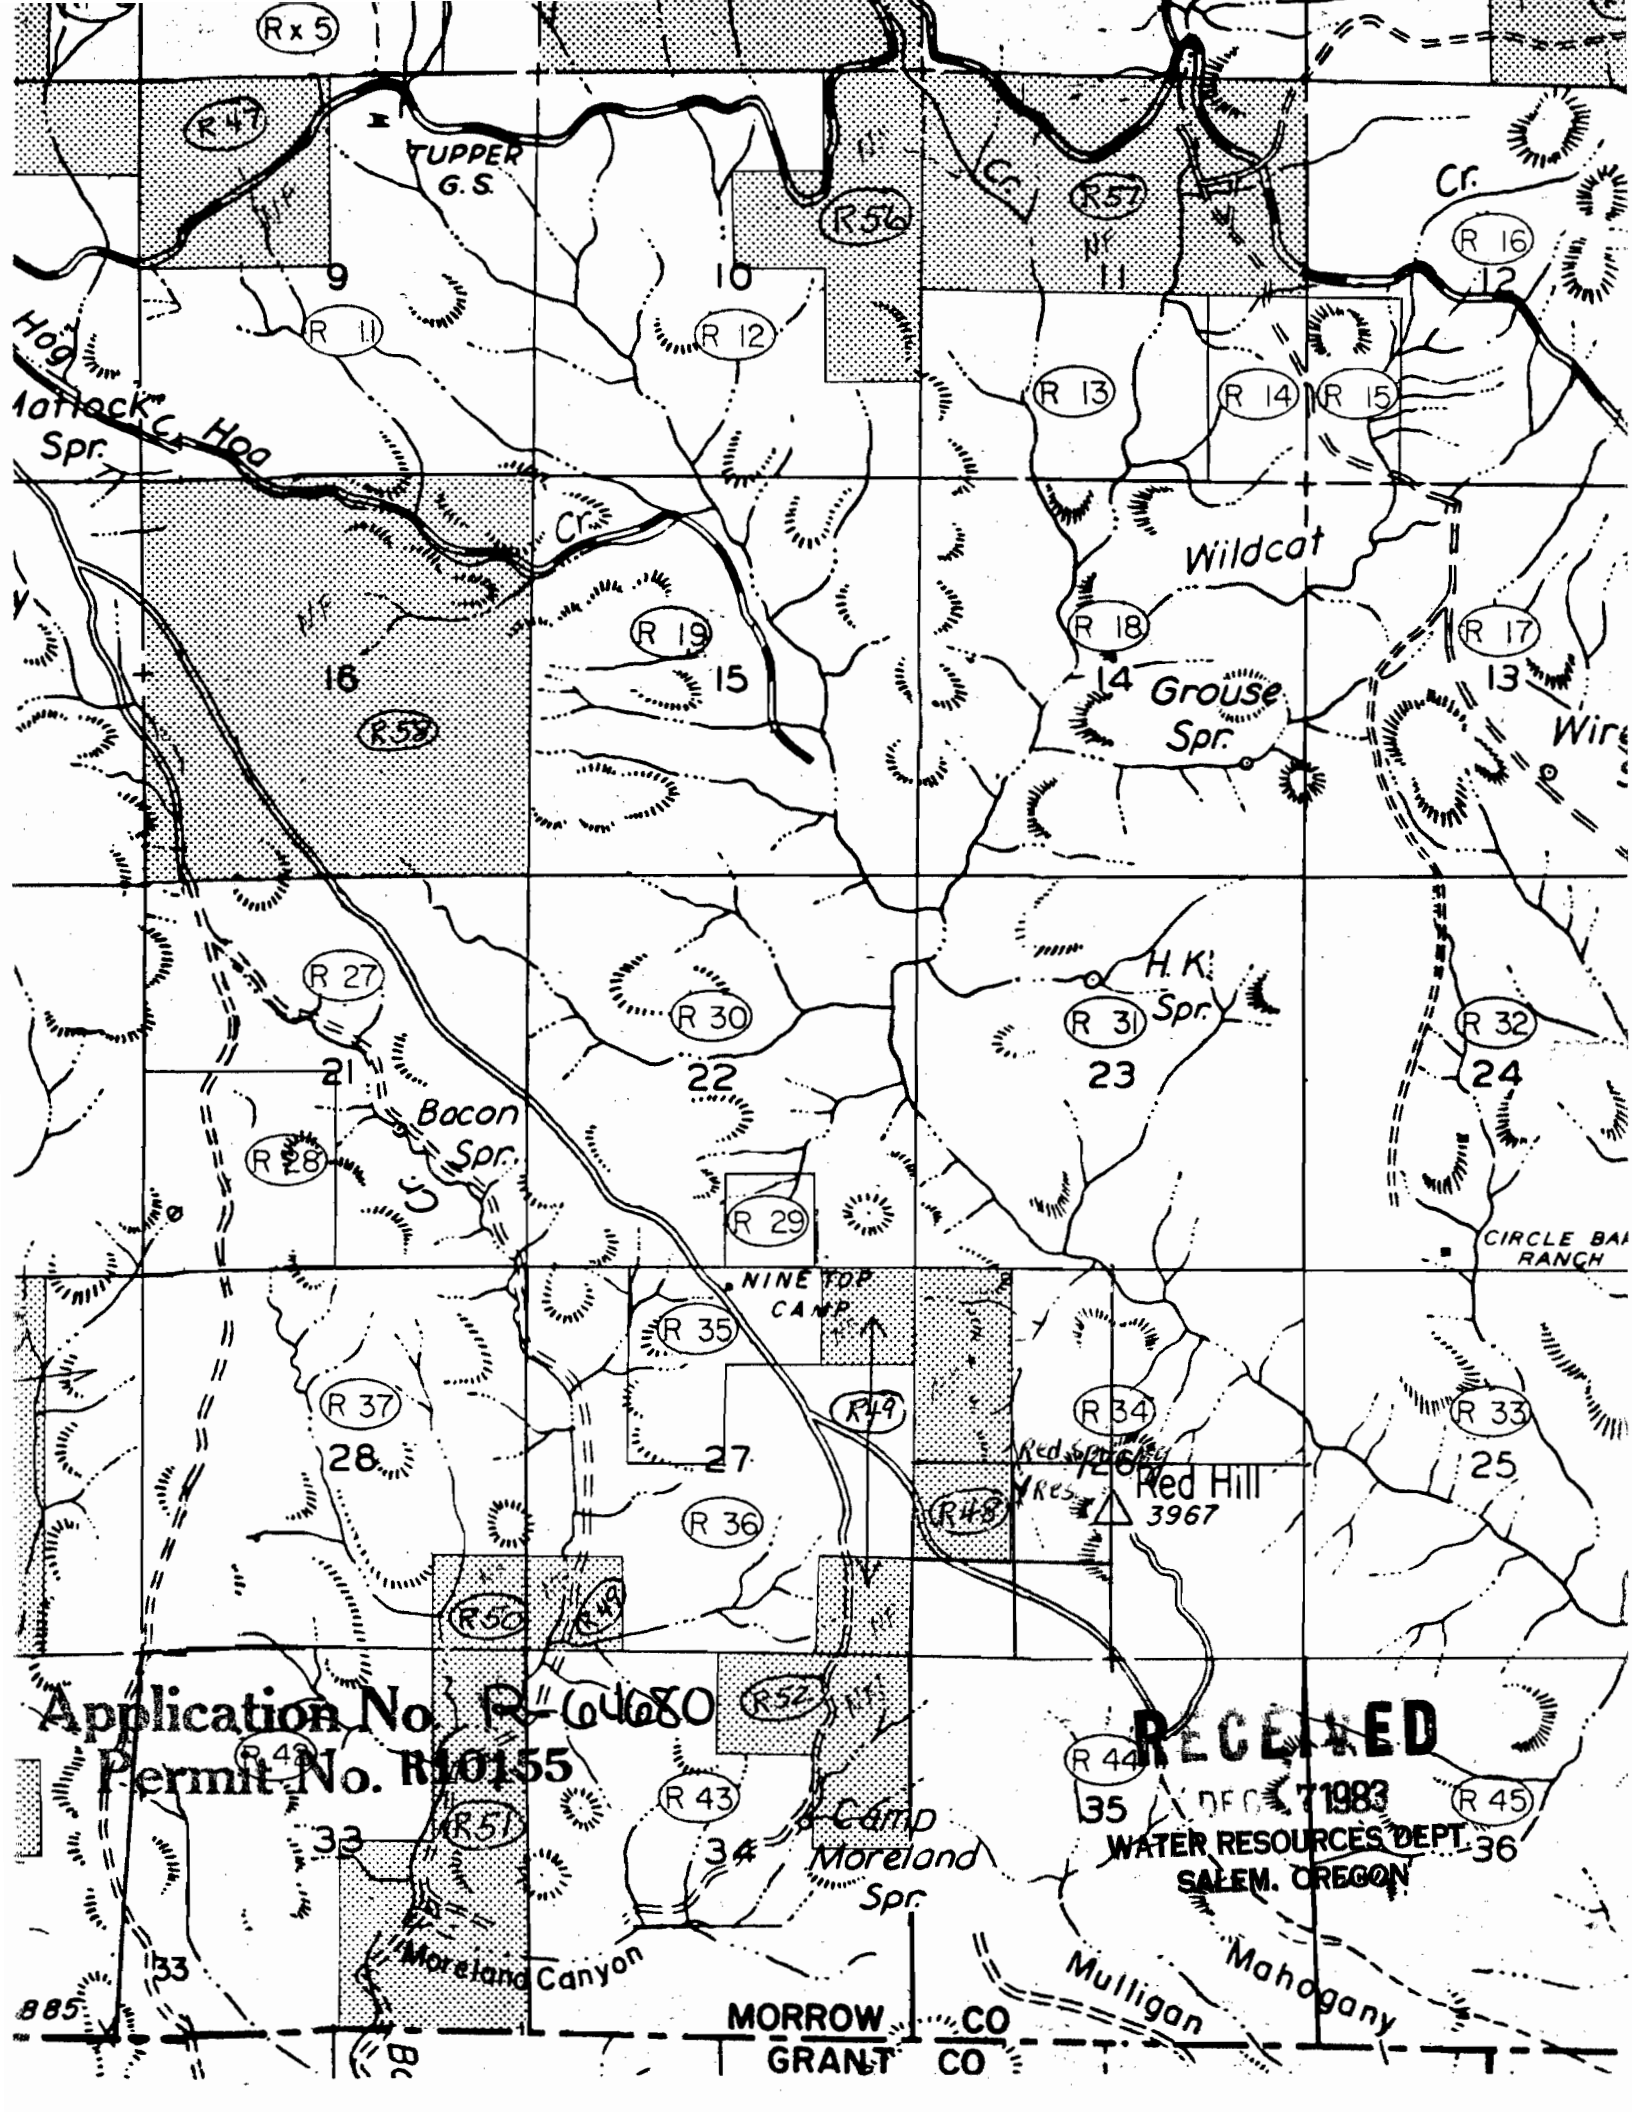

Application No. R-64680
Permit No. R10155

RECEIVED
DEC 7 1983
WATER RESOURCES DEPT. 36
SALEM, OREGON

Application No. R-64680
Permit No. R10155

SPRIT OF '76 ROAD

RIGHT MAHOGANY RES.

Mahogany


SHEPHERD STEW RES.

NATIONAL


RECEIVED

WATER RESOURCES DEPT.
SALEM, OREGON

WATER RESOURCES DEPT.
SALEM, OREGON

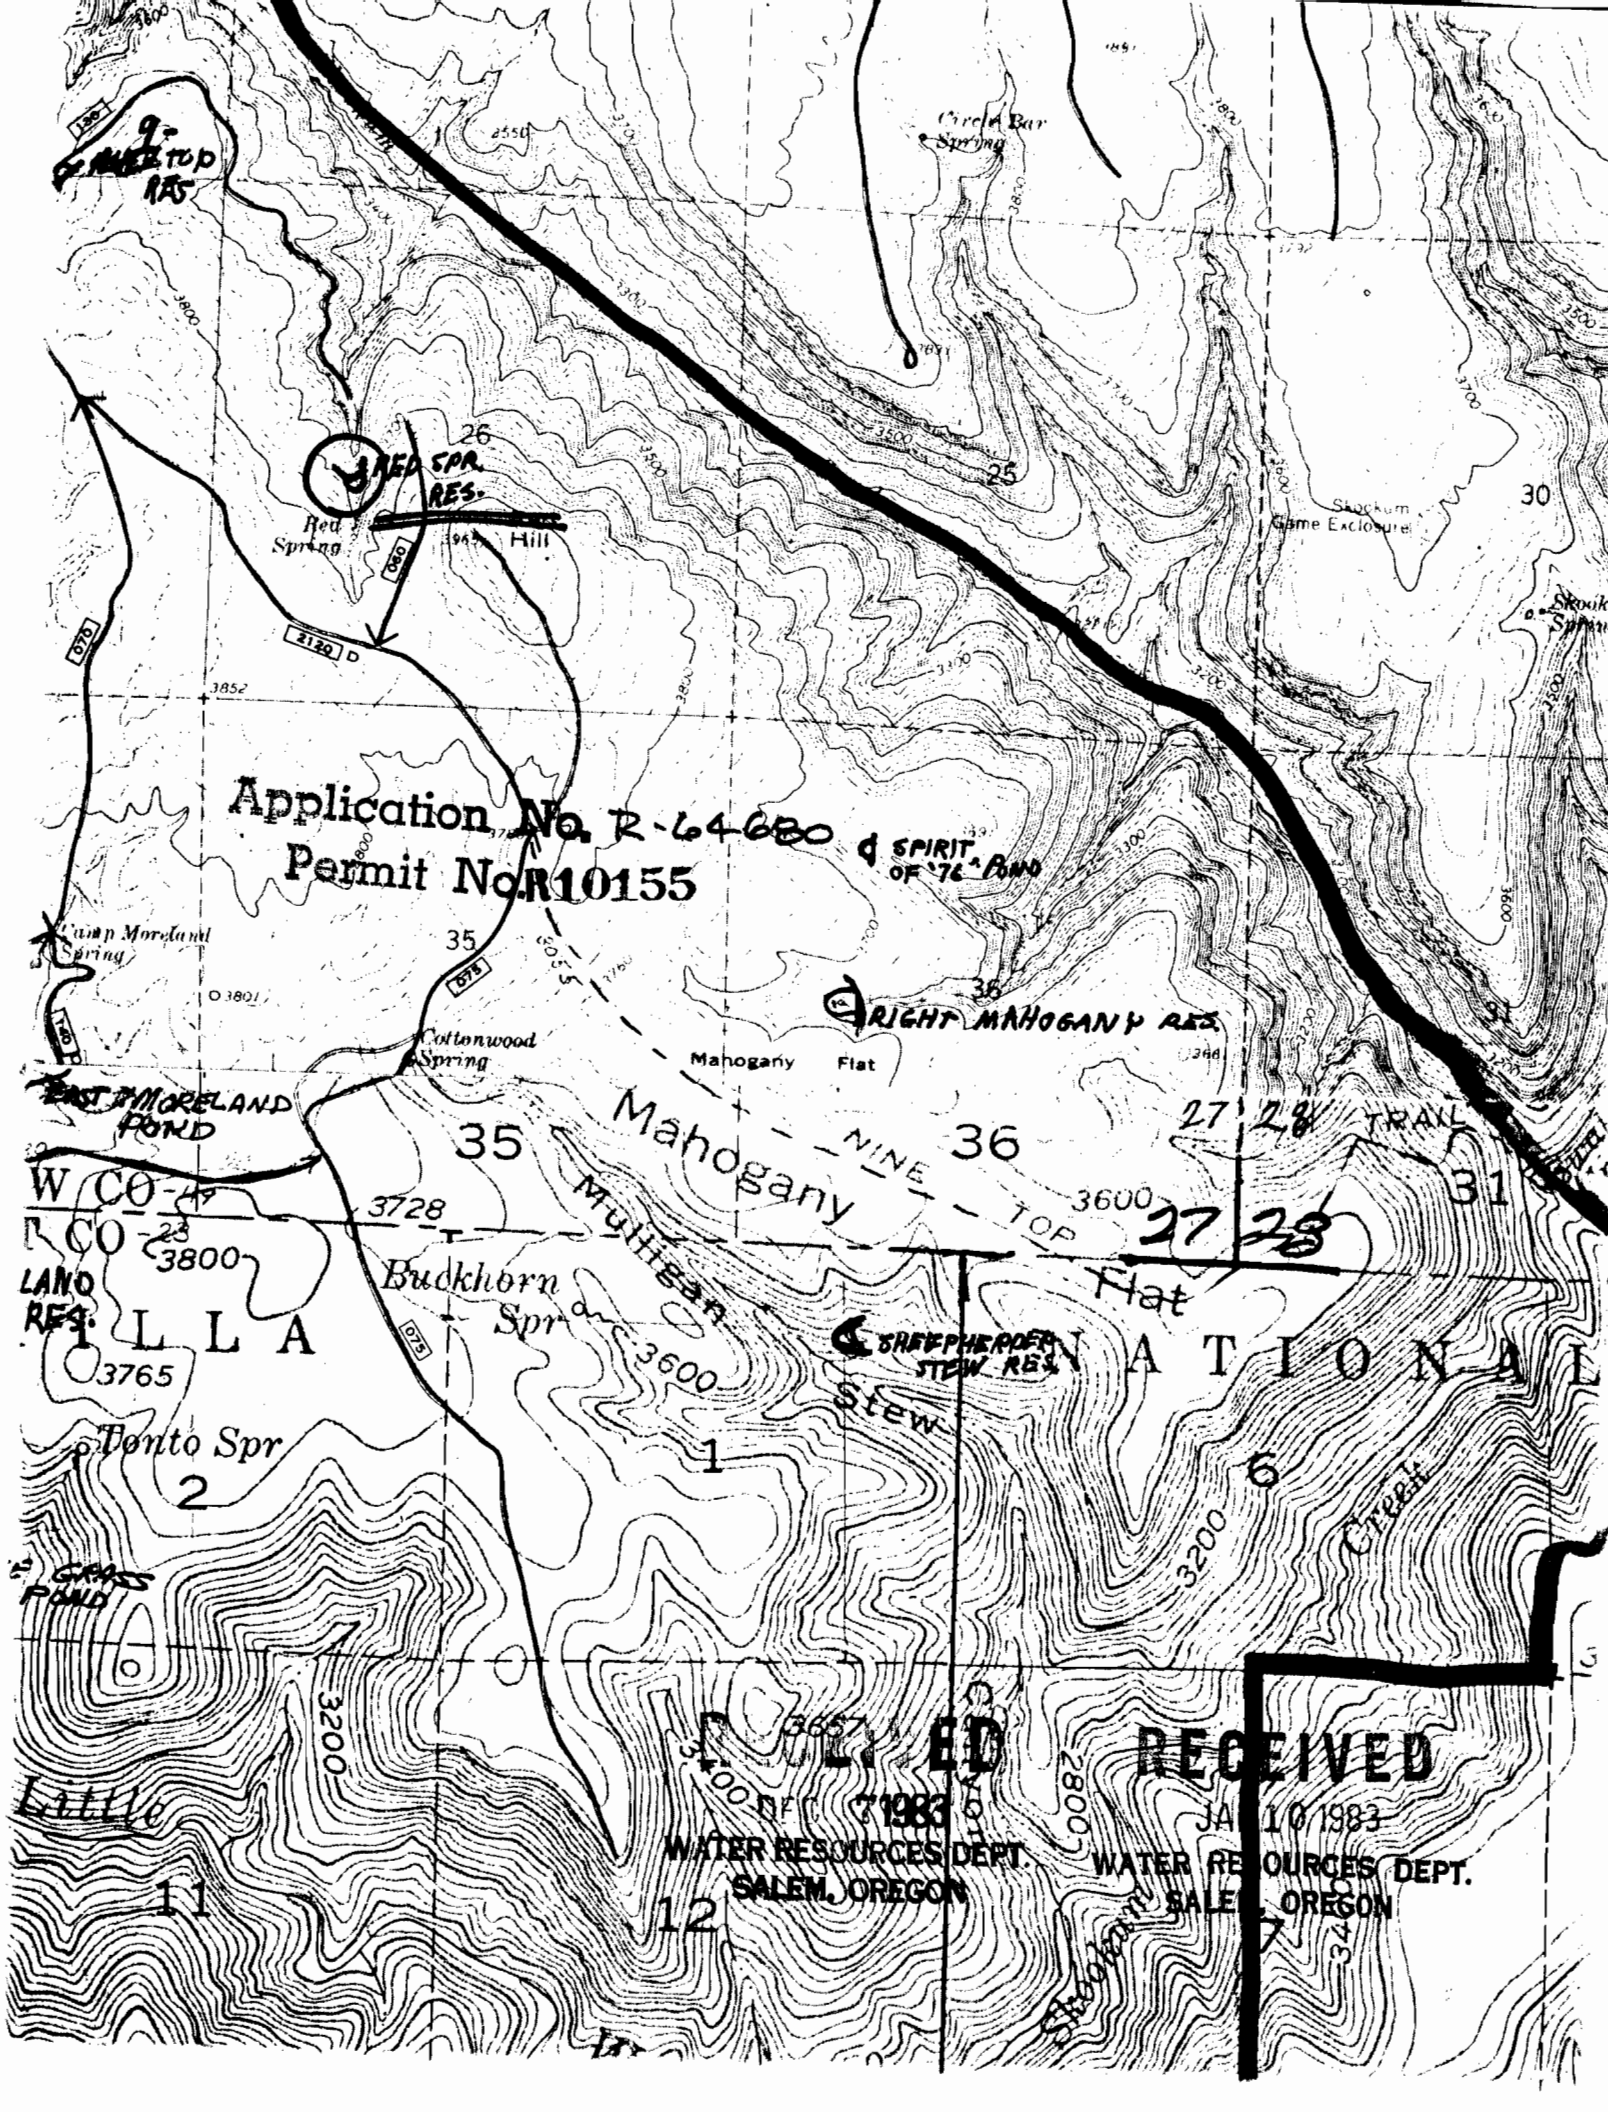

TOWNSHIP 65, RANGE 27E, SECTION 26, W.M.

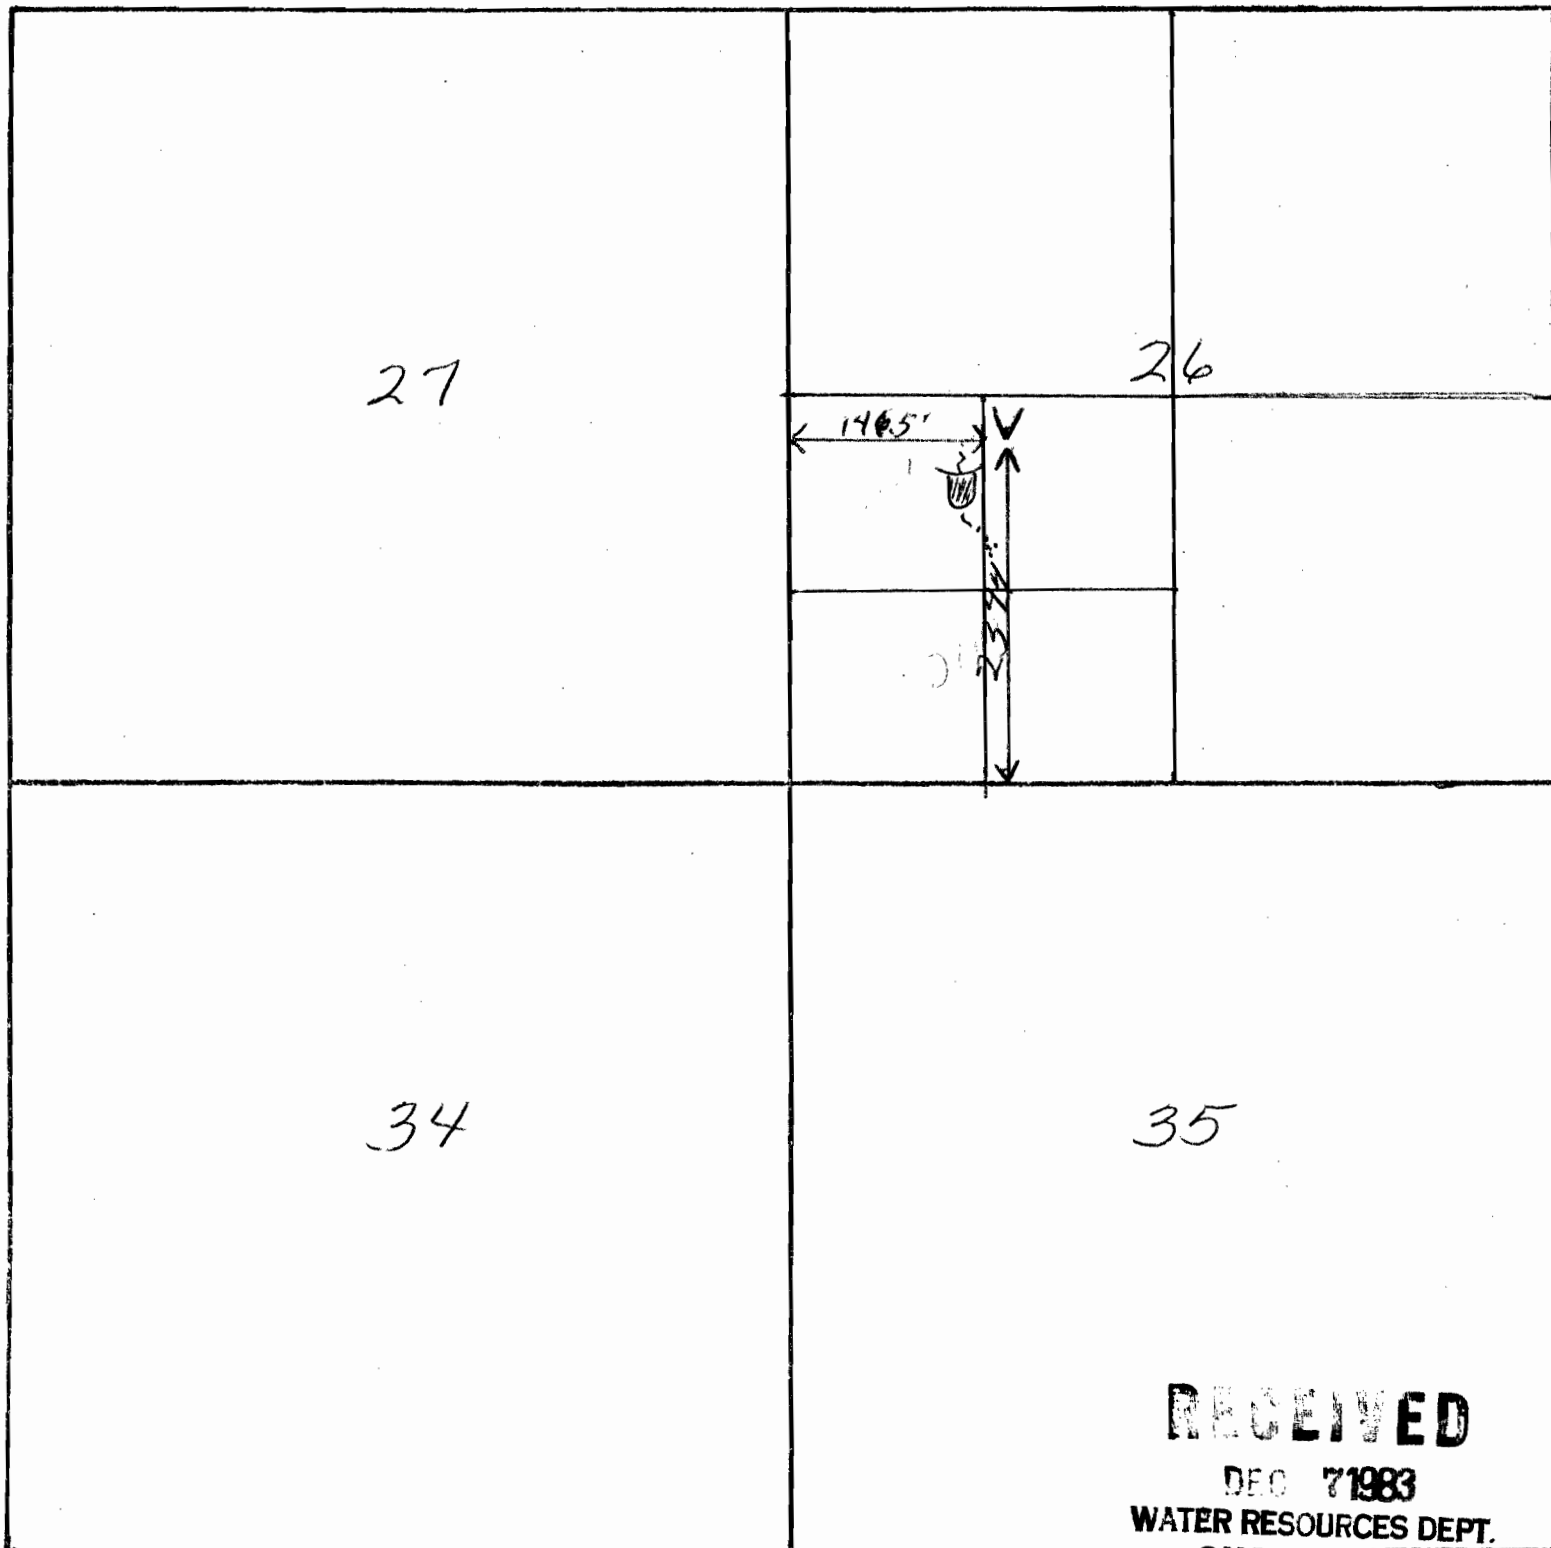

RECEIVED
DEC 7 1983
WATER RESOURCES DEPT.
SALEM, OREGON

NAME RED SPR. RES.

COUNTY MORROW

RECEIVED

Application No. R-64680

Permit No.

12

JAN 10 1983
WATER RESOURCES DEPT.
SALEM, OREGON