


010000

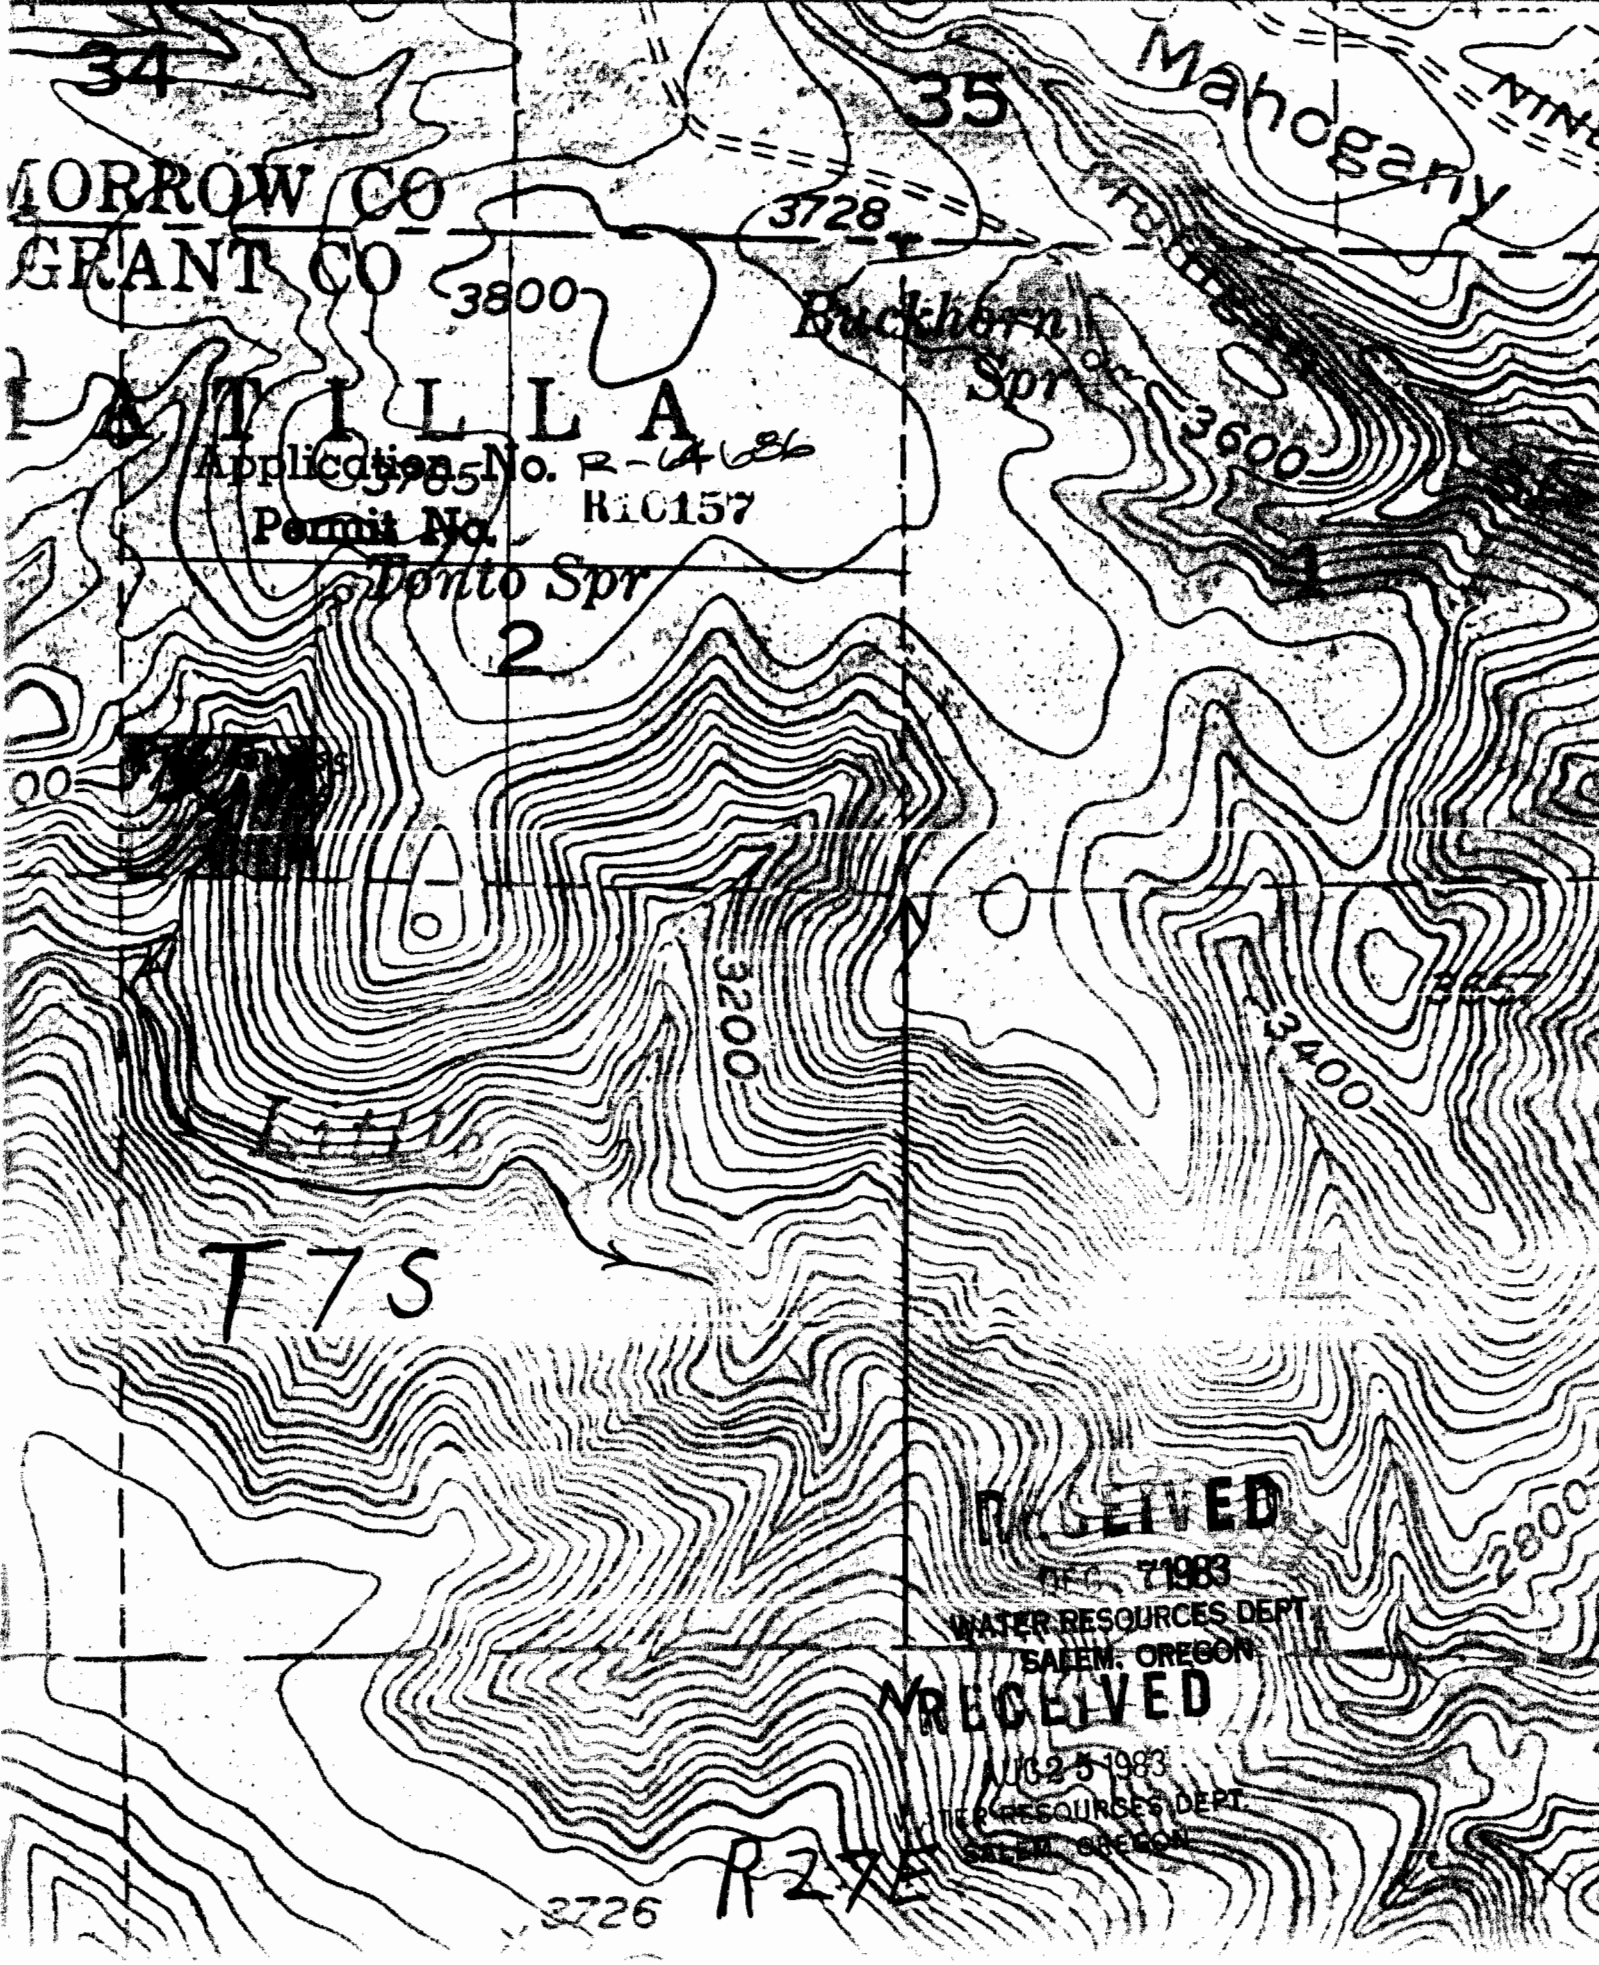

MORROW CO
GRANT CO

L A T I L L A

Application No. R-4686
Permit No. R10157

Tonto Spr

Buckhorn Spr

Mahogany

T7S

RECEIVED

DEC 7 1983

WATER RESOURCES DEPT
SALEM, OREGON

RECEIVED

AUG 25 1983

WATER RESOURCES DEPT
SALEM, OREGON


R27E

3726

TOWNSHIP 75, RANGE 27E, SECTION 2, W.M.

3

2

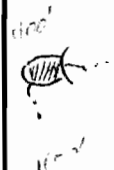

11

12

RECEIVED

DEC 7 1983

WATER RESOURCES DEPT.

SALEM, OREGON

RECEIVED

JAN 10 1983

WATER RESOURCES DEPT.
SALEM, OREGON

NAME RYE GRASS PD.

RECEIVED

AUG 25 1983

18 WATER RESOURCES DEPT.
SALEM, OREGON

Application No. R-64686

Permit No. R10157

Application No. R-64000
Permit No. B10157

T.5S
T.6S
T.7S

R.26E
R.27E
R.28E

Scale 1/2" = 1 Mile
1 1/2 0 1 2 3 4 5 Miles
1 1/2 0 1 2 3 4 5 Kilometers

LEGEND
--- ALLOTMENT BOUNDARY FENCE

LITTLE WALL C&H

RECEIVED
JAN 10 1983
WATER RESOURCES DEPT.
SALEM, OREGON

RECEIVED
AUG 25 1983
WATER RESOURCES DEPT.
SALEM, OREGON

RECEIVED
JAN 10 1983
WATER RESOURCES DEPT.
SALEM, OREGON

Barlow Butte
Madison Butte
Opal Butte
Grassy Butte
Little Wall C&H

1 1/2 0 1 2 3 4 5 Kilometers

1:126.720

LEGEND

~~XXX~~ ALLOTMENT
BOUNDARY FENCE

LITTLE WALL C&H

RECEIVED

~~JAN 10 1983~~

WATER RESOURCES DEPT.
SALEM, OREGON

W


RECEIVED

AUG 25 1983

WATER RESOURCES DEPT
SALEM, OREGON

WATER RESOURCES DEPT
SALEM, OREGON 97301

R. 28 E

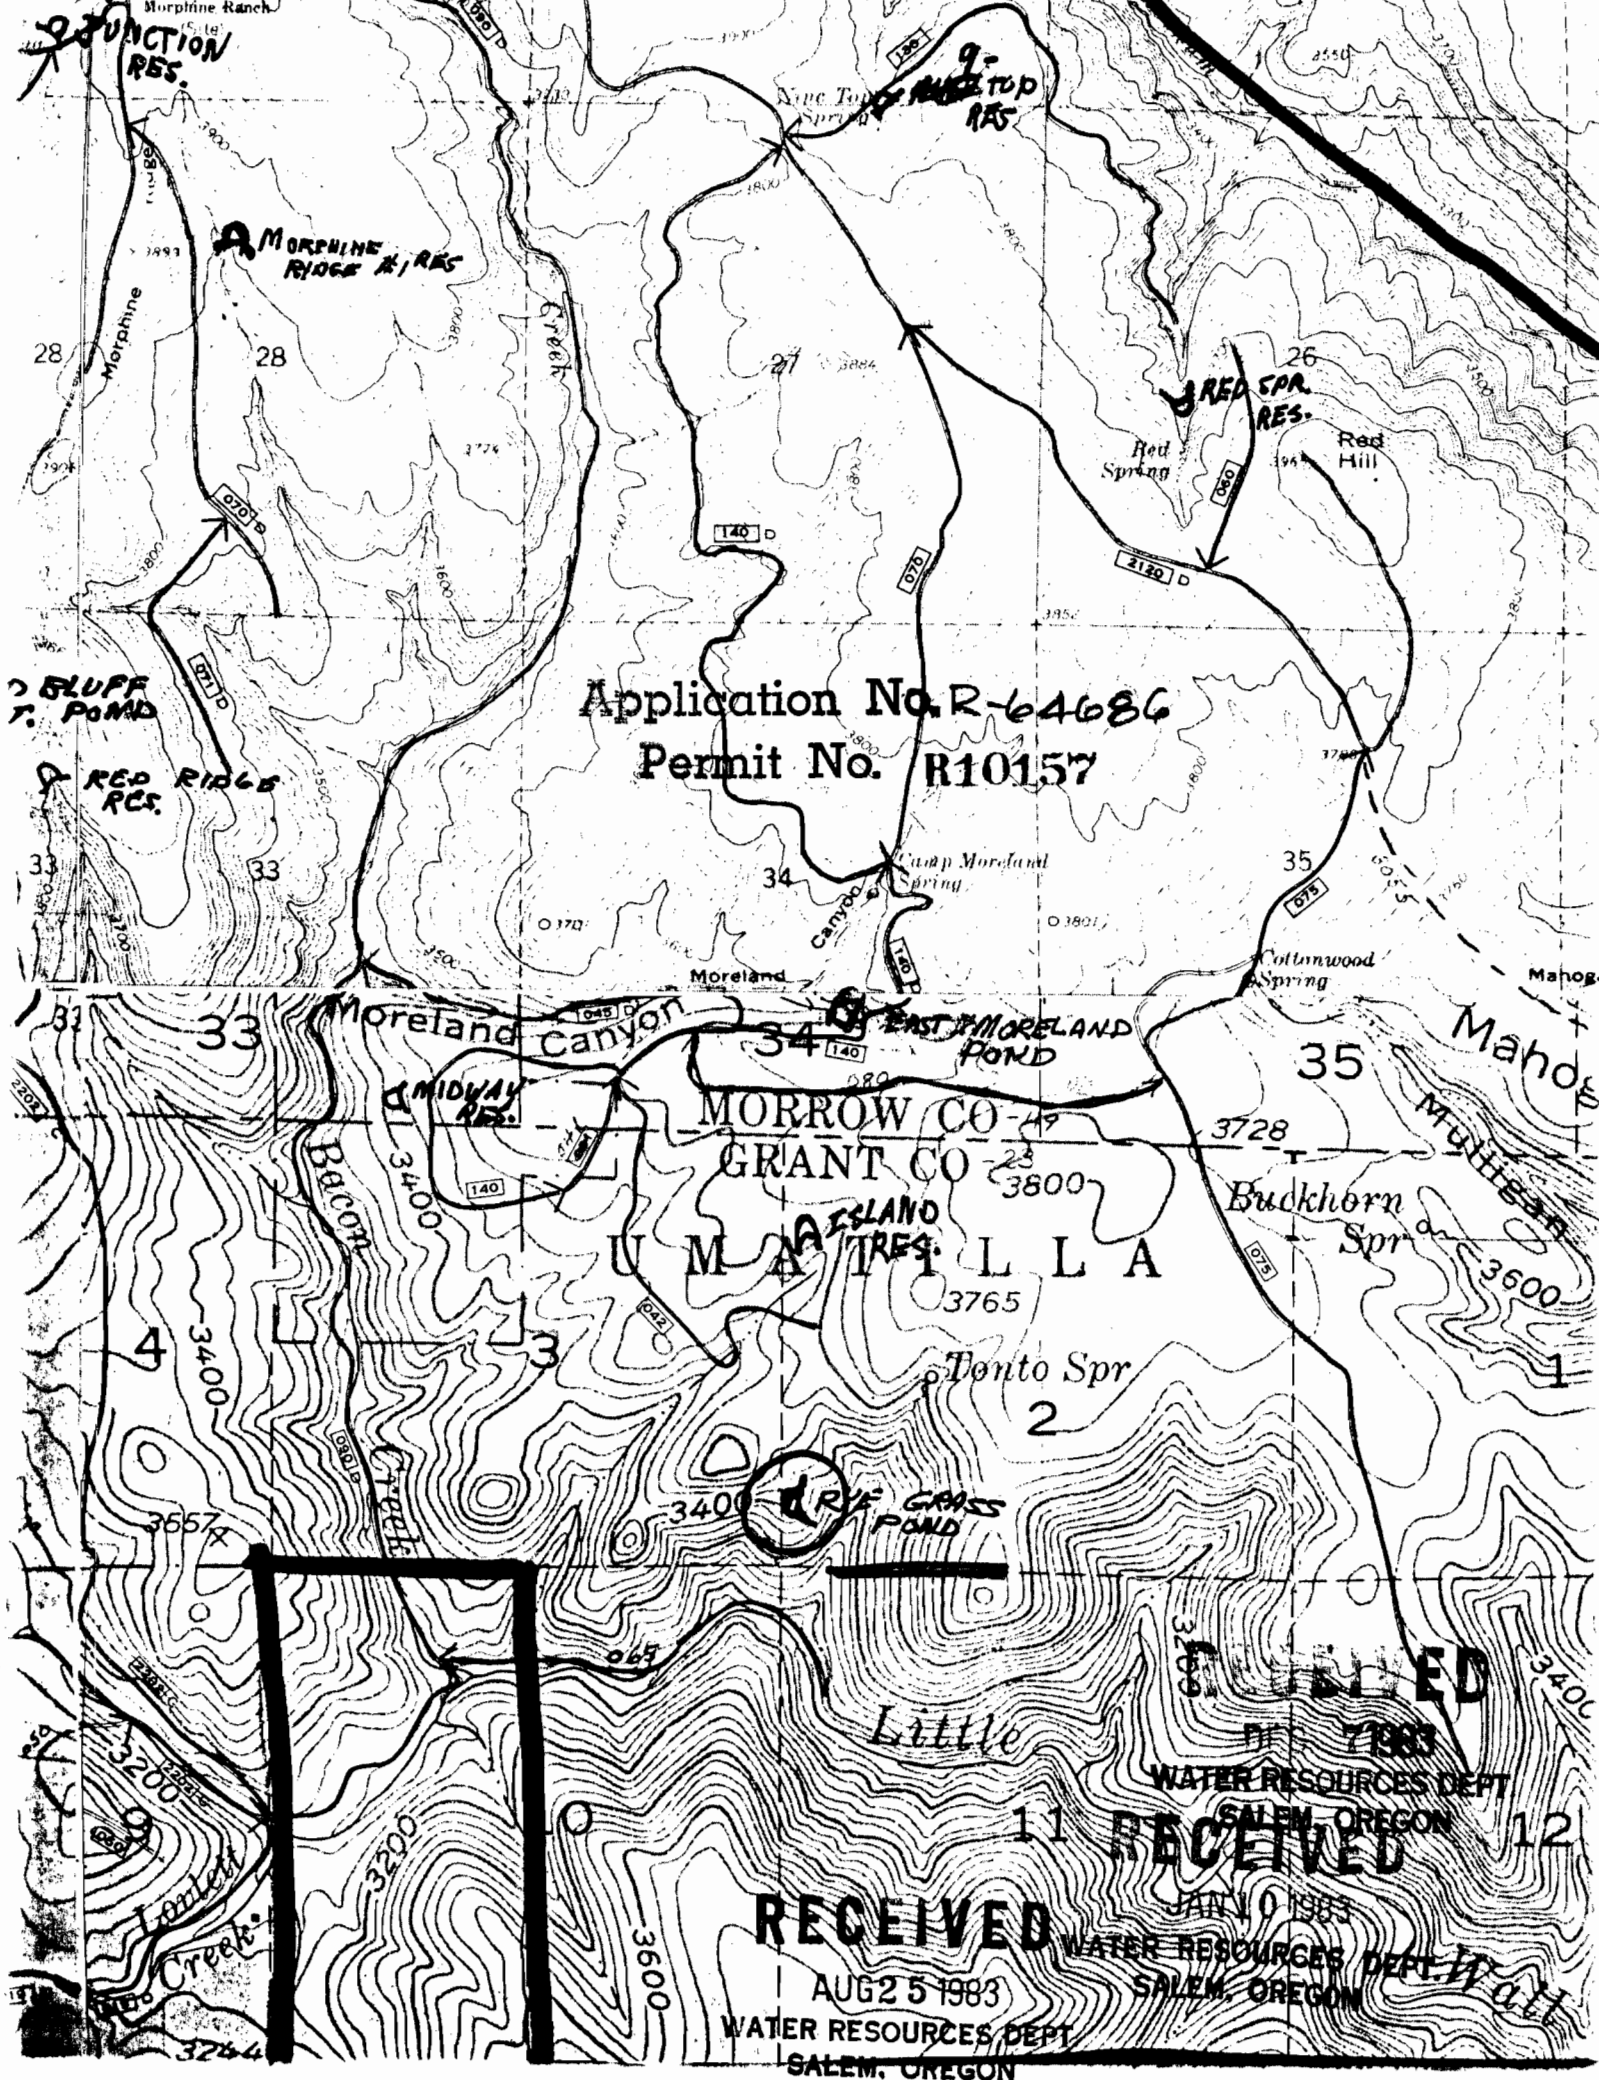

Application No. R-64686
Permit No. R10157

MORROW CO - 49
GRANT CO - 23
3765

RECEIVED

AUG 25 1983
WATER RESOURCES DEPT
SALEM, OREGON

RECEIVED

JAN 10 1983
WATER RESOURCES DEPT
SALEM, OREGON

RECEIVED

JAN 10 1983
WATER RESOURCES DEPT
SALEM, OREGON