

Bologna
Spr

4581

24

4412

19

04412

4000

LOT
1

West Dry creek Reservoir
T.8S R.27E section 30

25

N

3

3434

4

3899

3600

36


Application No. R-64691

Permit No. R10158

RECEIVED

MAY 7 1983

WATER RESOURCES DEPT.
SALEM, OREGON

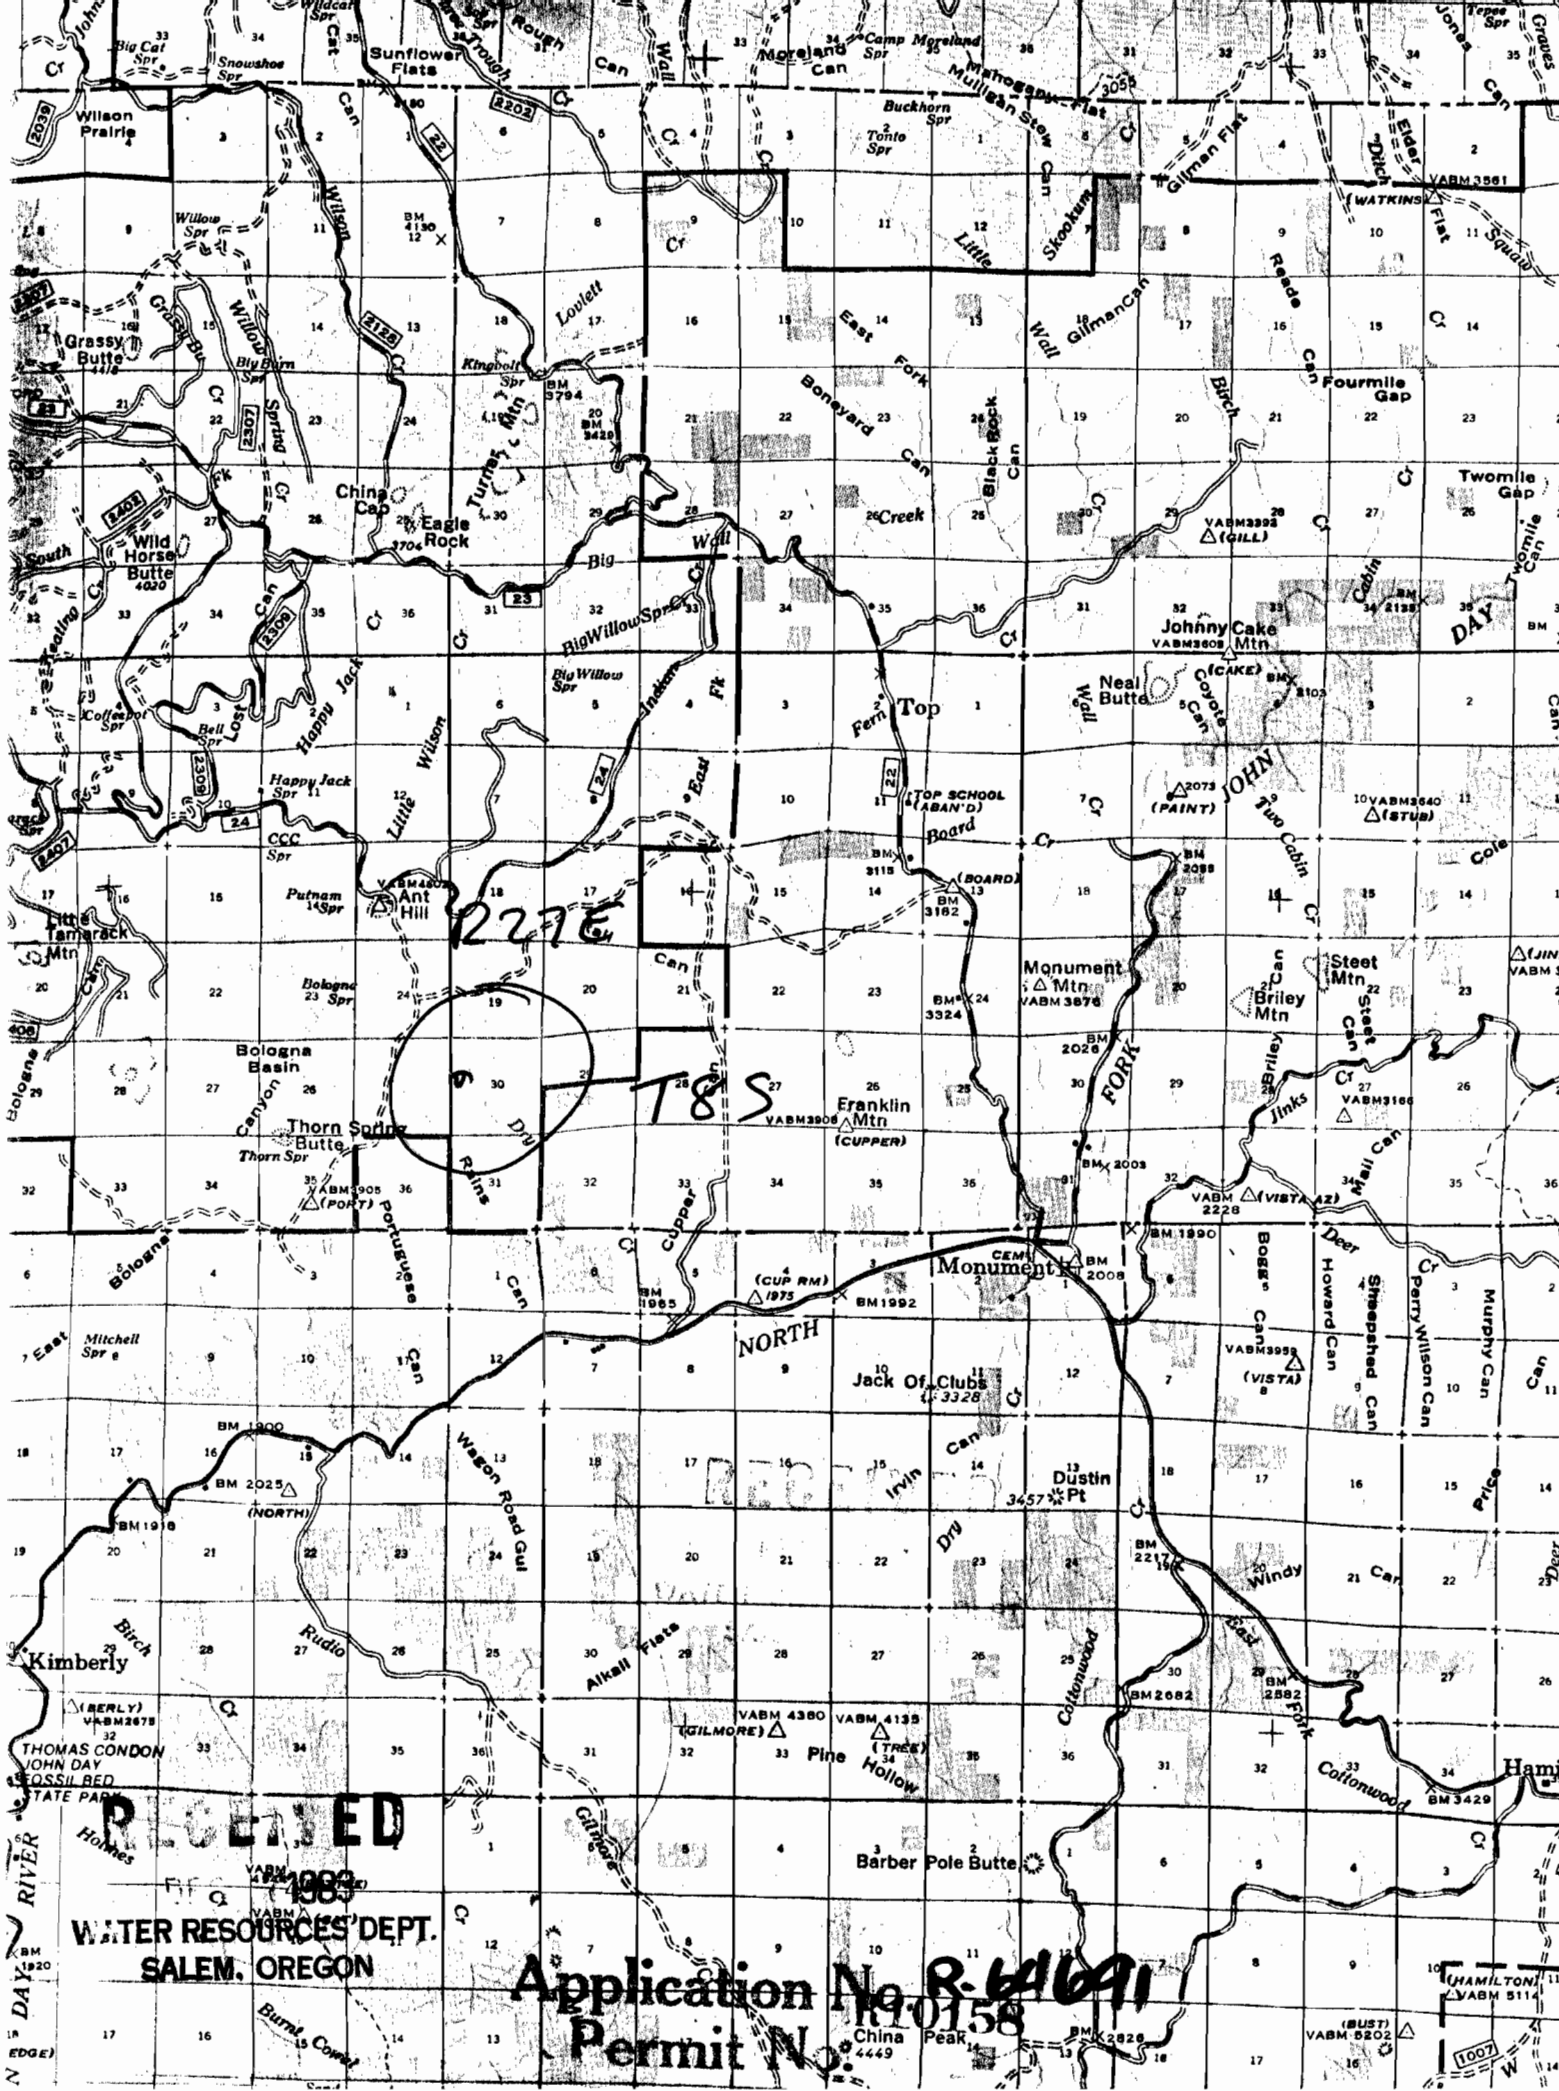

227E


T8S

NORTH

RECEIVED

WATER RESOURCES DEPT.
SALEM, OREGON

Application No. R-61691

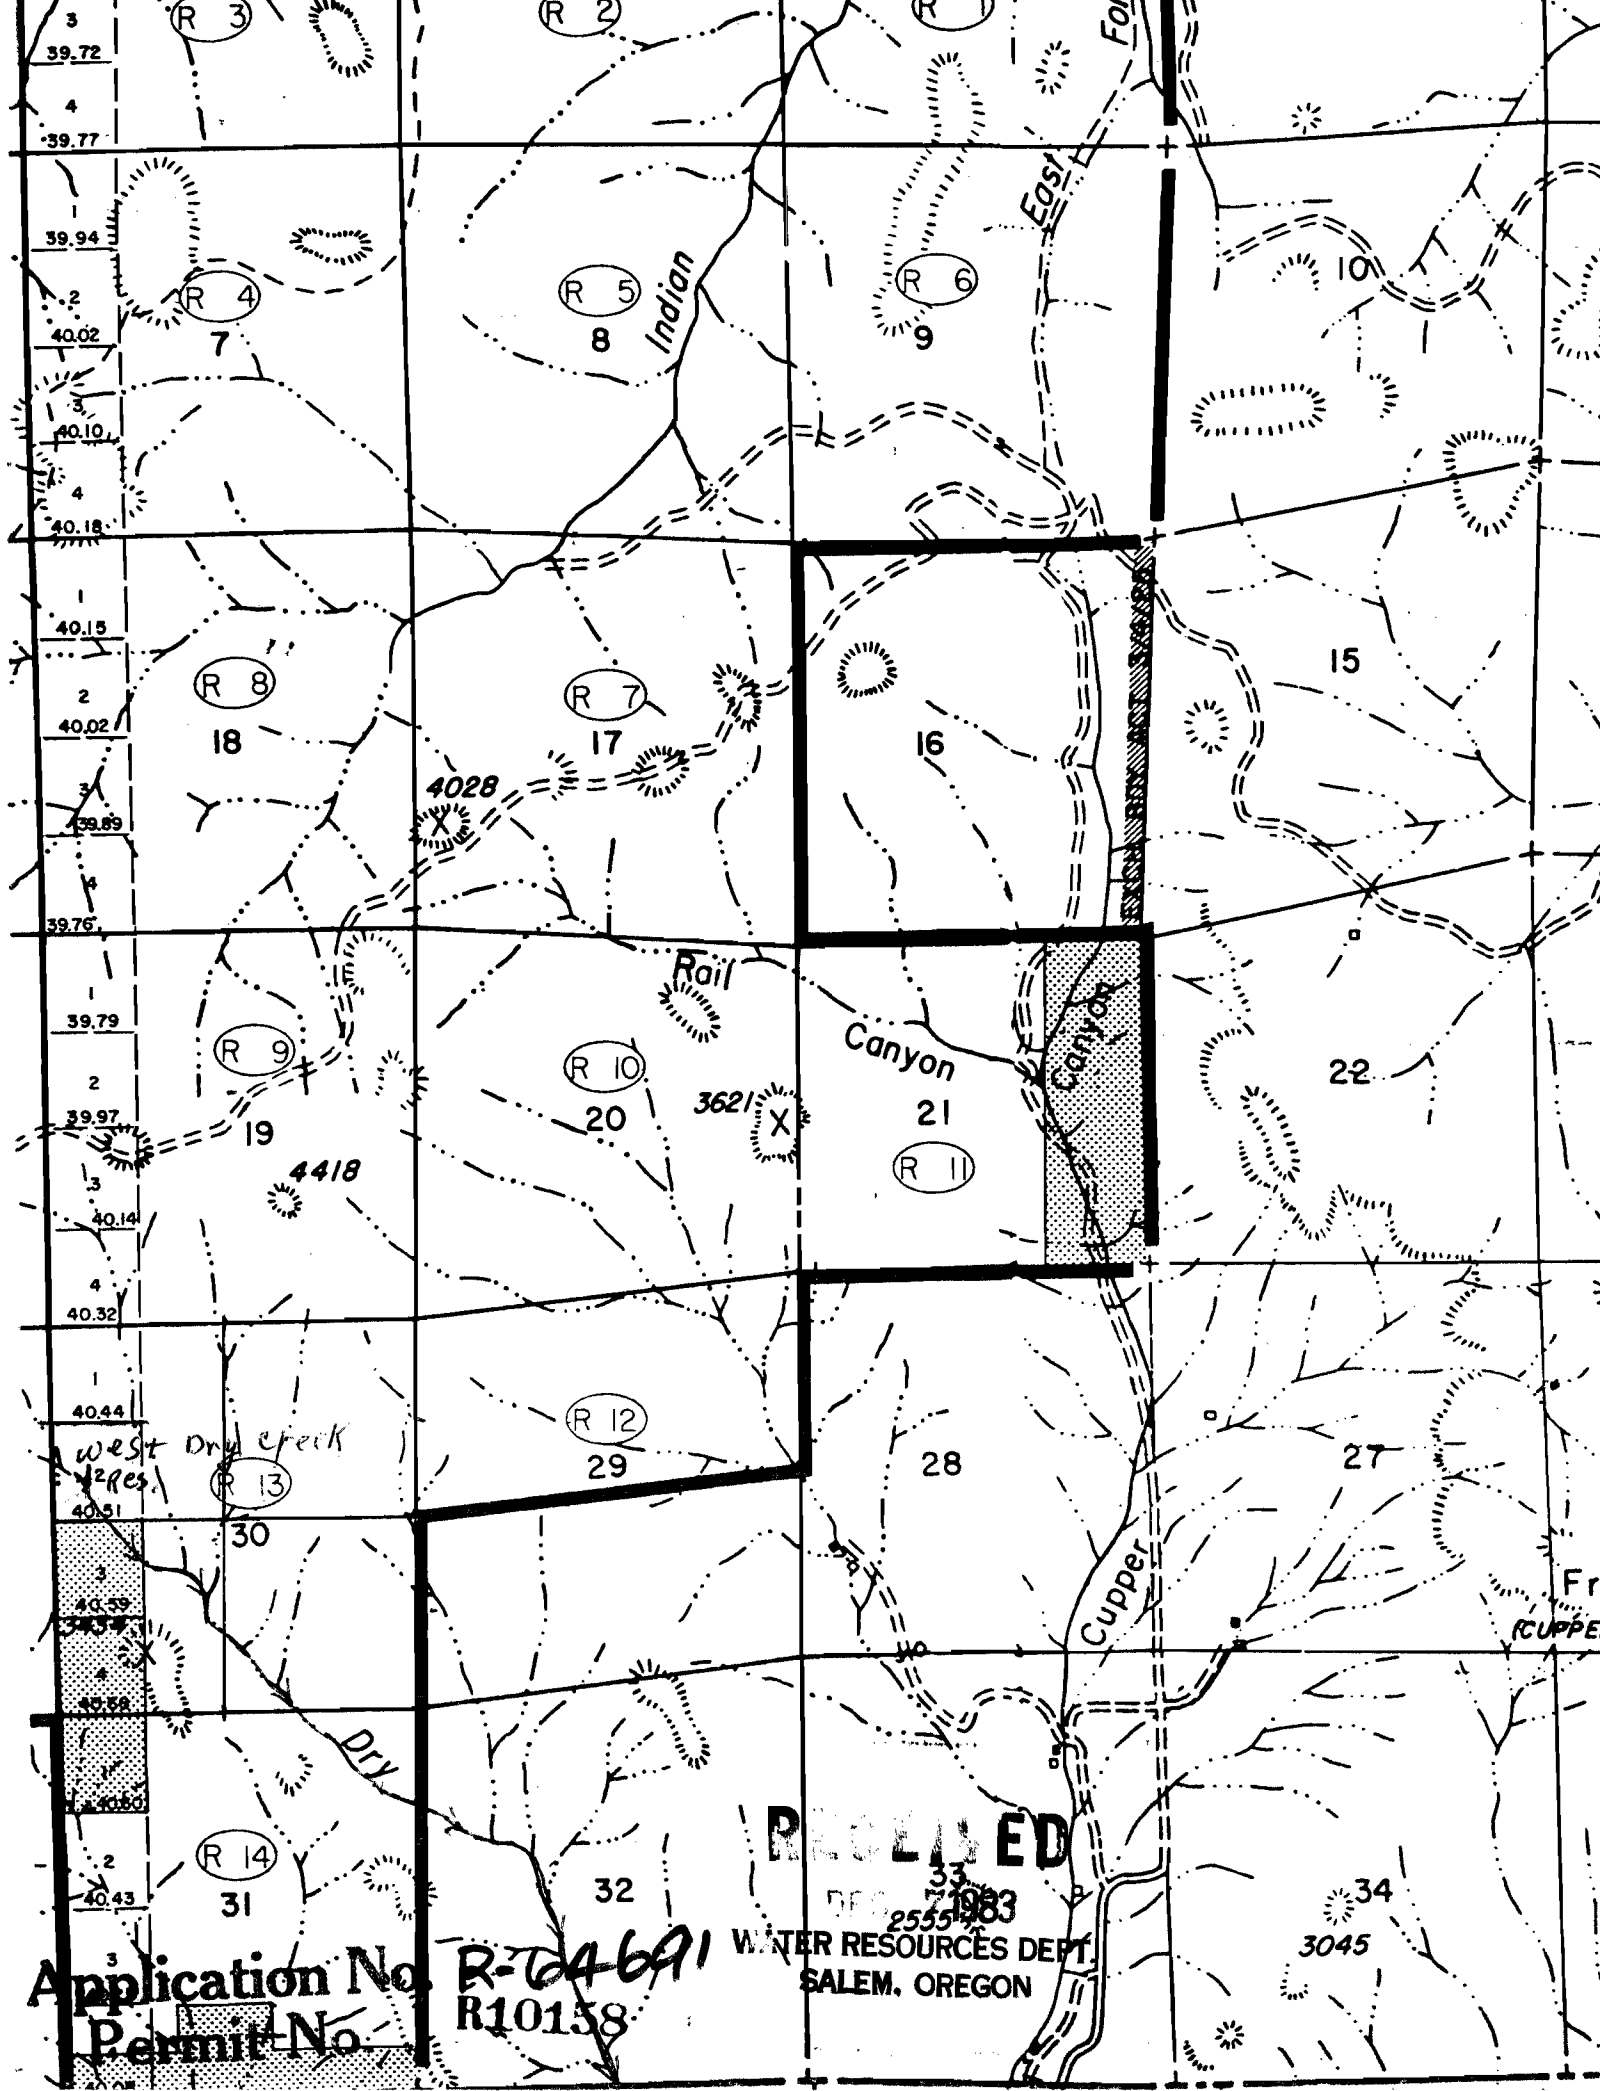

Application No. R-64691
Permit No. R10158

RECEIVED

DEC 7 1983

WATER RESOURCES DEPT.
SALEM, OREGON

TOWNSHIP

ES

RANGE

27 E

SECTION

30

W.M.

19

20

107

1

Lot 7-

—

L 17

22

L. 107

1

30

29

NAME _____

W. Dry Cr. Res

COUNTY

Grant

RECEIVED

DEC 7 1983

WATER RESOURCES DEPT.

SALEM, OREGON

Application No. **R-64691**
Permit No. **R10158**

Permit No. R10158

R10158

R **E** **C** **I** **P**


[illegible]

WATER ... DEPT
SAL ...

SA.

DEPT
100

TOWNSHIP 8S, RANGE 27 E, SECTION 30, W.M.

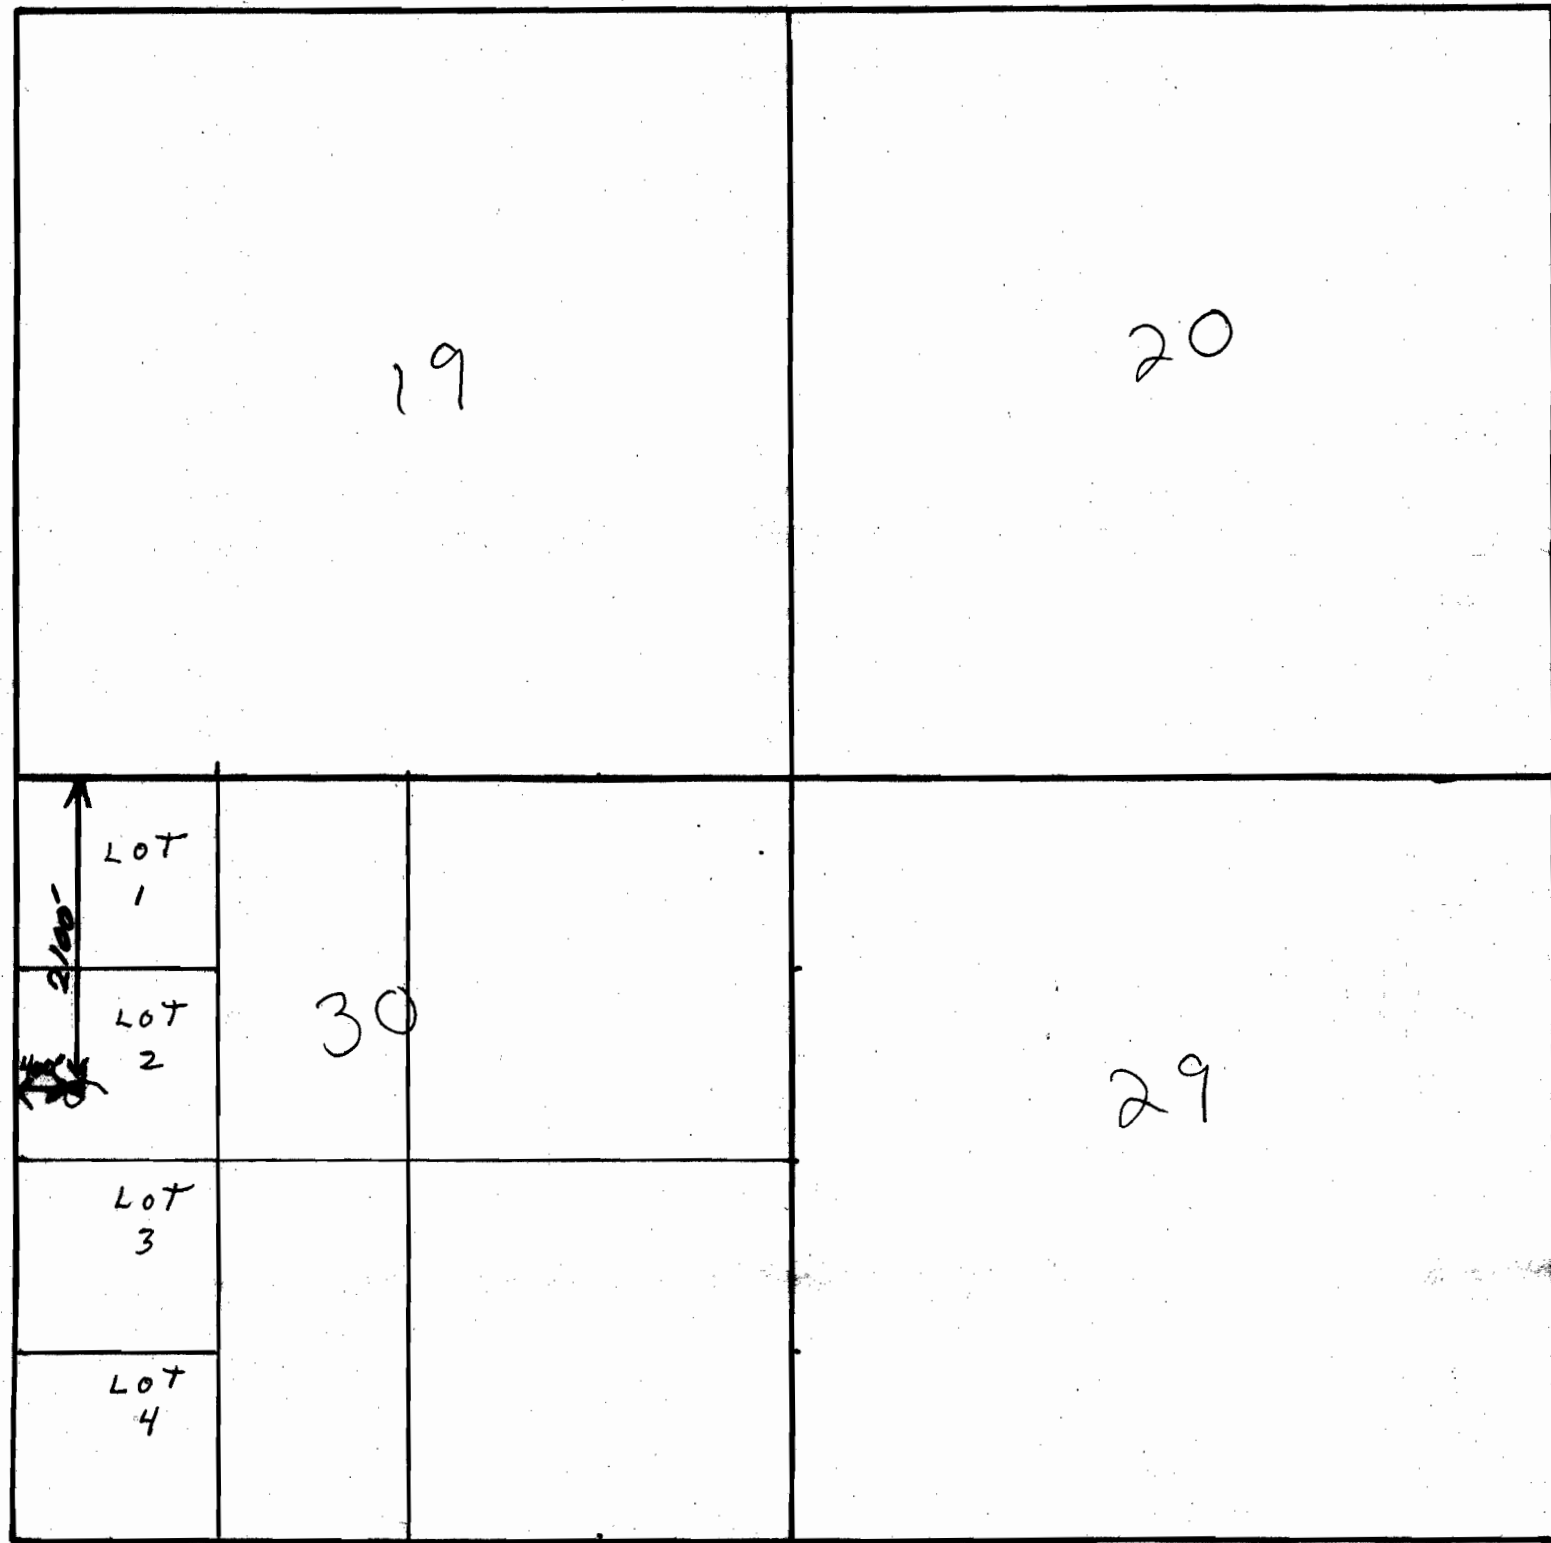

NAME W. Dry Cr. Res COUNTY Grant

RECEIVED

DEC 7 1983
WATER RESOURCES DEPT.
SALEM, OREGON

Application No. R-64691
Permit No. R10158

RECEIVED

FEB 22 1982
WATER RESOURCES DEPT
SALEM, OREGON